5-29-87 Cb

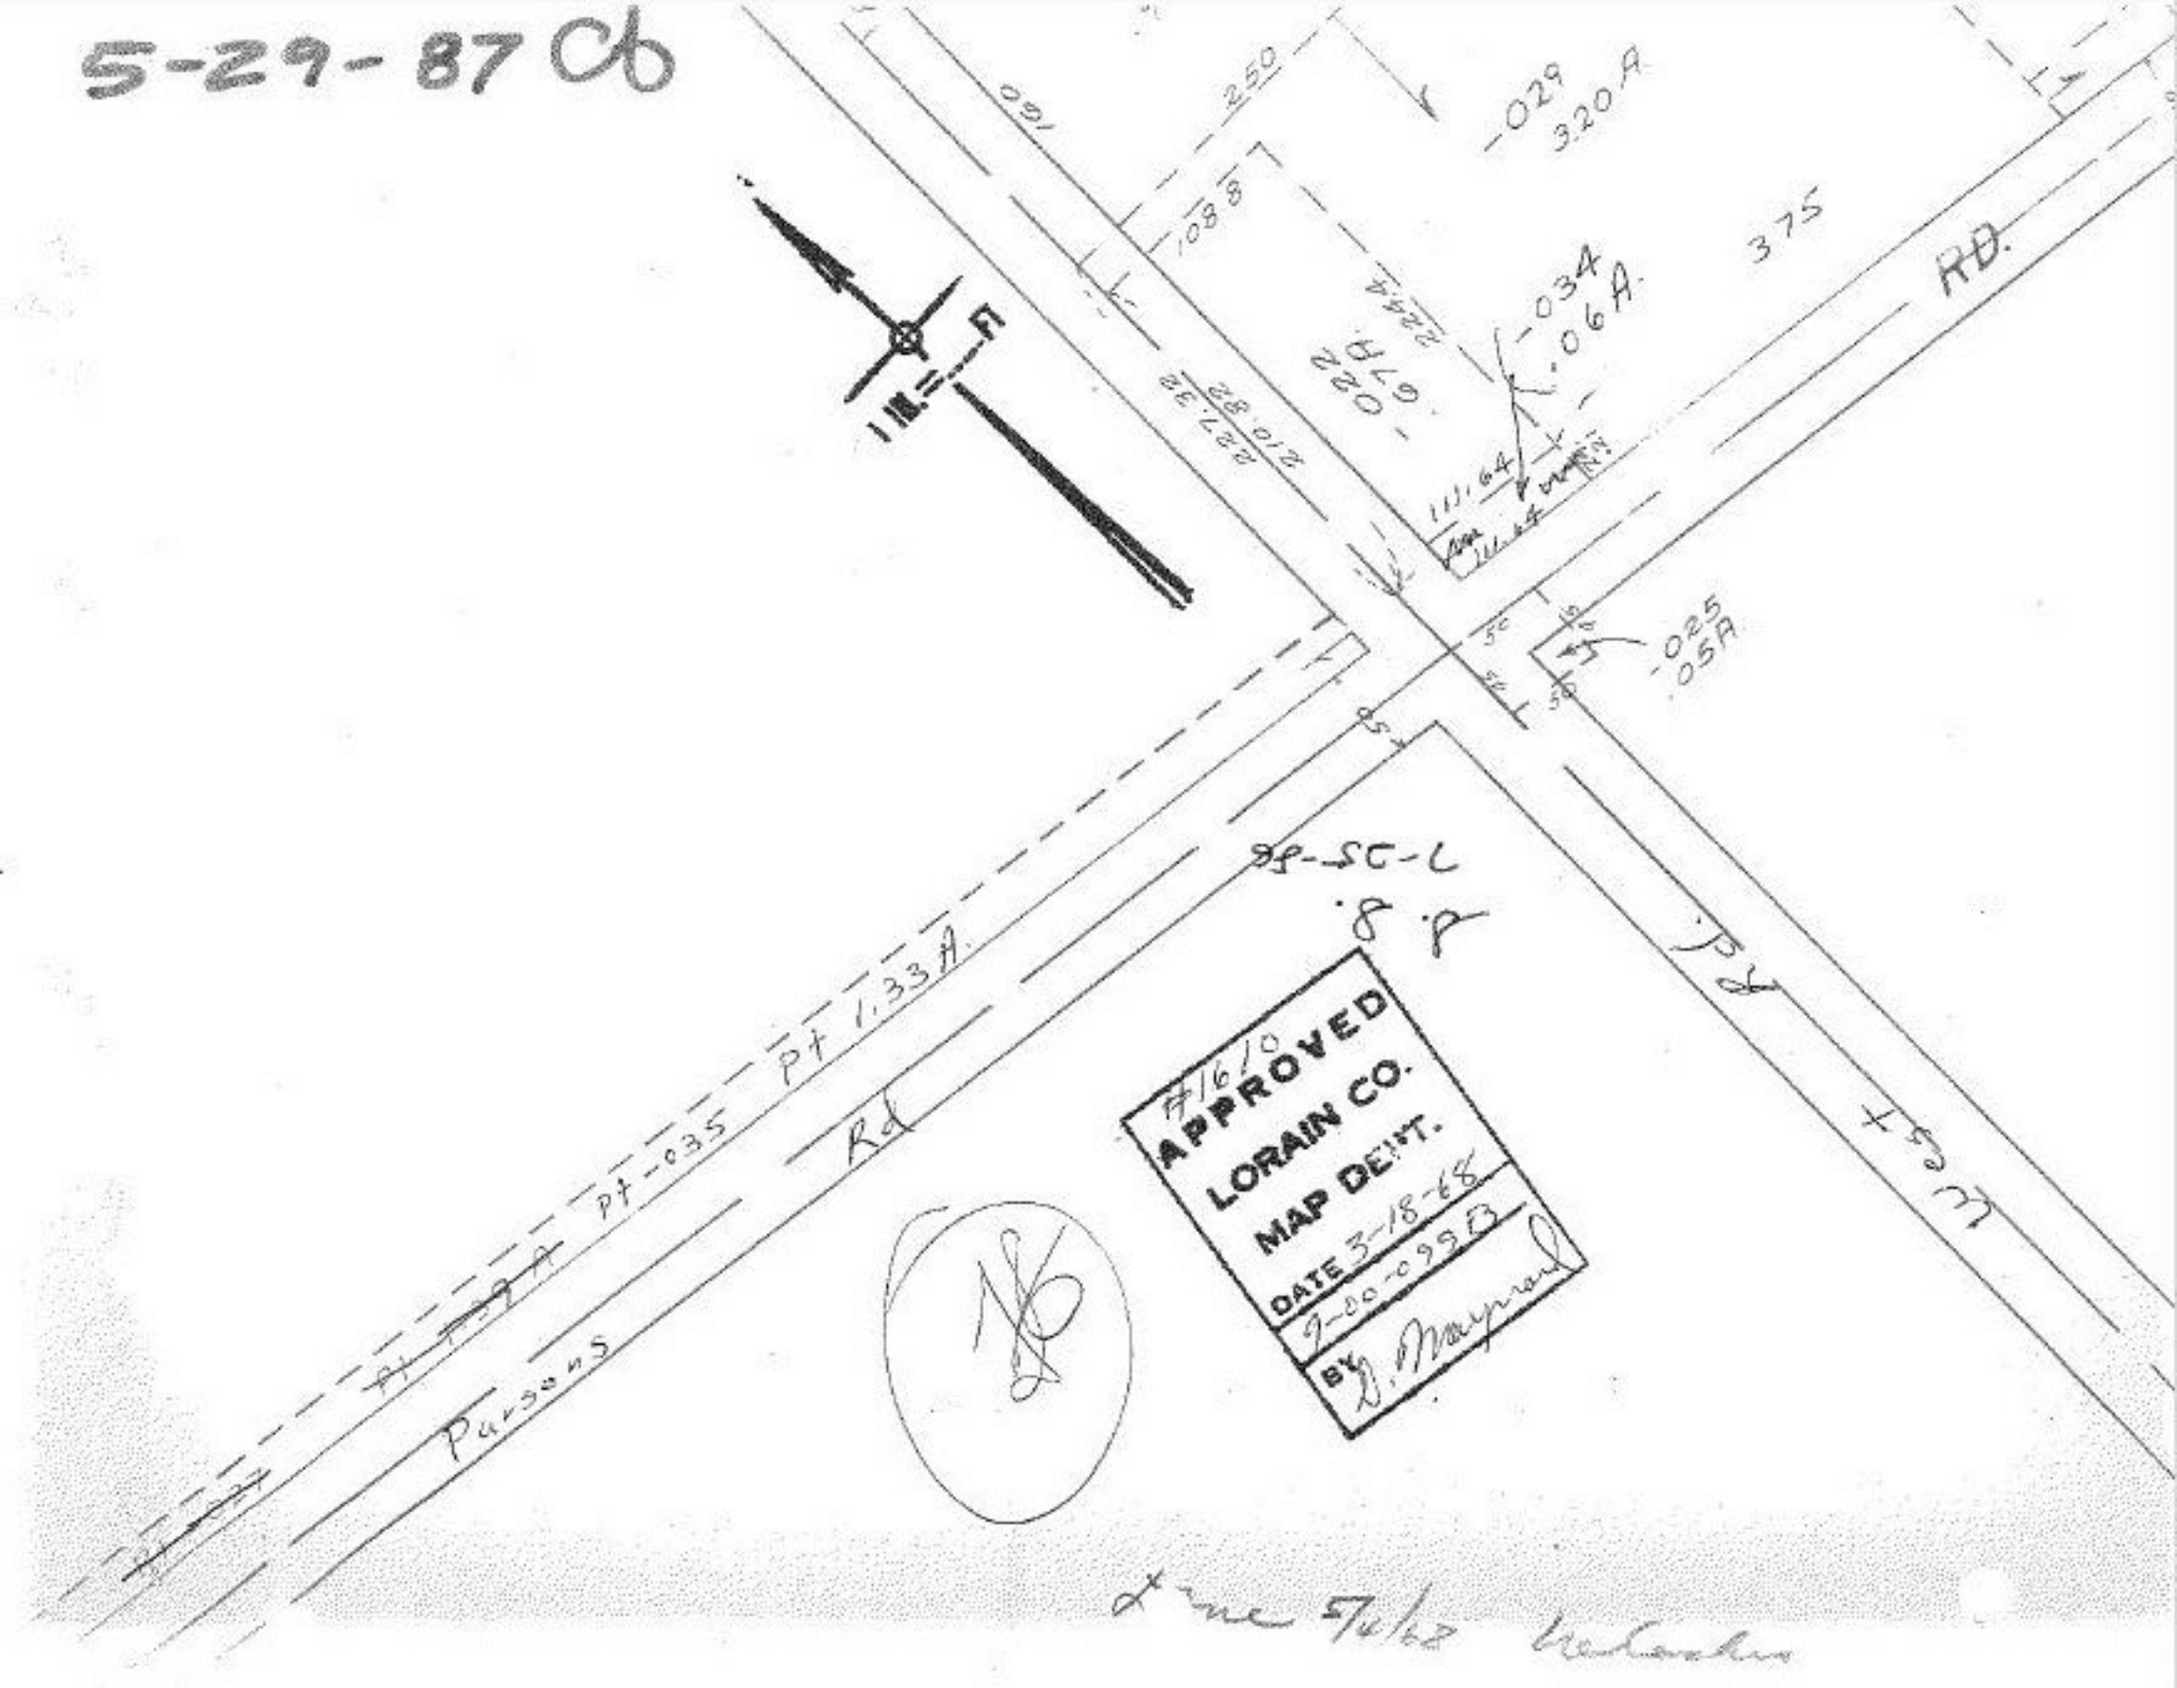
250
091
-029
3.20A
108
375
RD.
-034
.06A.
111.64
-025
.05A
Pt-035 Pt 1.33A
Parsons
Rd
#1610
APPROVED
LORAIN CO.
MAP DEPT.
DATE 3-18-88
By D. Maynard