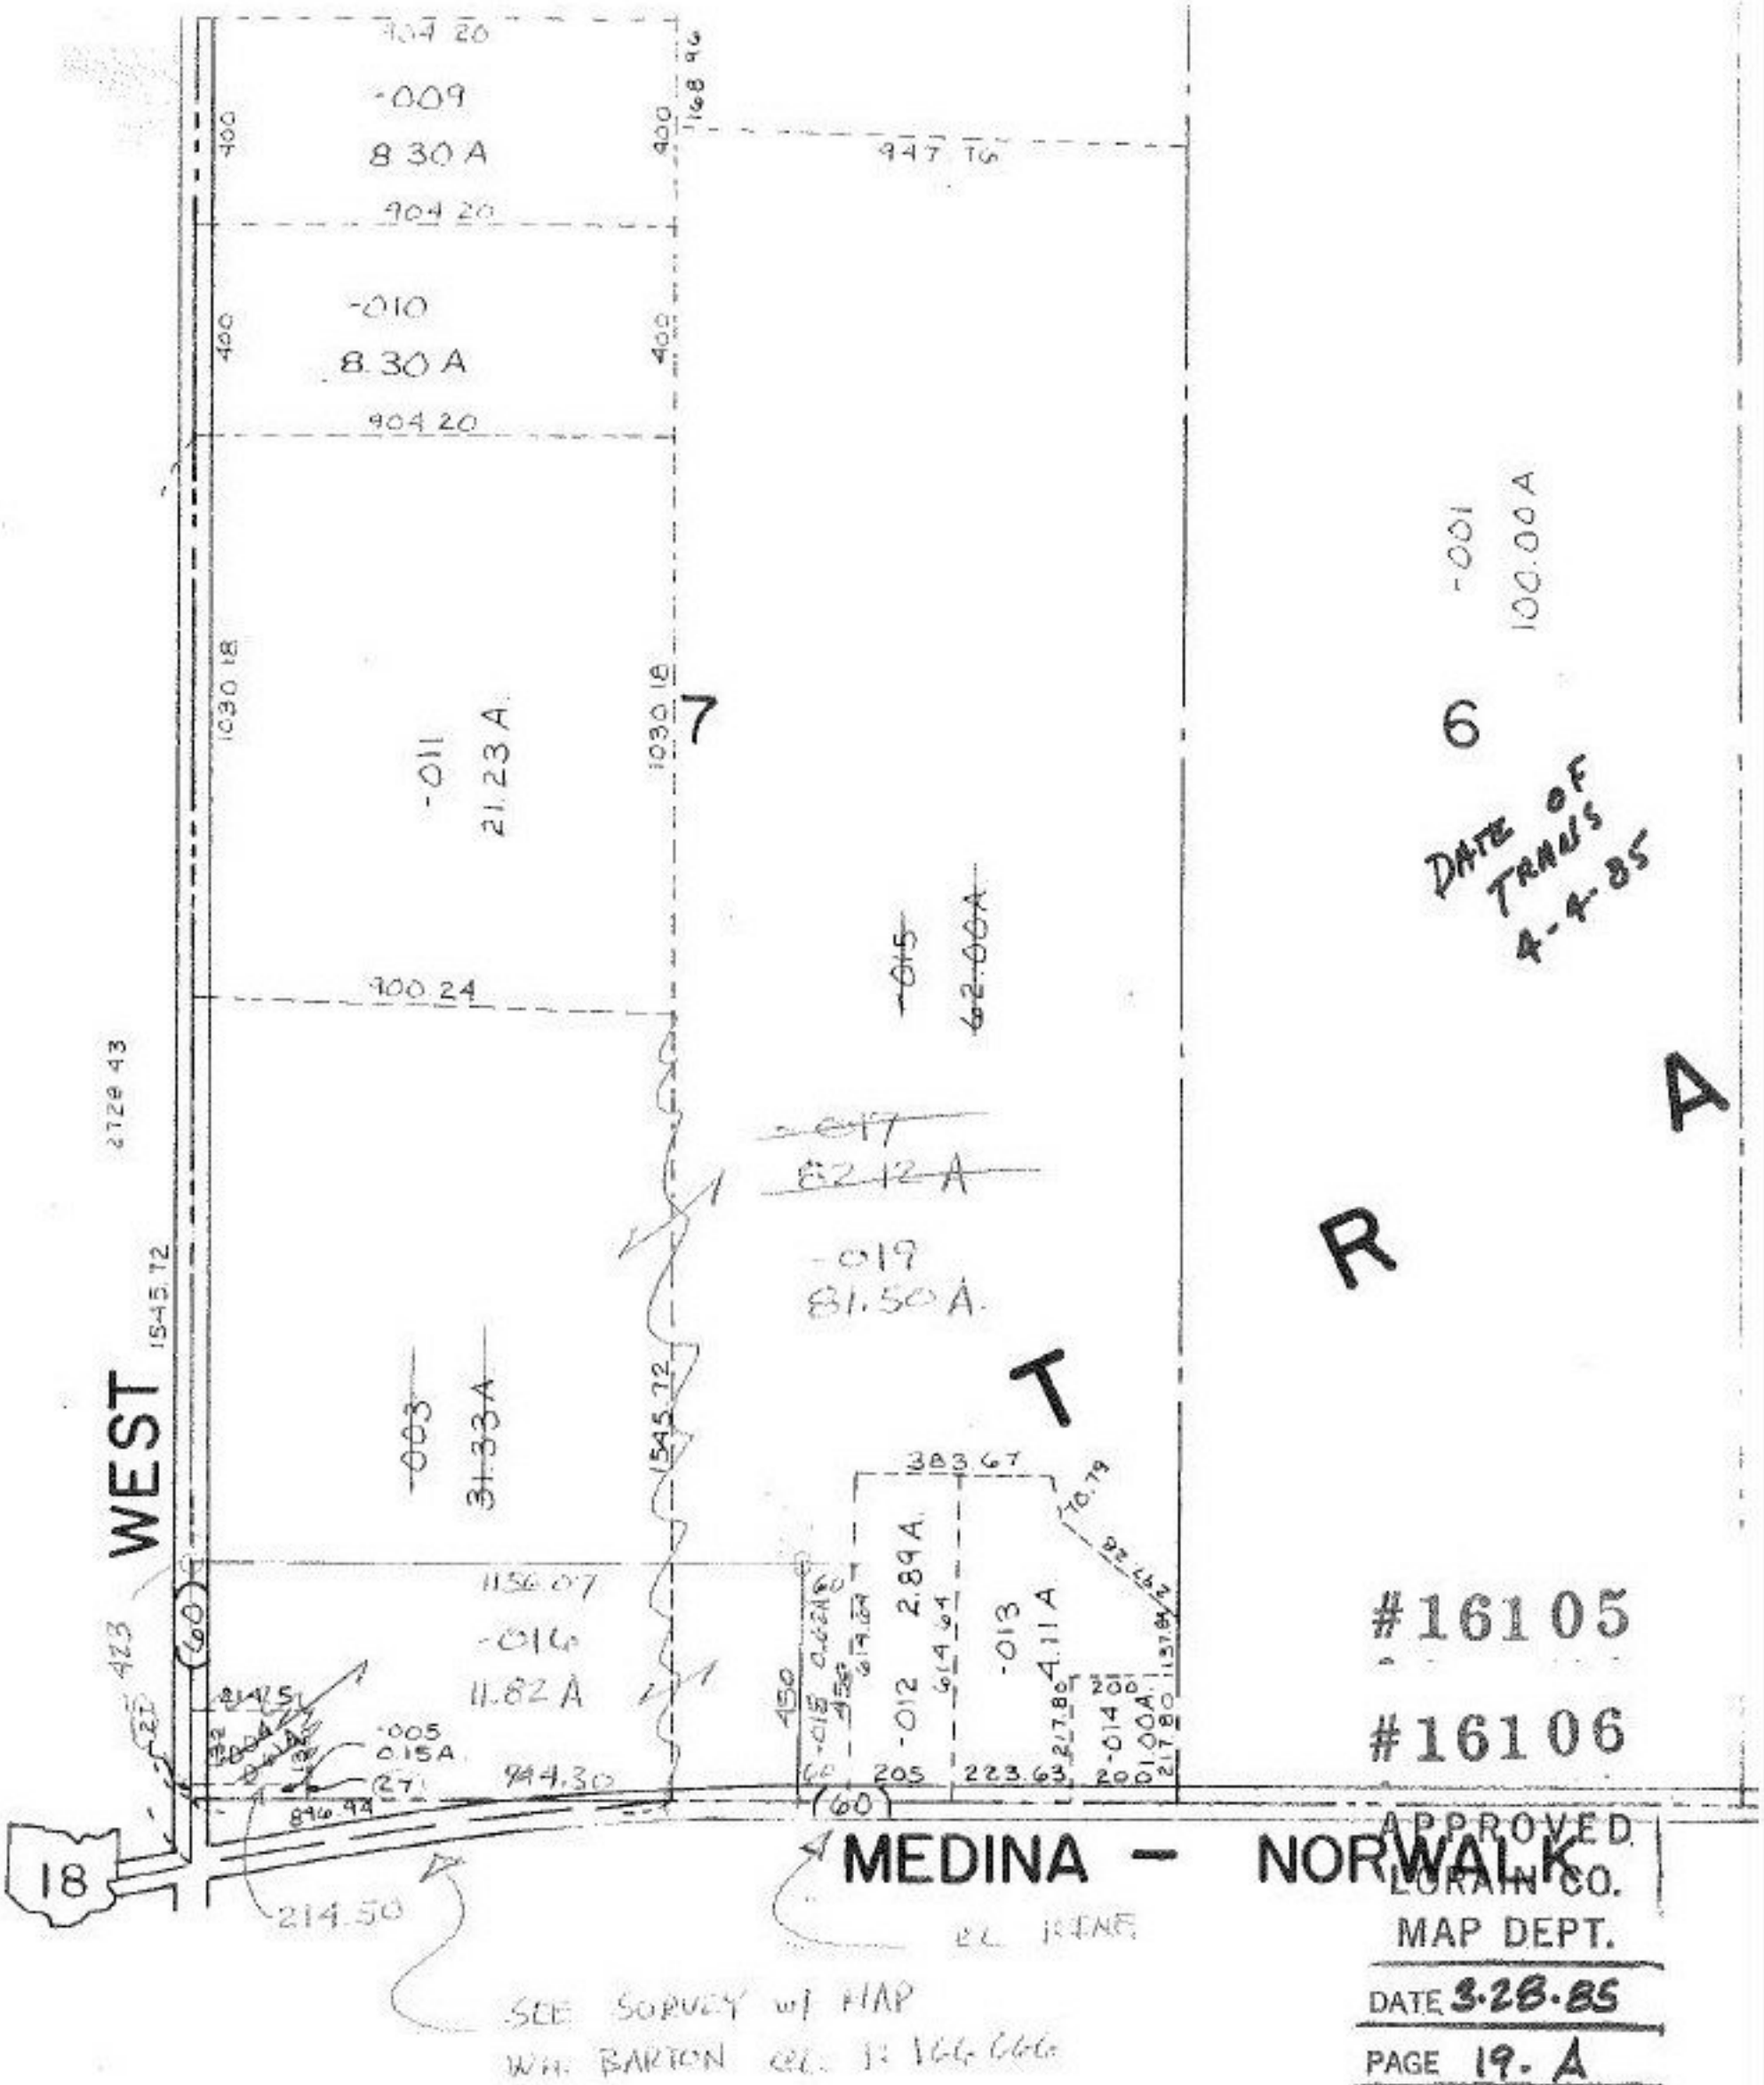

904.20
-009
8.30 A
904.20
-010
8.30 A
904.20
1030.18
-011
21.23 A
7
900.24
-015
62.00 A
-017
82.12 A
-019
81.50 A
-003
31.33 A
1545.72
WEST
1156.07
-016
11.82 A
-005
0.15 A
944.30
896.94
214.50
18
MEDINA - NORWALK
-001
100.00 A
6
DATE OF TRANS 4-4-85
T
R
A
383.67
-012
2.89 A
-013
4.11 A
-014
1.00 A
205
223.63
200
#16105
#16106
APPROVED
LORAIN CO.
MAP DEPT.
DATE 3.28.85
PAGE 19. A
SEE SURVEY w/ MAP
WM. BARTON