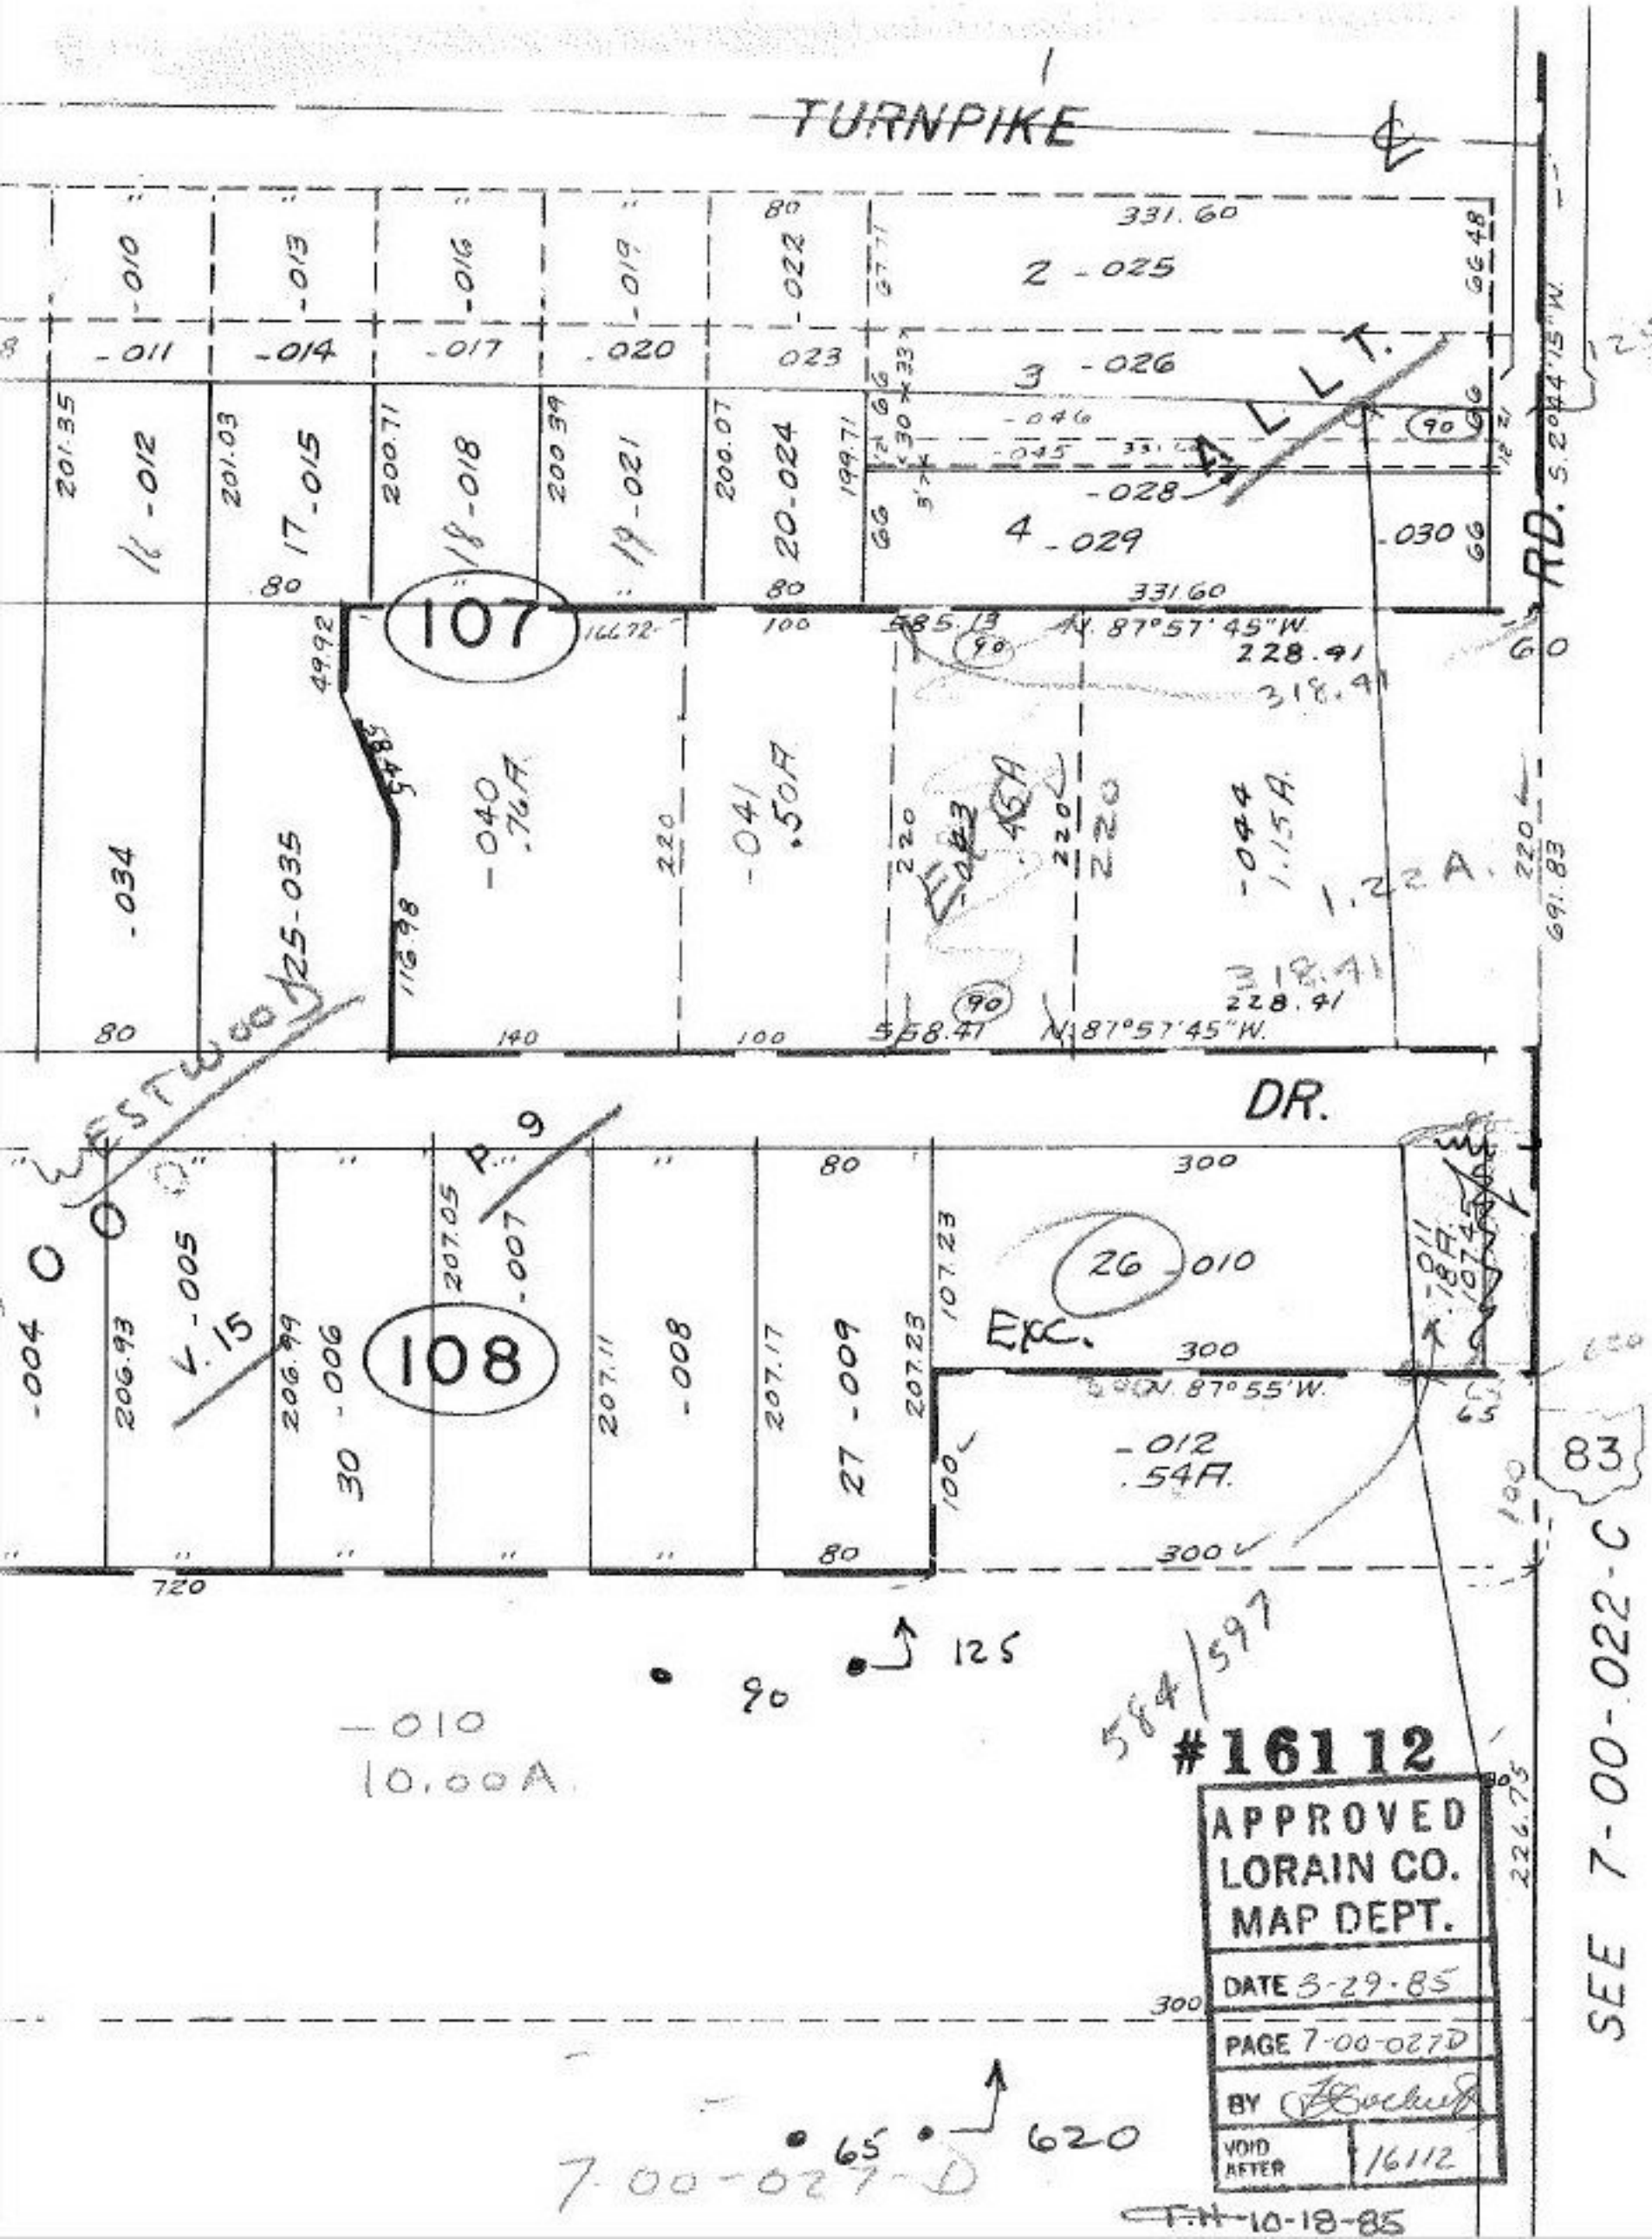
TURNPIKE
DR.
RD.
107
108
83
2 -025
3 -026
4 -029
-028
-030
-010
-011
-012
-013
-014
-015
-016
-017
-018
-019
-020
-021
-022
-023
-024
-034
-035
-040 .76A
-041 .50A
-044 1.15A
1.22A
-012 .54A
26 -010
27 -009
30 -006
-007
-008
-004
-005
-010 10.00A
N. 87°57'45"W.
N. 87°55'W.
S. 2°44'15"W.
Exc.
ALLT.
WESTWOOD
P. 9
V. 15
584/597
7-00-027-D
SEE 7-00-022-C
#16112
APPROVED
LORAIN CO.
MAP DEPT.
DATE 3-29-85
PAGE 7-00-027D
BY
VOID AFTER 16112
T.H. 10-18-85