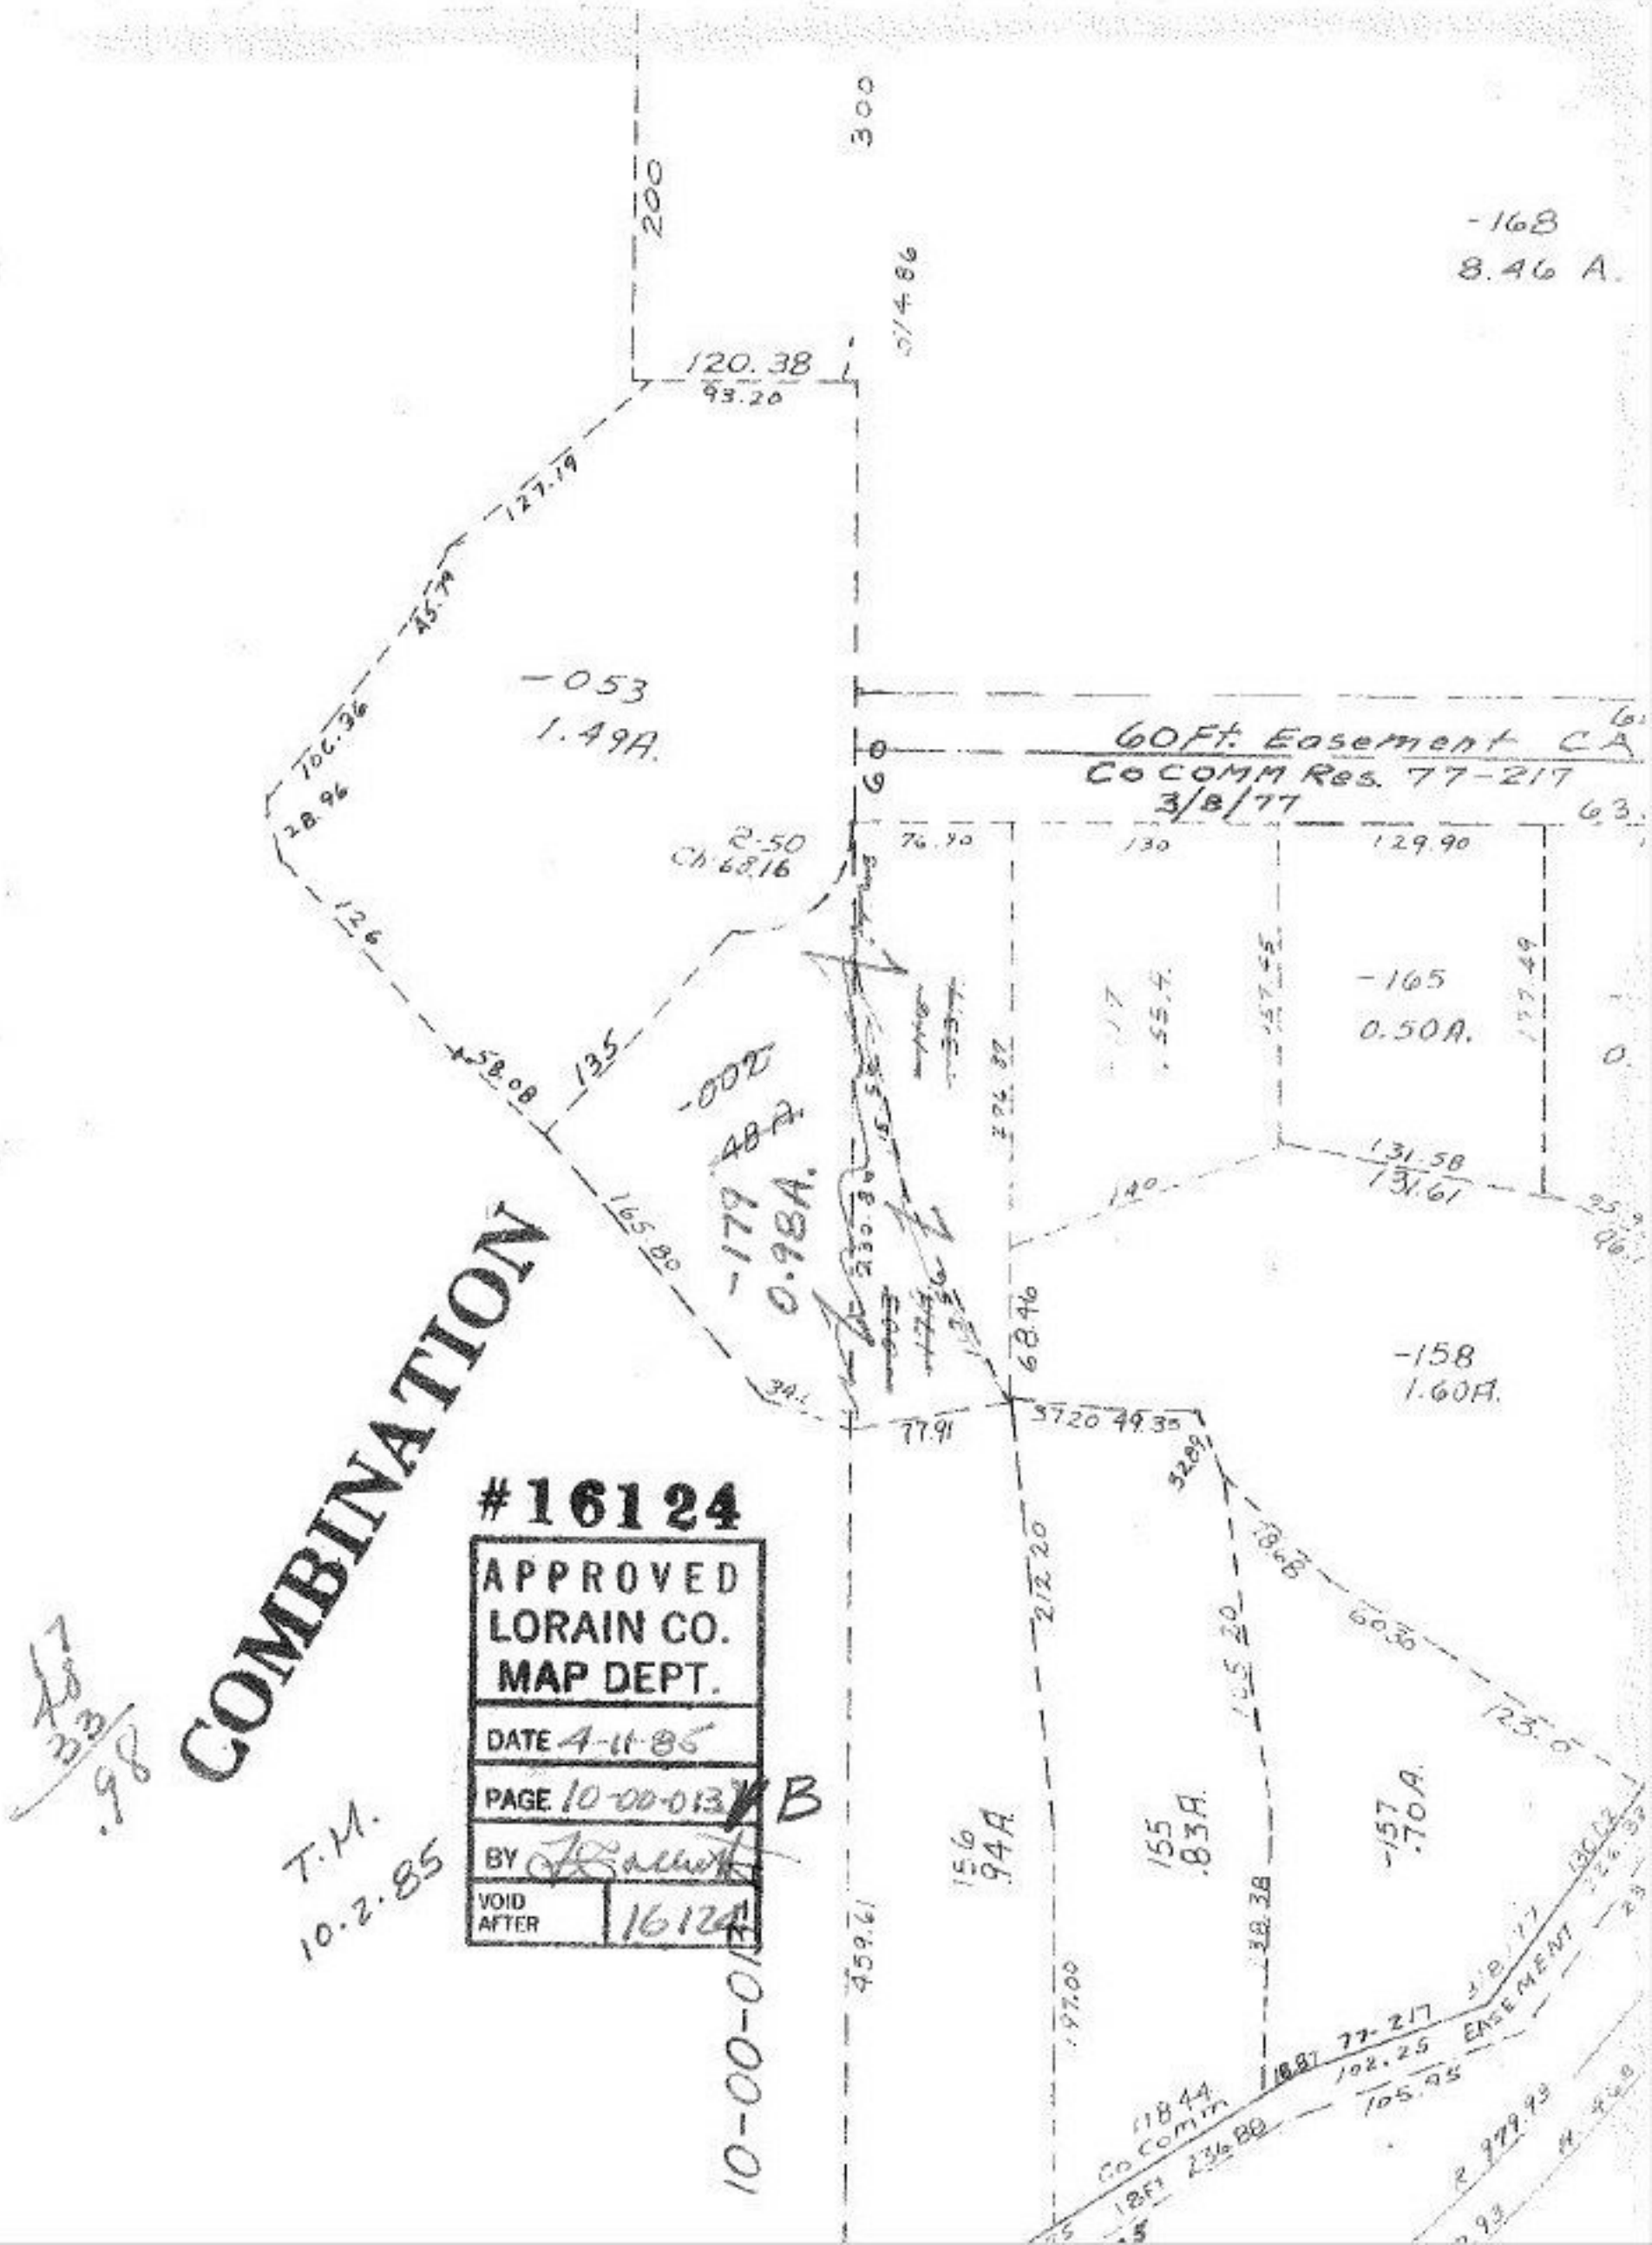

COMBINATION
#16124
APPROVED
LORAIN CO.
MAP DEPT.
DATE 4-11-85
PAGE 10-00-013 B
BY
VOID AFTER 16124
T.M.
10.2.85
10-00-013
-168
8.46 A.
-053
1.49A.
60Ft. Easement CA
Co COMM Res. 77-217
3/8/77
-165
0.50A.
-158
1.60A.
-179
0.98A.
-002
-157
.70A.
155
.83A.
156
.94A