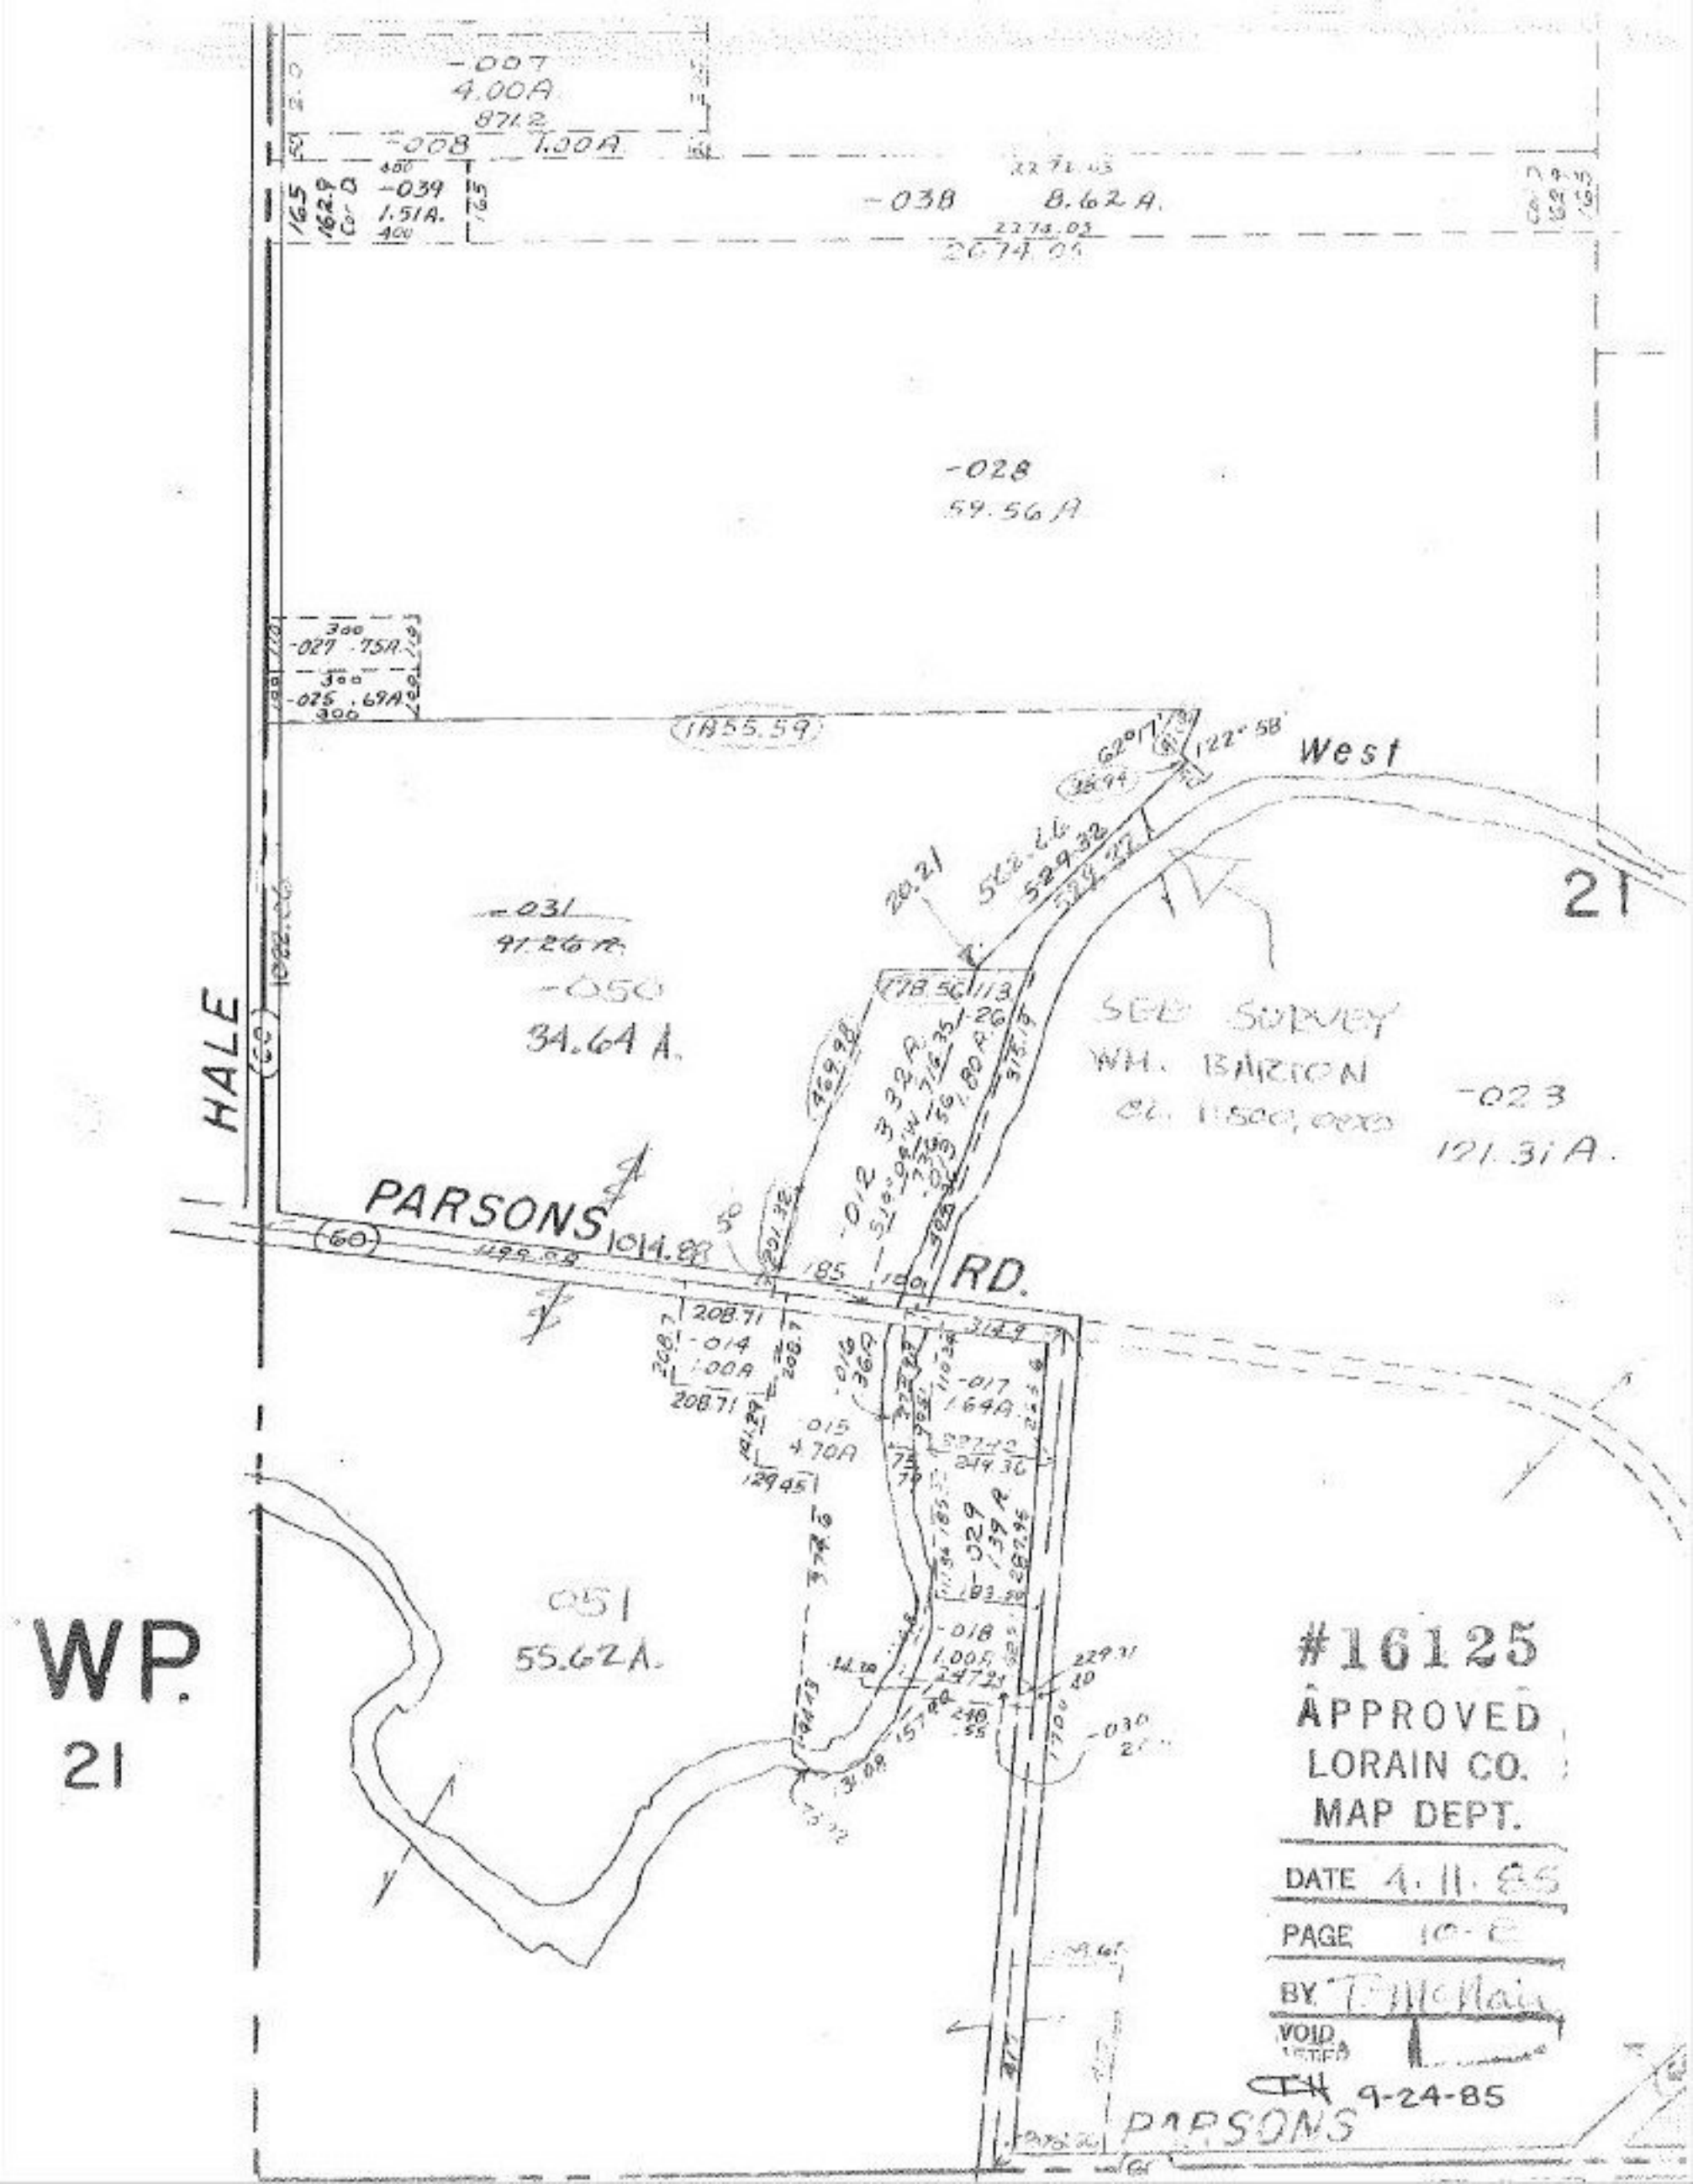

-007
4.00A
871.2
-008 1.00A
-039
1.51A.
-038 8.62 A.
2674.05
-028
59.56 A
-027 .75A.
-025 .69A
1855.59
West
21
-031
91.26 A.
-050
34.64 A.
SEE SURVEY
WM. BARTON
-023
121.31 A.
HALE
PARSONS
1014.88
RD.
-014
1.00A
-015
4.70A
-017
1.64A
-029
1.39 A
-018
1.00A
051
55.62A.
WP.
21
#16125
APPROVED
LORAIN CO.
MAP DEPT.
DATE 4.11.85
PAGE 10-E
BY
VOID
9-24-85
PARSONS