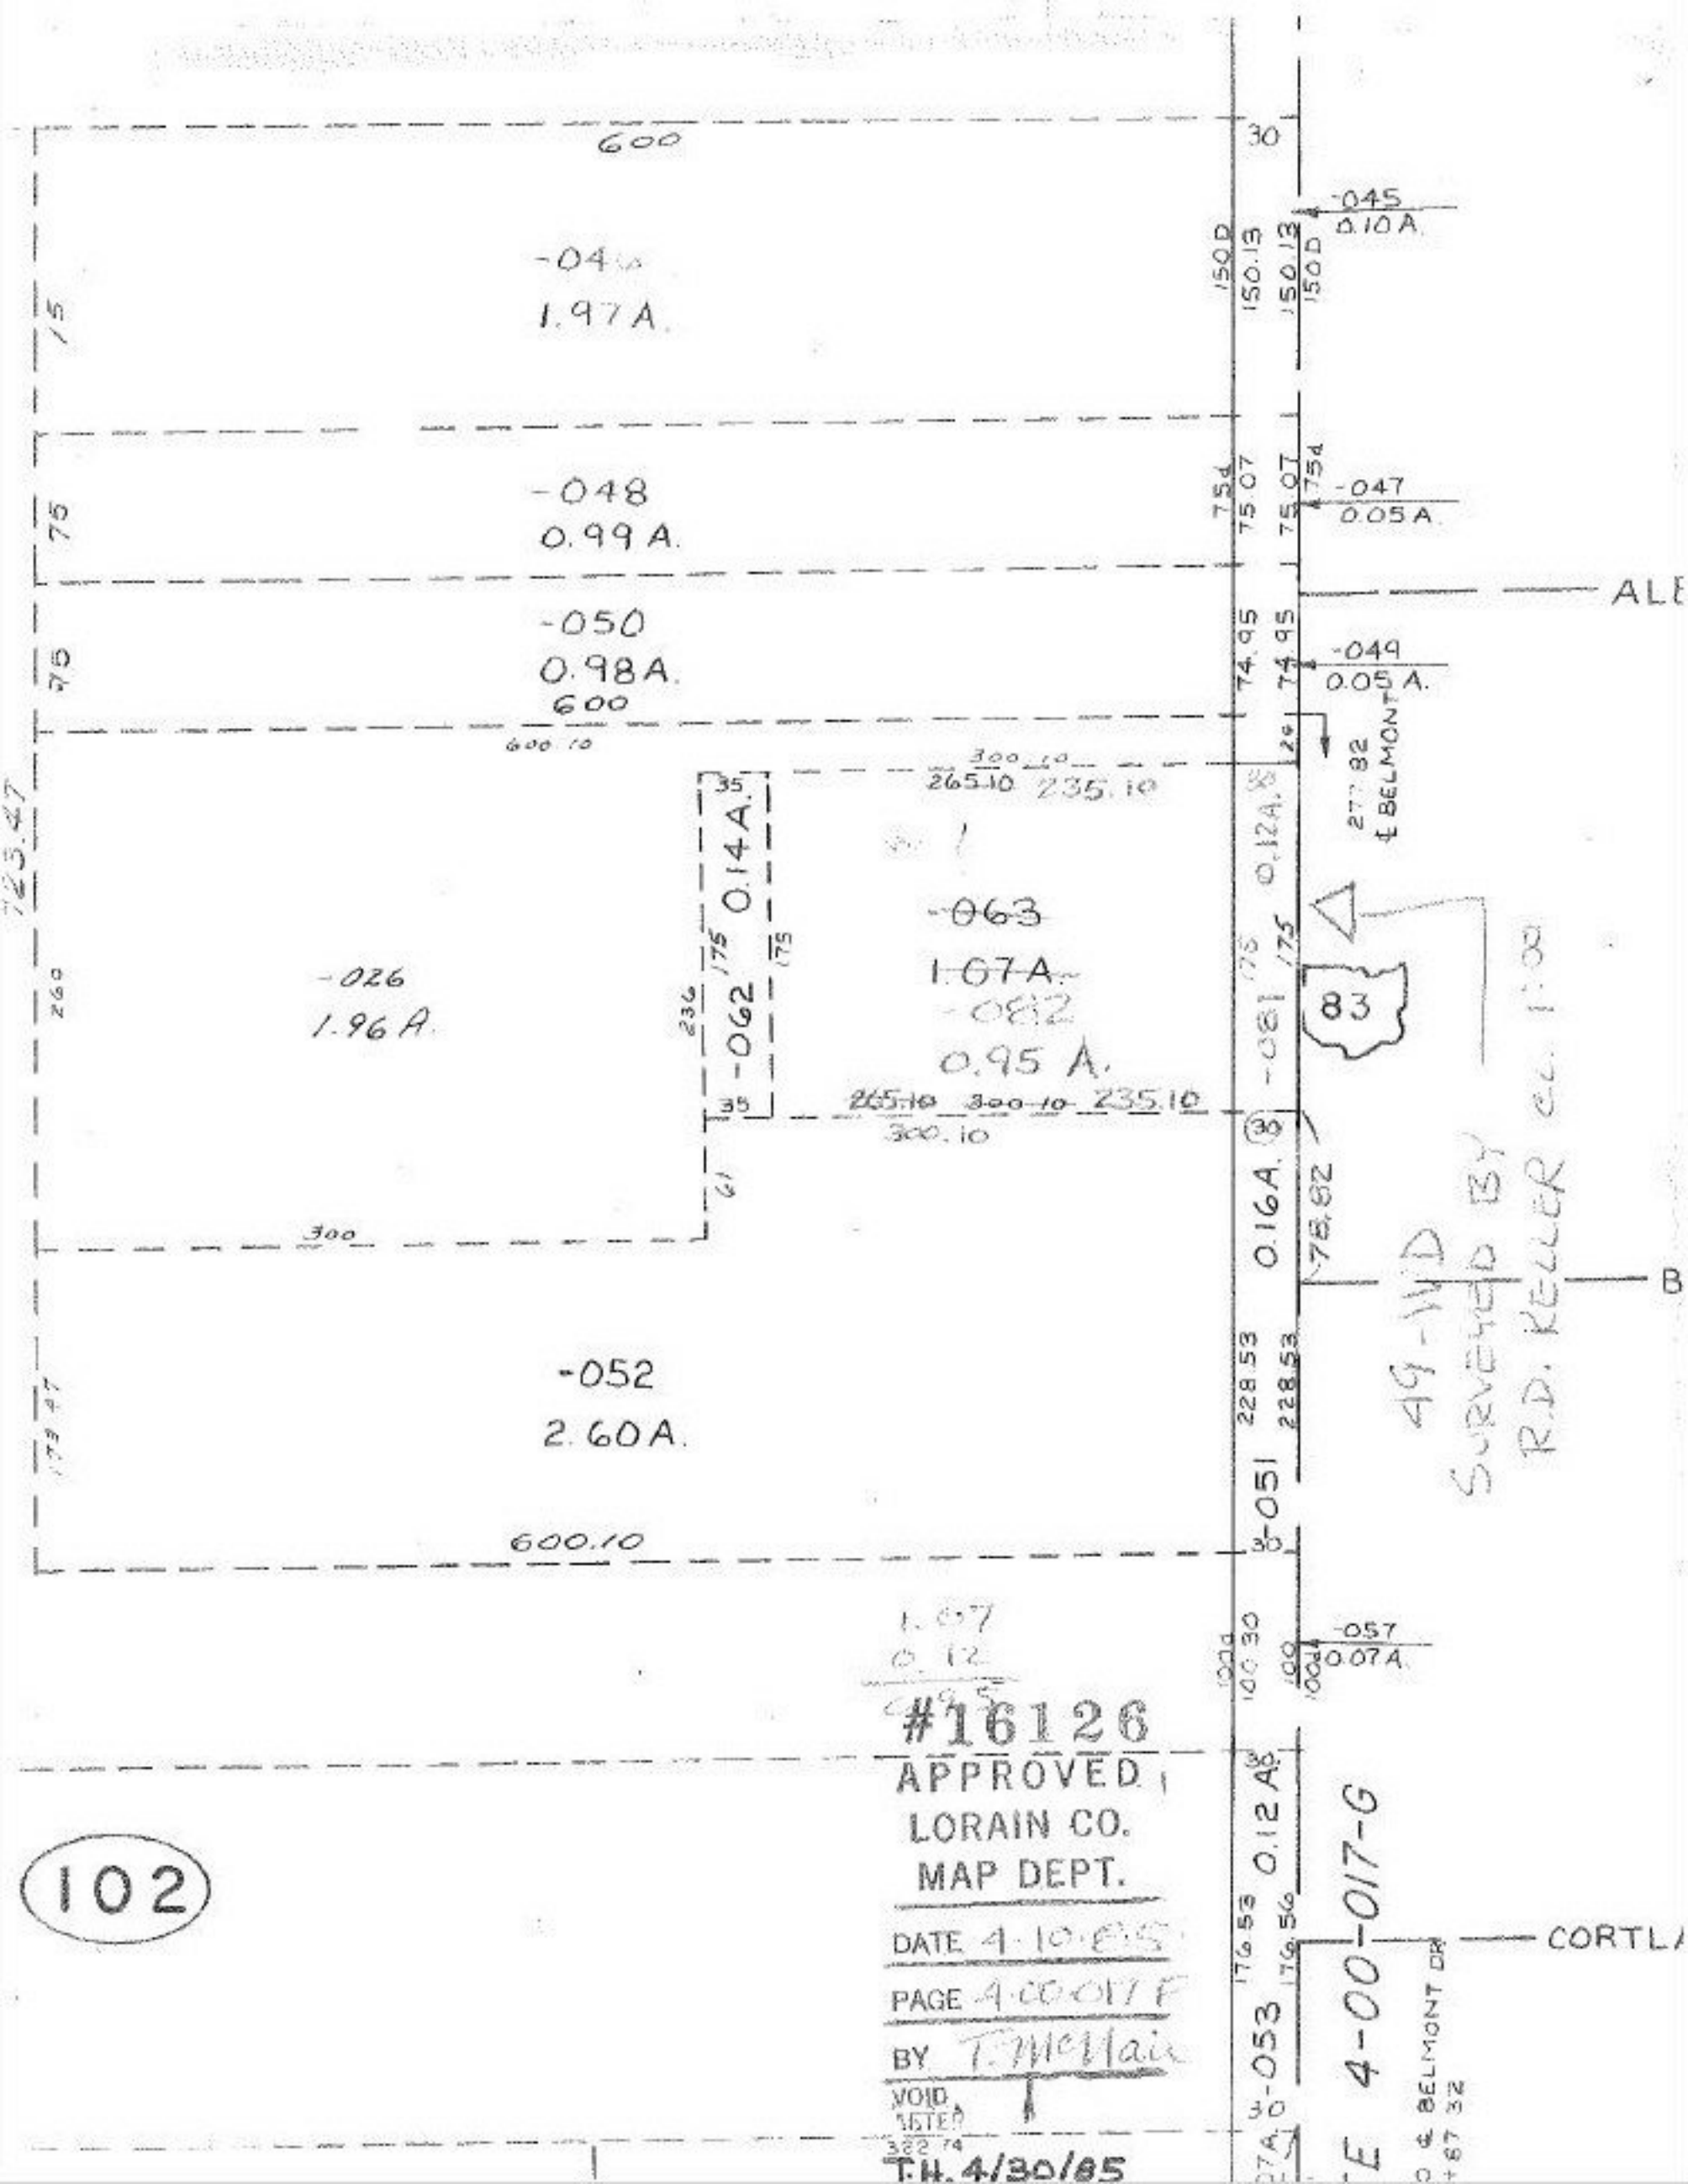

600
-045
0.10 A.
-048
1.97 A.
-048
0.99 A.
-047
0.05 A.
ALE
-050
0.98 A.
600
-049
0.05 A.
600.10
300.10
265.10
235.10
0.14 A.
-062
-063
1.07 A.
-082
0.95 A.
-026
1.96 A.
-081
0.12 A.
83
0.16 A.
-052
2.60 A.
-051
600.10
-057
0.07 A.
0.12 A.
-053
CORTLA
4-00-017-G
49-WD
SURVEYED BY
R.D. KELLER
102
#16126
APPROVED
LORAIN CO.
MAP DEPT.
DATE 4-10-85
PAGE 4-00-017 F
BY T. McNair
VOID
T.H. 4/30/85