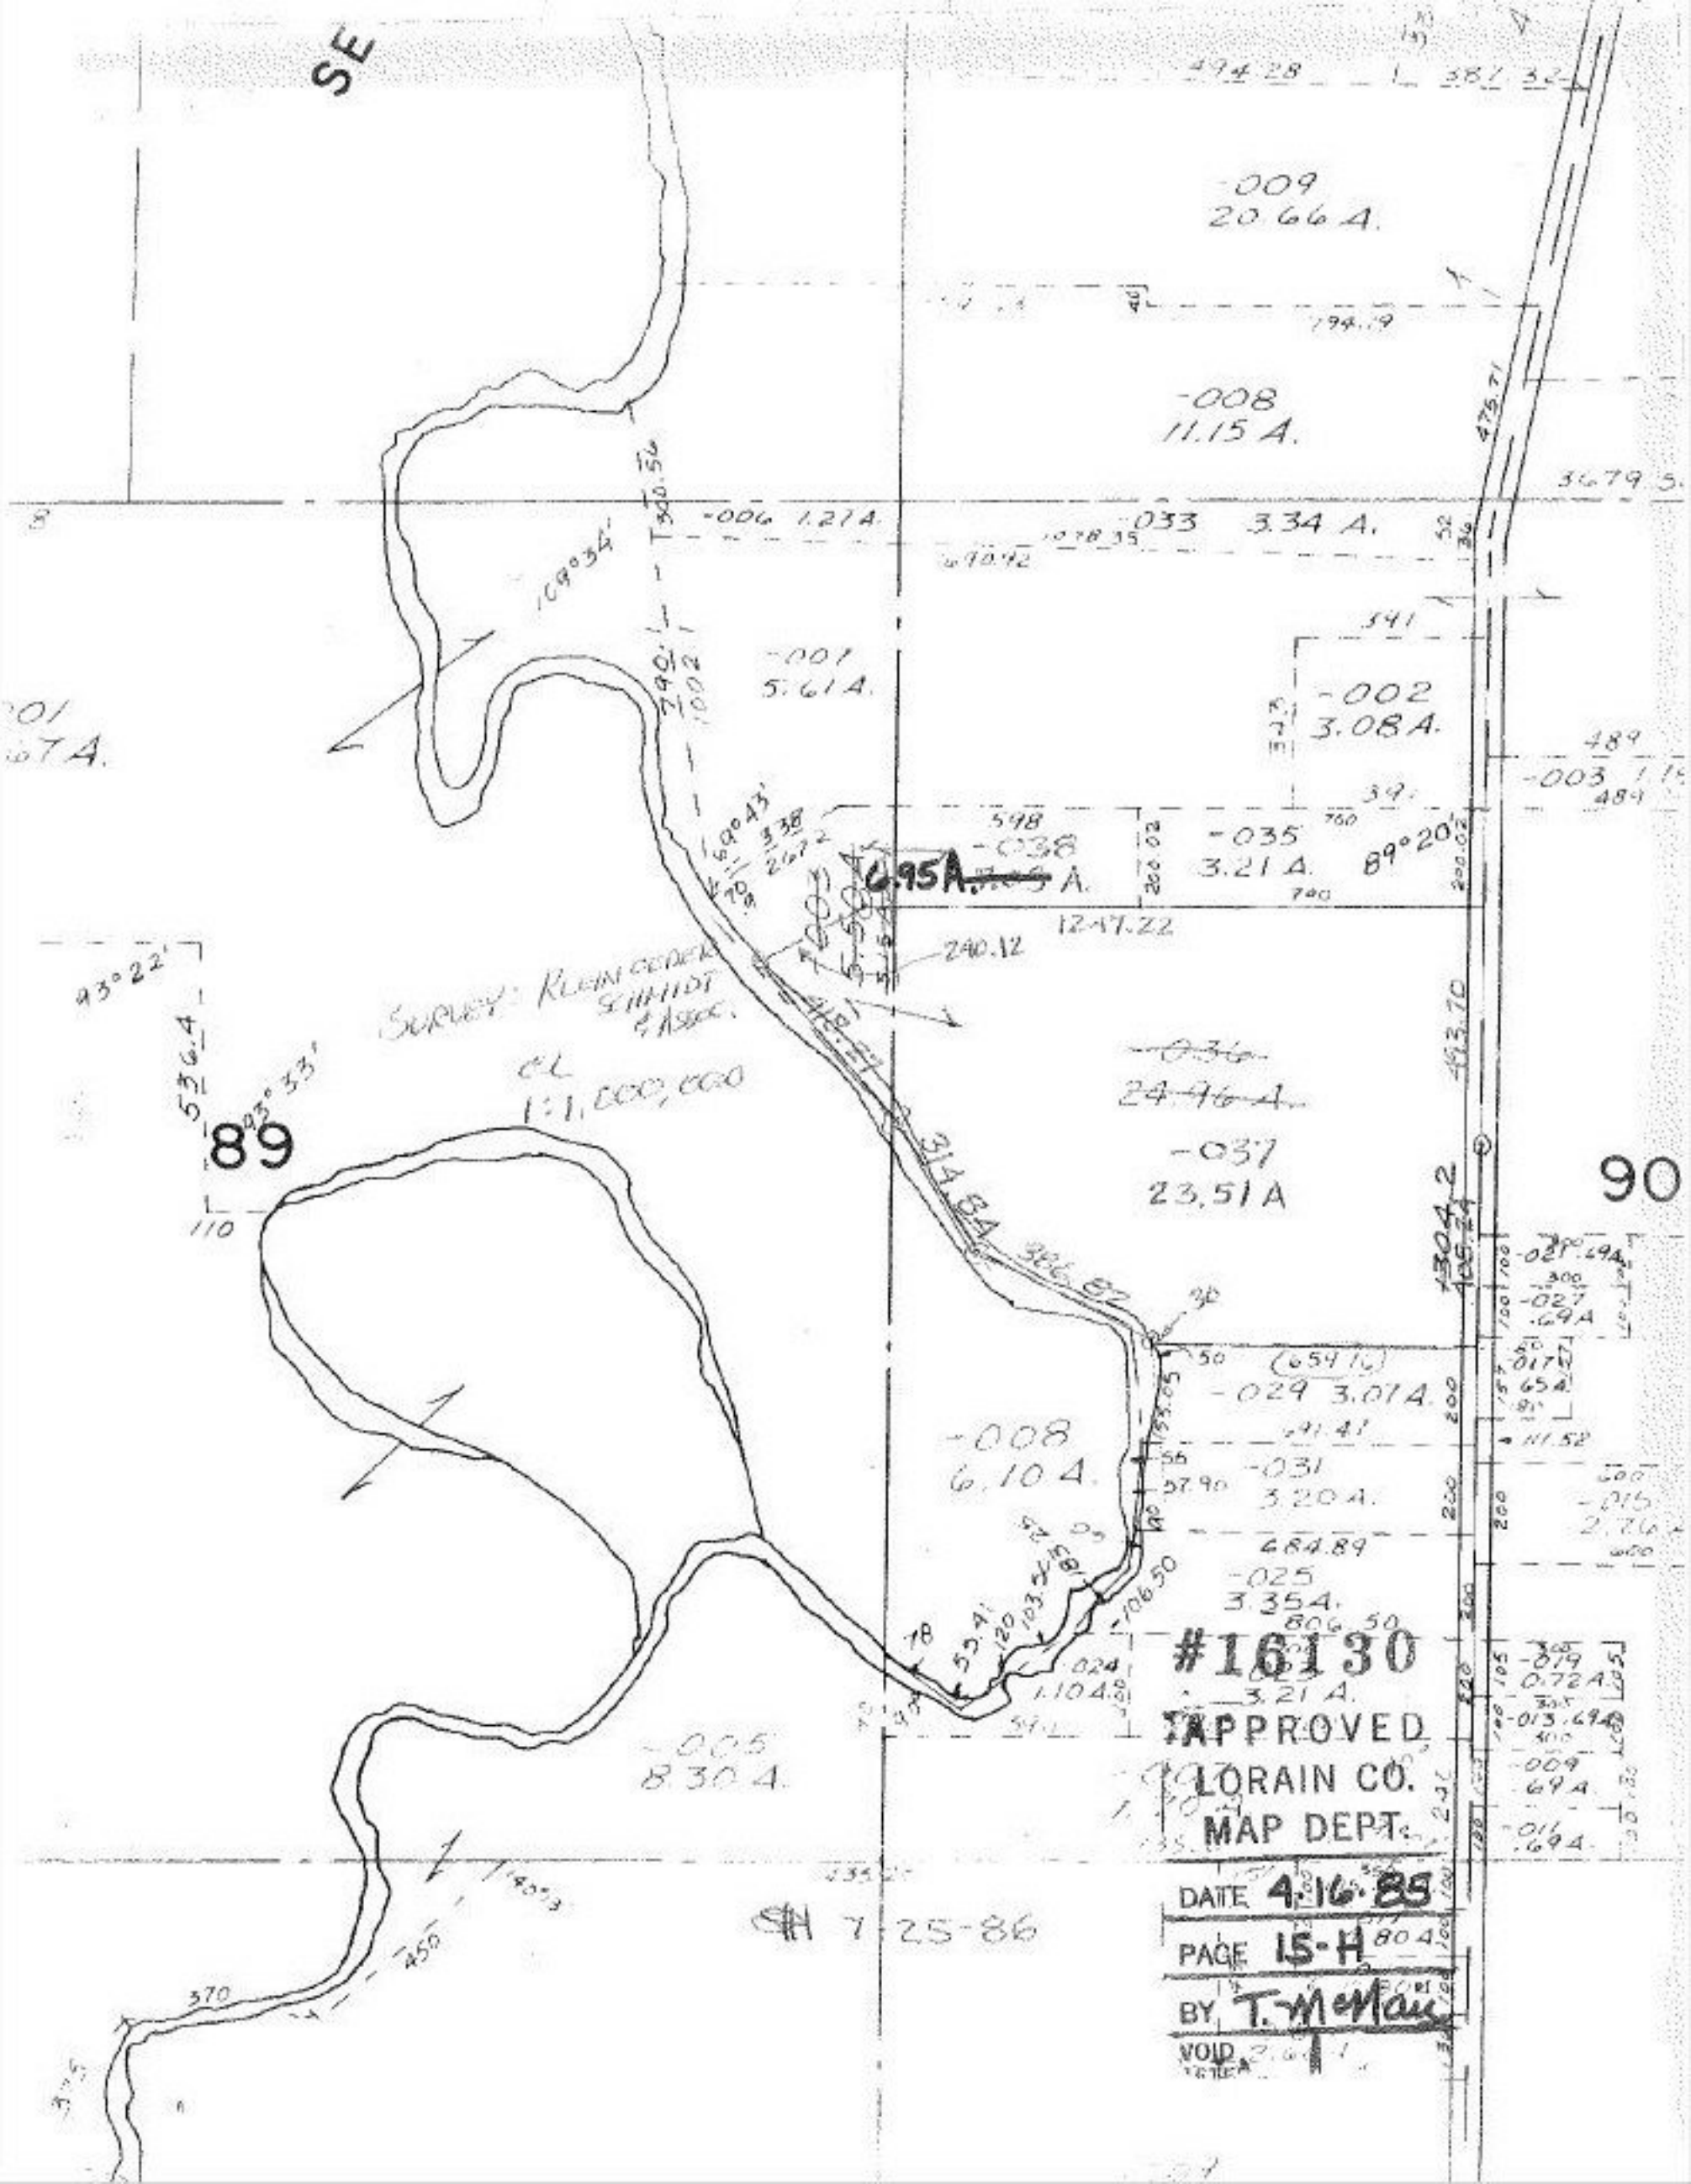

SE
-009
20.66 A.
-008
11.15 A.
-006 1.27 A.
-033 3.34 A.
-007
5.61 A.
-002
3.08 A.
-003
-038
6.95 A.
-035
3.21 A.
89°20'
1247.22
240.12
SURVEY: KLEINOEDER SCHMIDT & ASSOC.
CL
1:1,000,000
89
90
-036
24.96 A.
-037
23.51 A
314.84
386.82
-029 3.07 A.
-008
6.10 A.
-031
3.20 A.
684.89
-025
3.35 A.
806.50
3.21 A.
-005
8.30 A.
7-25-86
#16130
APPROVED
LORAIN CO.
MAP DEPT.
DATE 4-16-85
PAGE 15-H
BY T. McNair
VOID