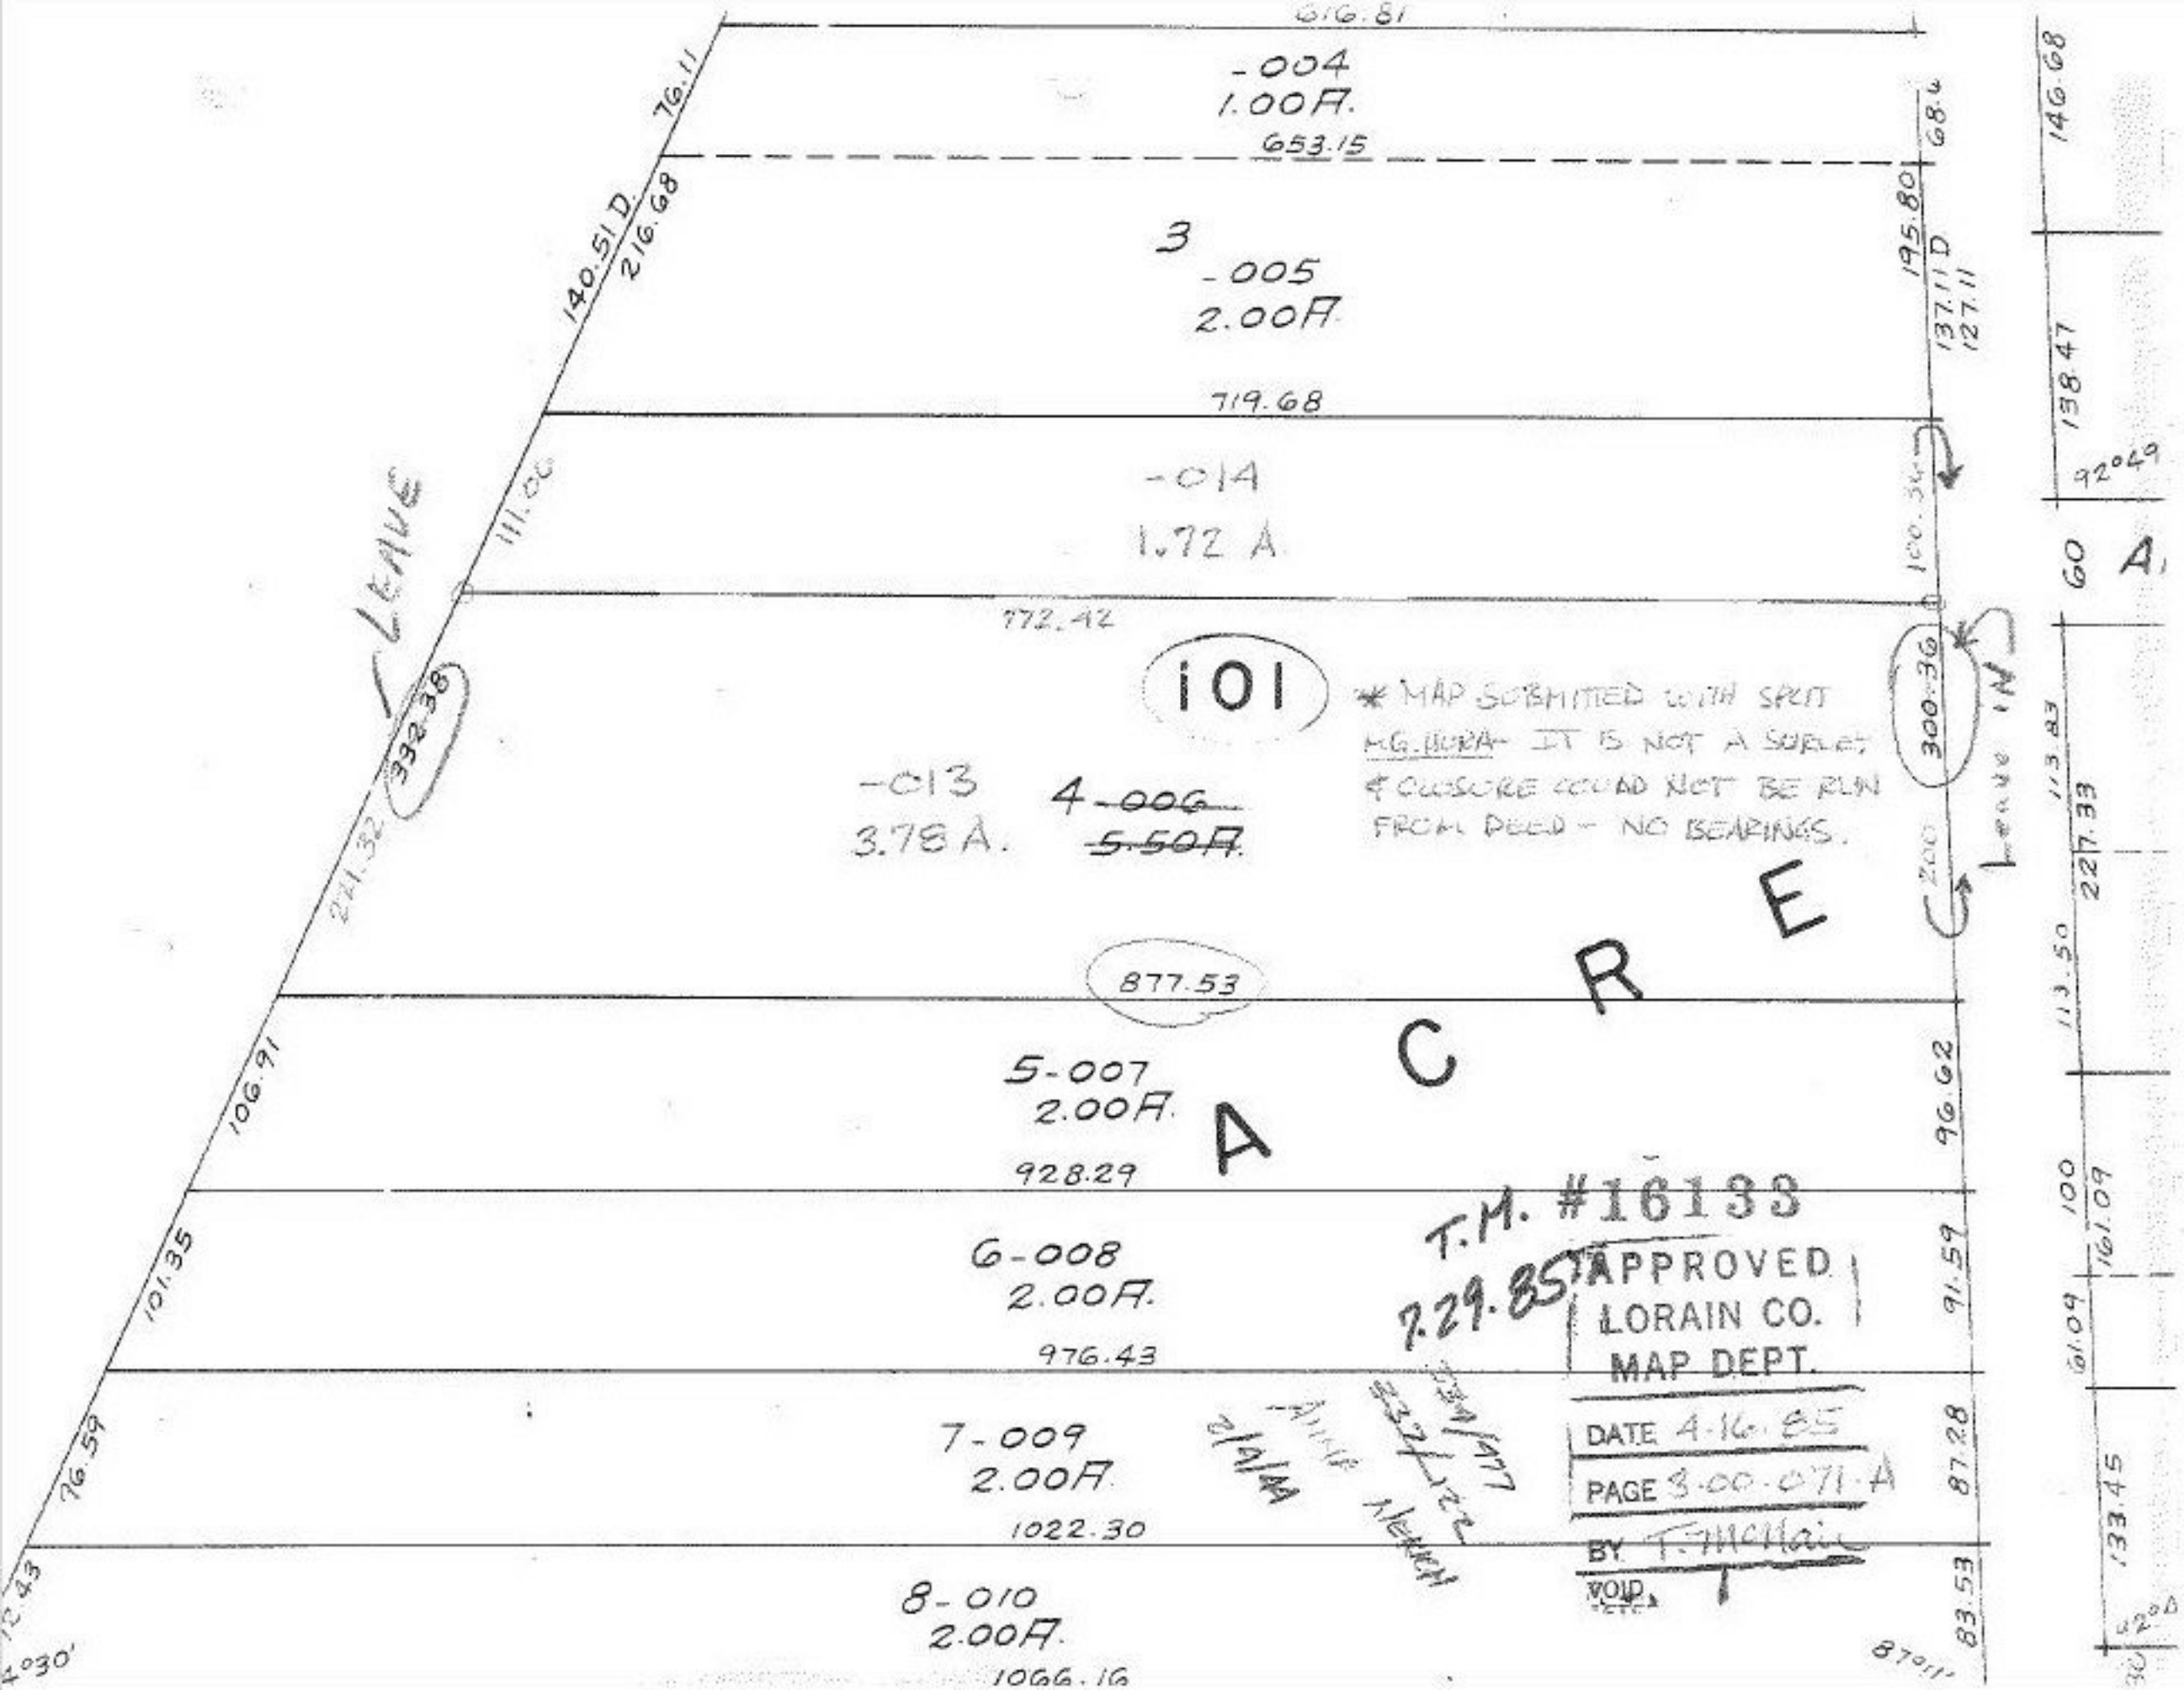

616.81
-004
1.00A.
653.15
3
-005
2.00A
719.68
-014
1.72 A
772.42
101
* MAP SUBMITTED WITH SPLIT
M.G. HURA - IT IS NOT A SURVEY
& CLOSURE COULD NOT BE RUN
FROM DEED - NO BEARINGS.
-013
3.78 A.
4 ~~-006~~
~~5.50A~~
877.53
5-007
2.00A.
928.29
6-008
2.00A.
976.43
7-009
2.00A
1022.30
8-010
2.00A.
1066.16
LEAVE
A C R E
T.M. #16133
7.29.85
APPROVED
LORAIN CO.
MAP DEPT.
DATE 4-16-85
PAGE 3-00-071-A
BY T. McNair
VOID
76.11
140.51 D.
216.68
111.00
332.38
221.32
106.91
101.35
76.59
12.43
4°30'
195.80
137.11 D
127.11
100.36
300.36
200
96.62
91.59
87.28
83.53
87°11'
146.68
138.47
92°49
60
113.83
227.33
113.50
100
161.09
61.09
133.45