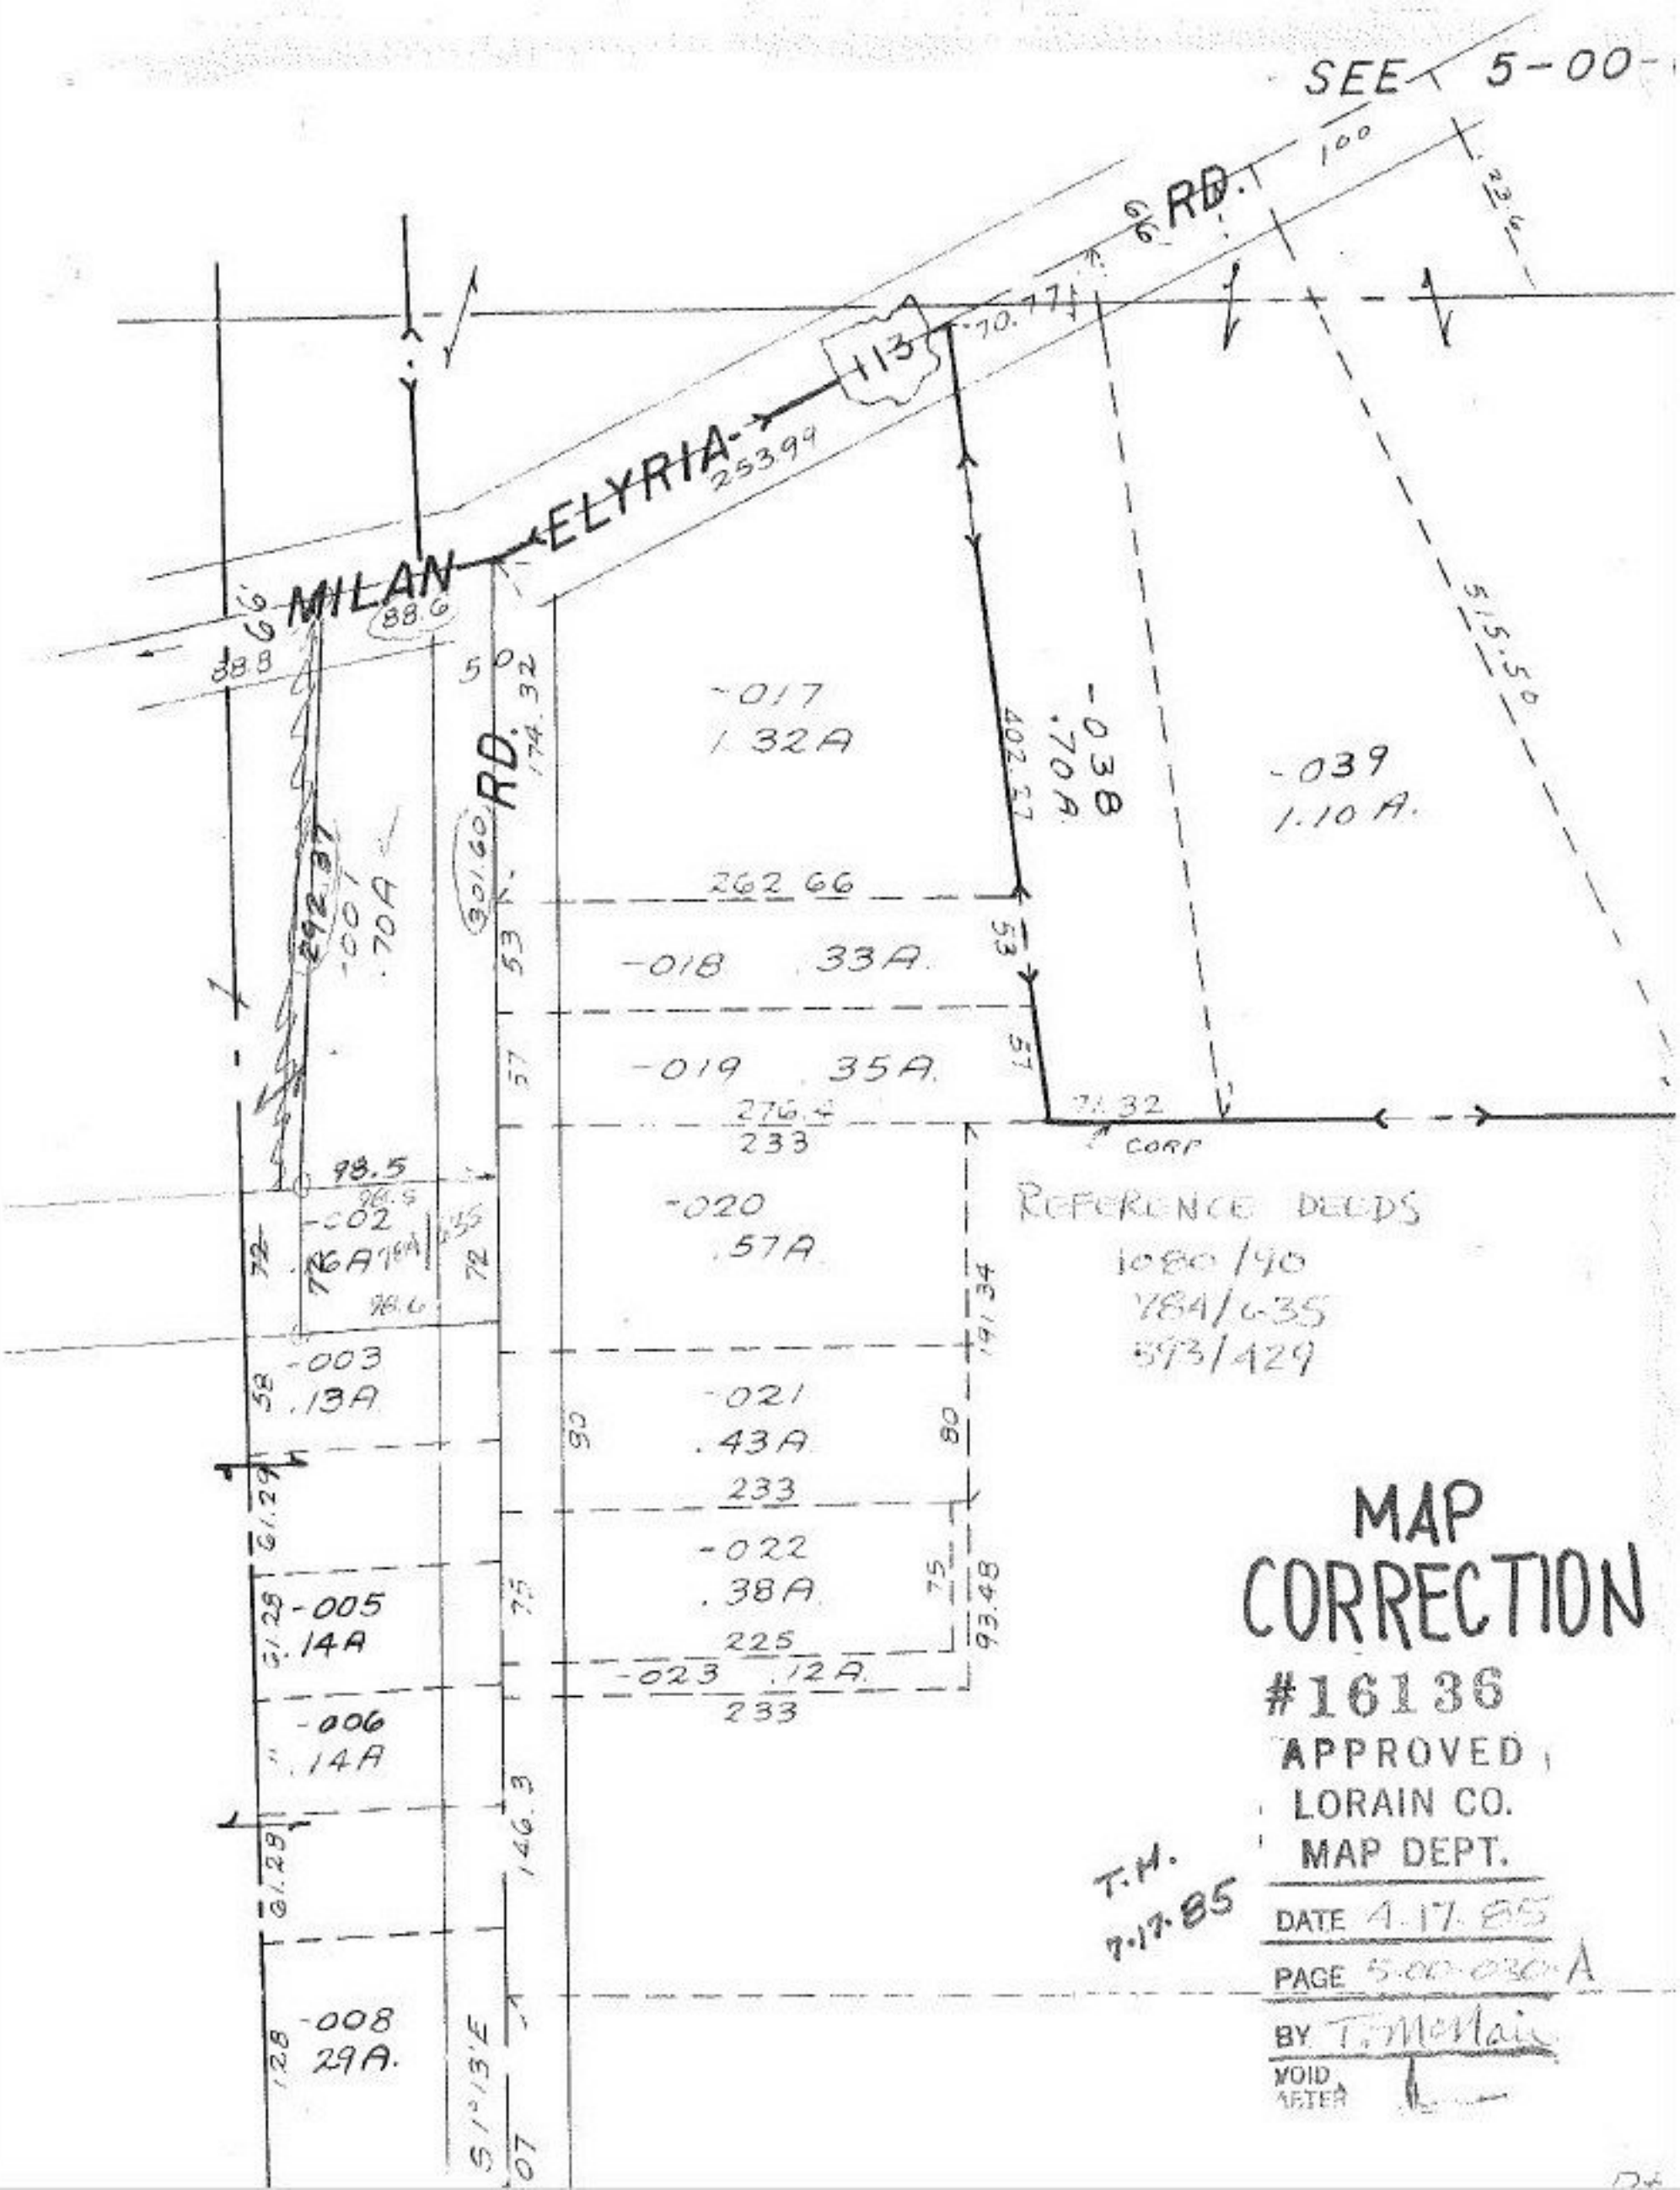
SEE 5-00-
MILAN ELYRIA RD.
113
253.99
70.77
88.6
88.8
RD.
174.32
301.60
-017
1.32A
-038
.70A
402.27
-039
1.10A.
515.50
262.66
-018 .33A.
-019 .35A.
276.4
233
71.32
CORP
-020
.57A
-021
.43A
233
-022
.38A
225
-023 .12A.
233
191.34
93.48
-003
.13A
-005
.14A
-006
.14A
-008
29A.
98.5
-002
.76A
61.29
61.28
146.3
S1°13'E
REFERENCE DEEDS
1080/90
784/635
593/429
MAP
CORRECTION
#16136
APPROVED
LORAIN CO.
MAP DEPT.
DATE 4.17.85
PAGE 5-00-030-A
BY T. McNair
VOID
AFTER
T.H.
7.17.85