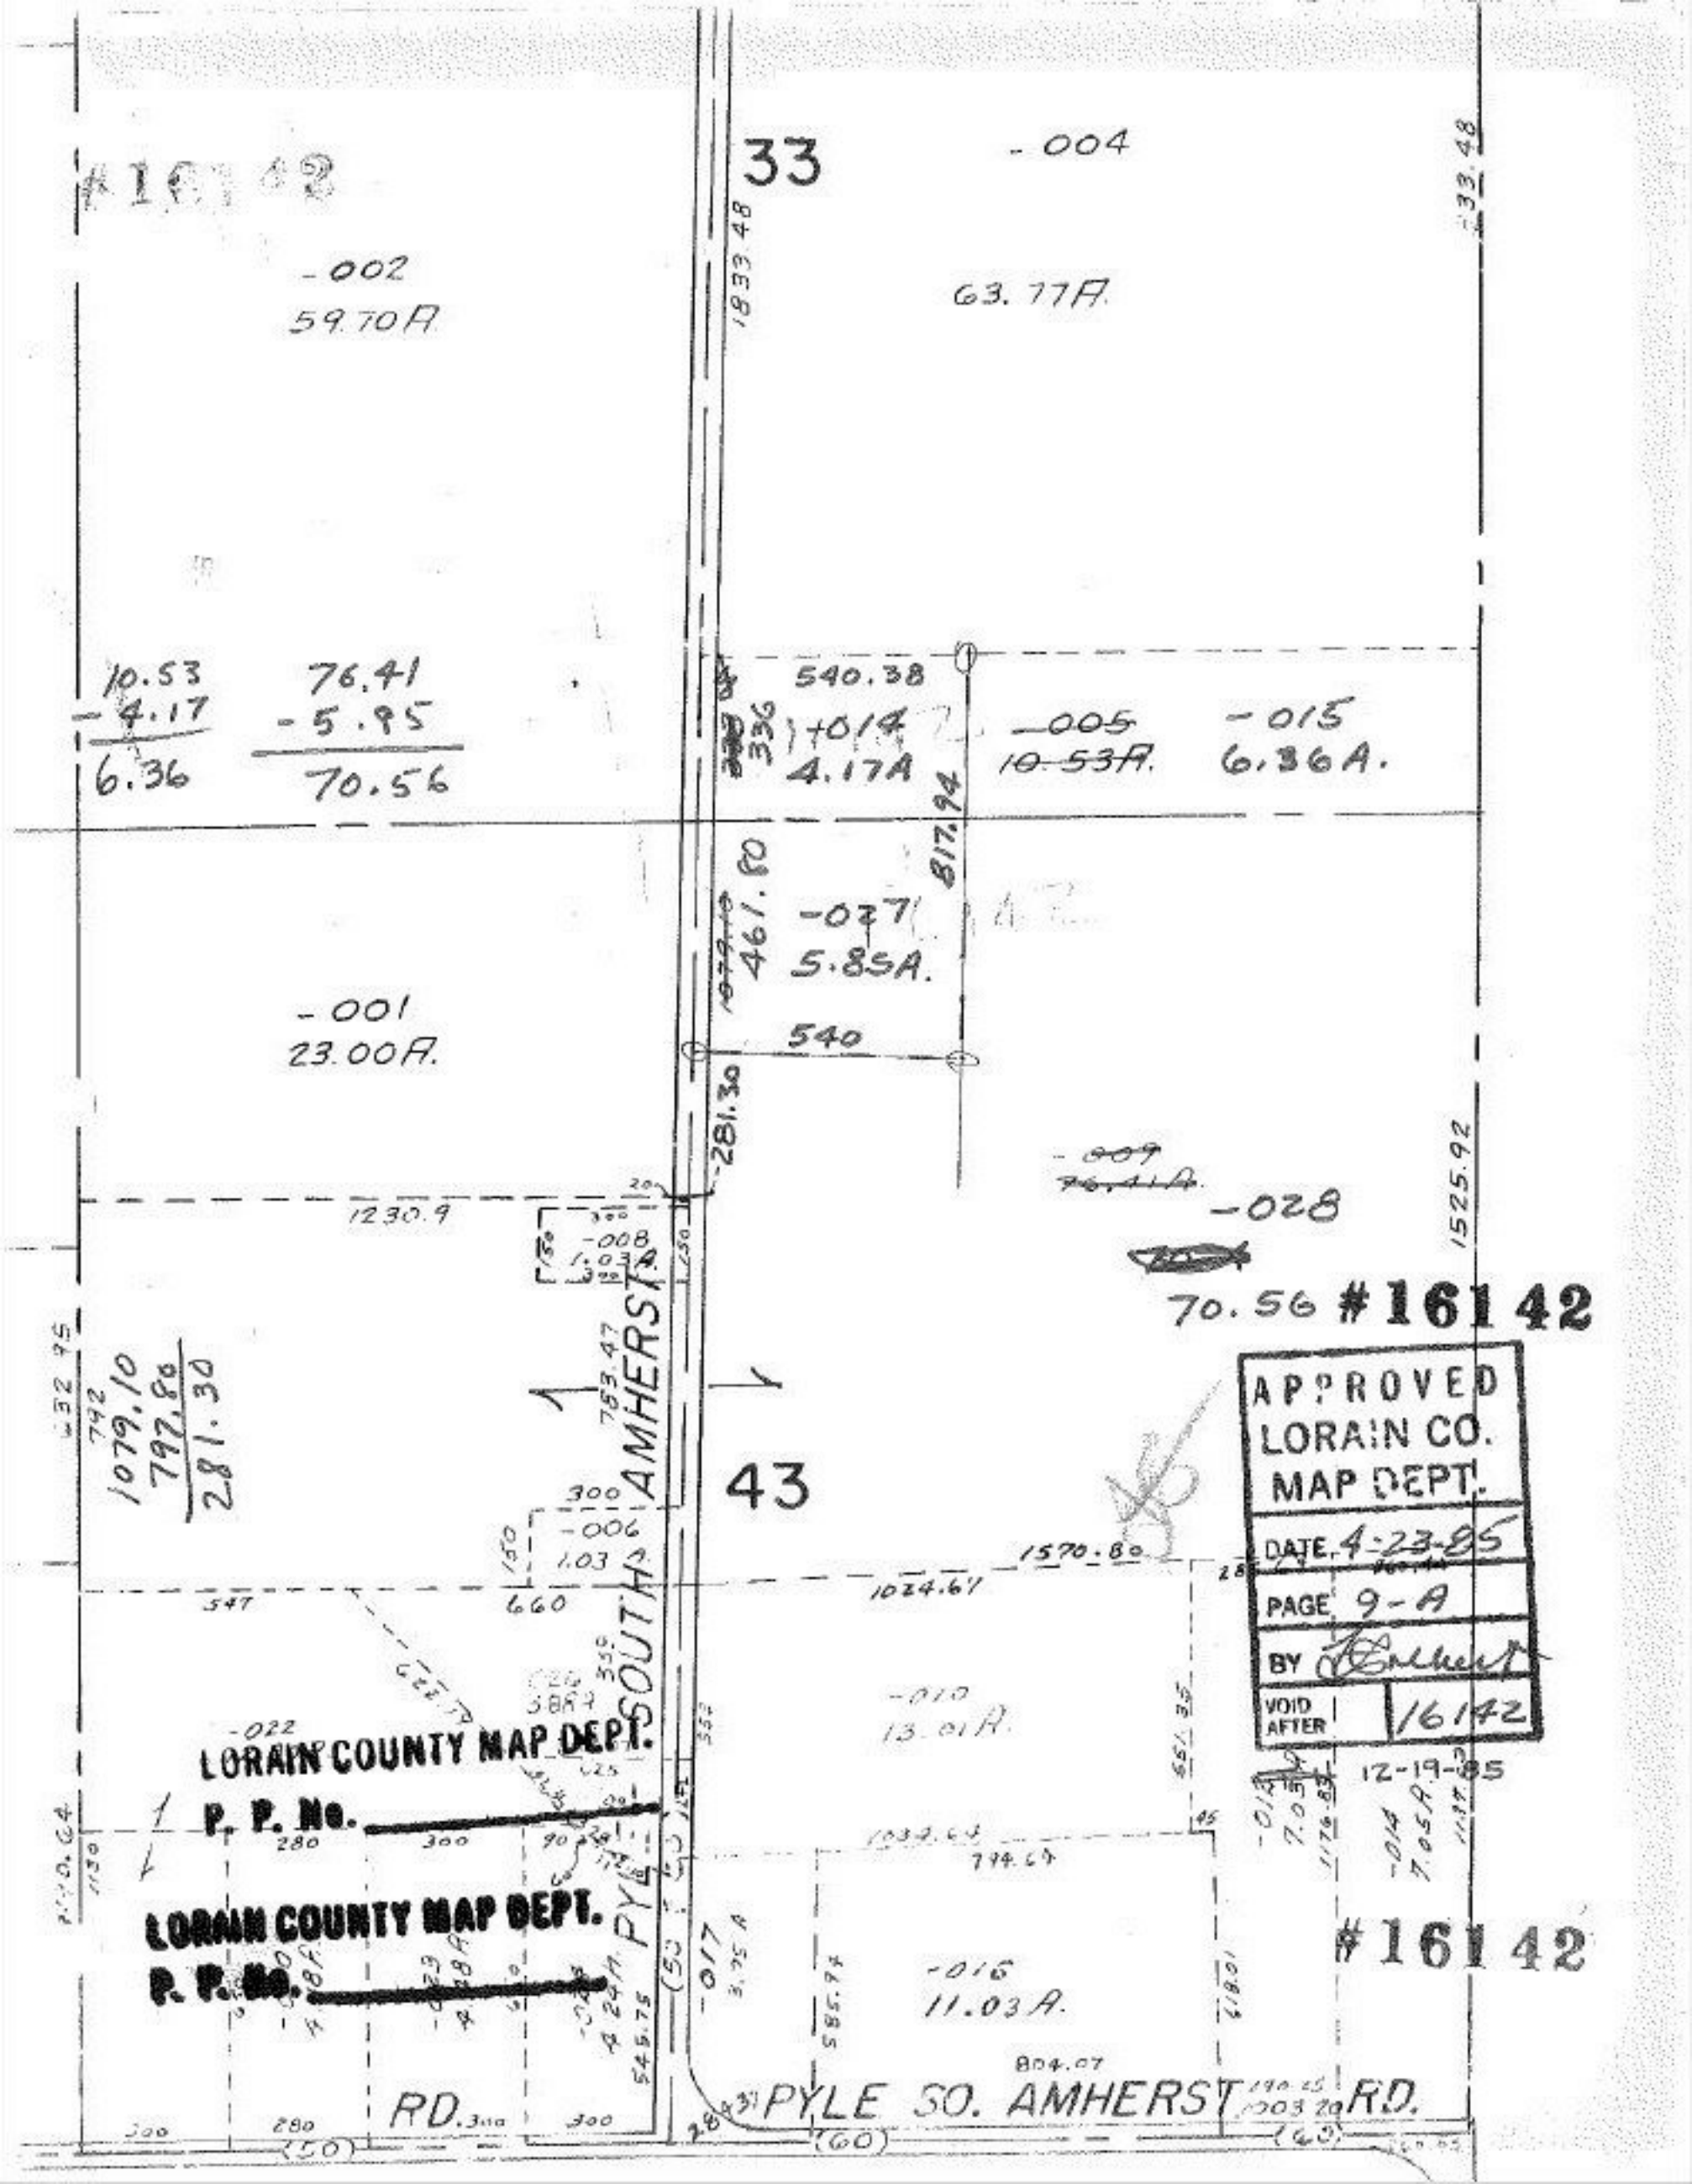

33
-004
63.77A.
-002
59.70A
1833.48
10.53
-4.17
6.36
76.41
-5.95
70.56
540.38
336
+014
4.17A
-005
10.53A.
-015
6.36A.
817.94
461.80
-027
5.85A.
540
-001
23.00A.
281.30
-009
76.41A.
-028
70.56
#16142
1230.9
-008
1.03A.
1525.92
1079.10
797.80
281.30
AMHERST
43
-006
1.03A.
1570.80
1024.67
660
-010
13.01A.
-022
LORAIN COUNTY MAP DEPT.
P. P. No.
LORAIN COUNTY MAP DEPT.
P. P. No.
12-19-85
-016
11.03A.
804.07
PYLE SO. AMHERST RD.
RD.
(50)
(60)
APPROVED
LORAIN CO.
MAP DEPT.
DATE 4-23-85
PAGE 9-A
BY
VOID AFTER 16142