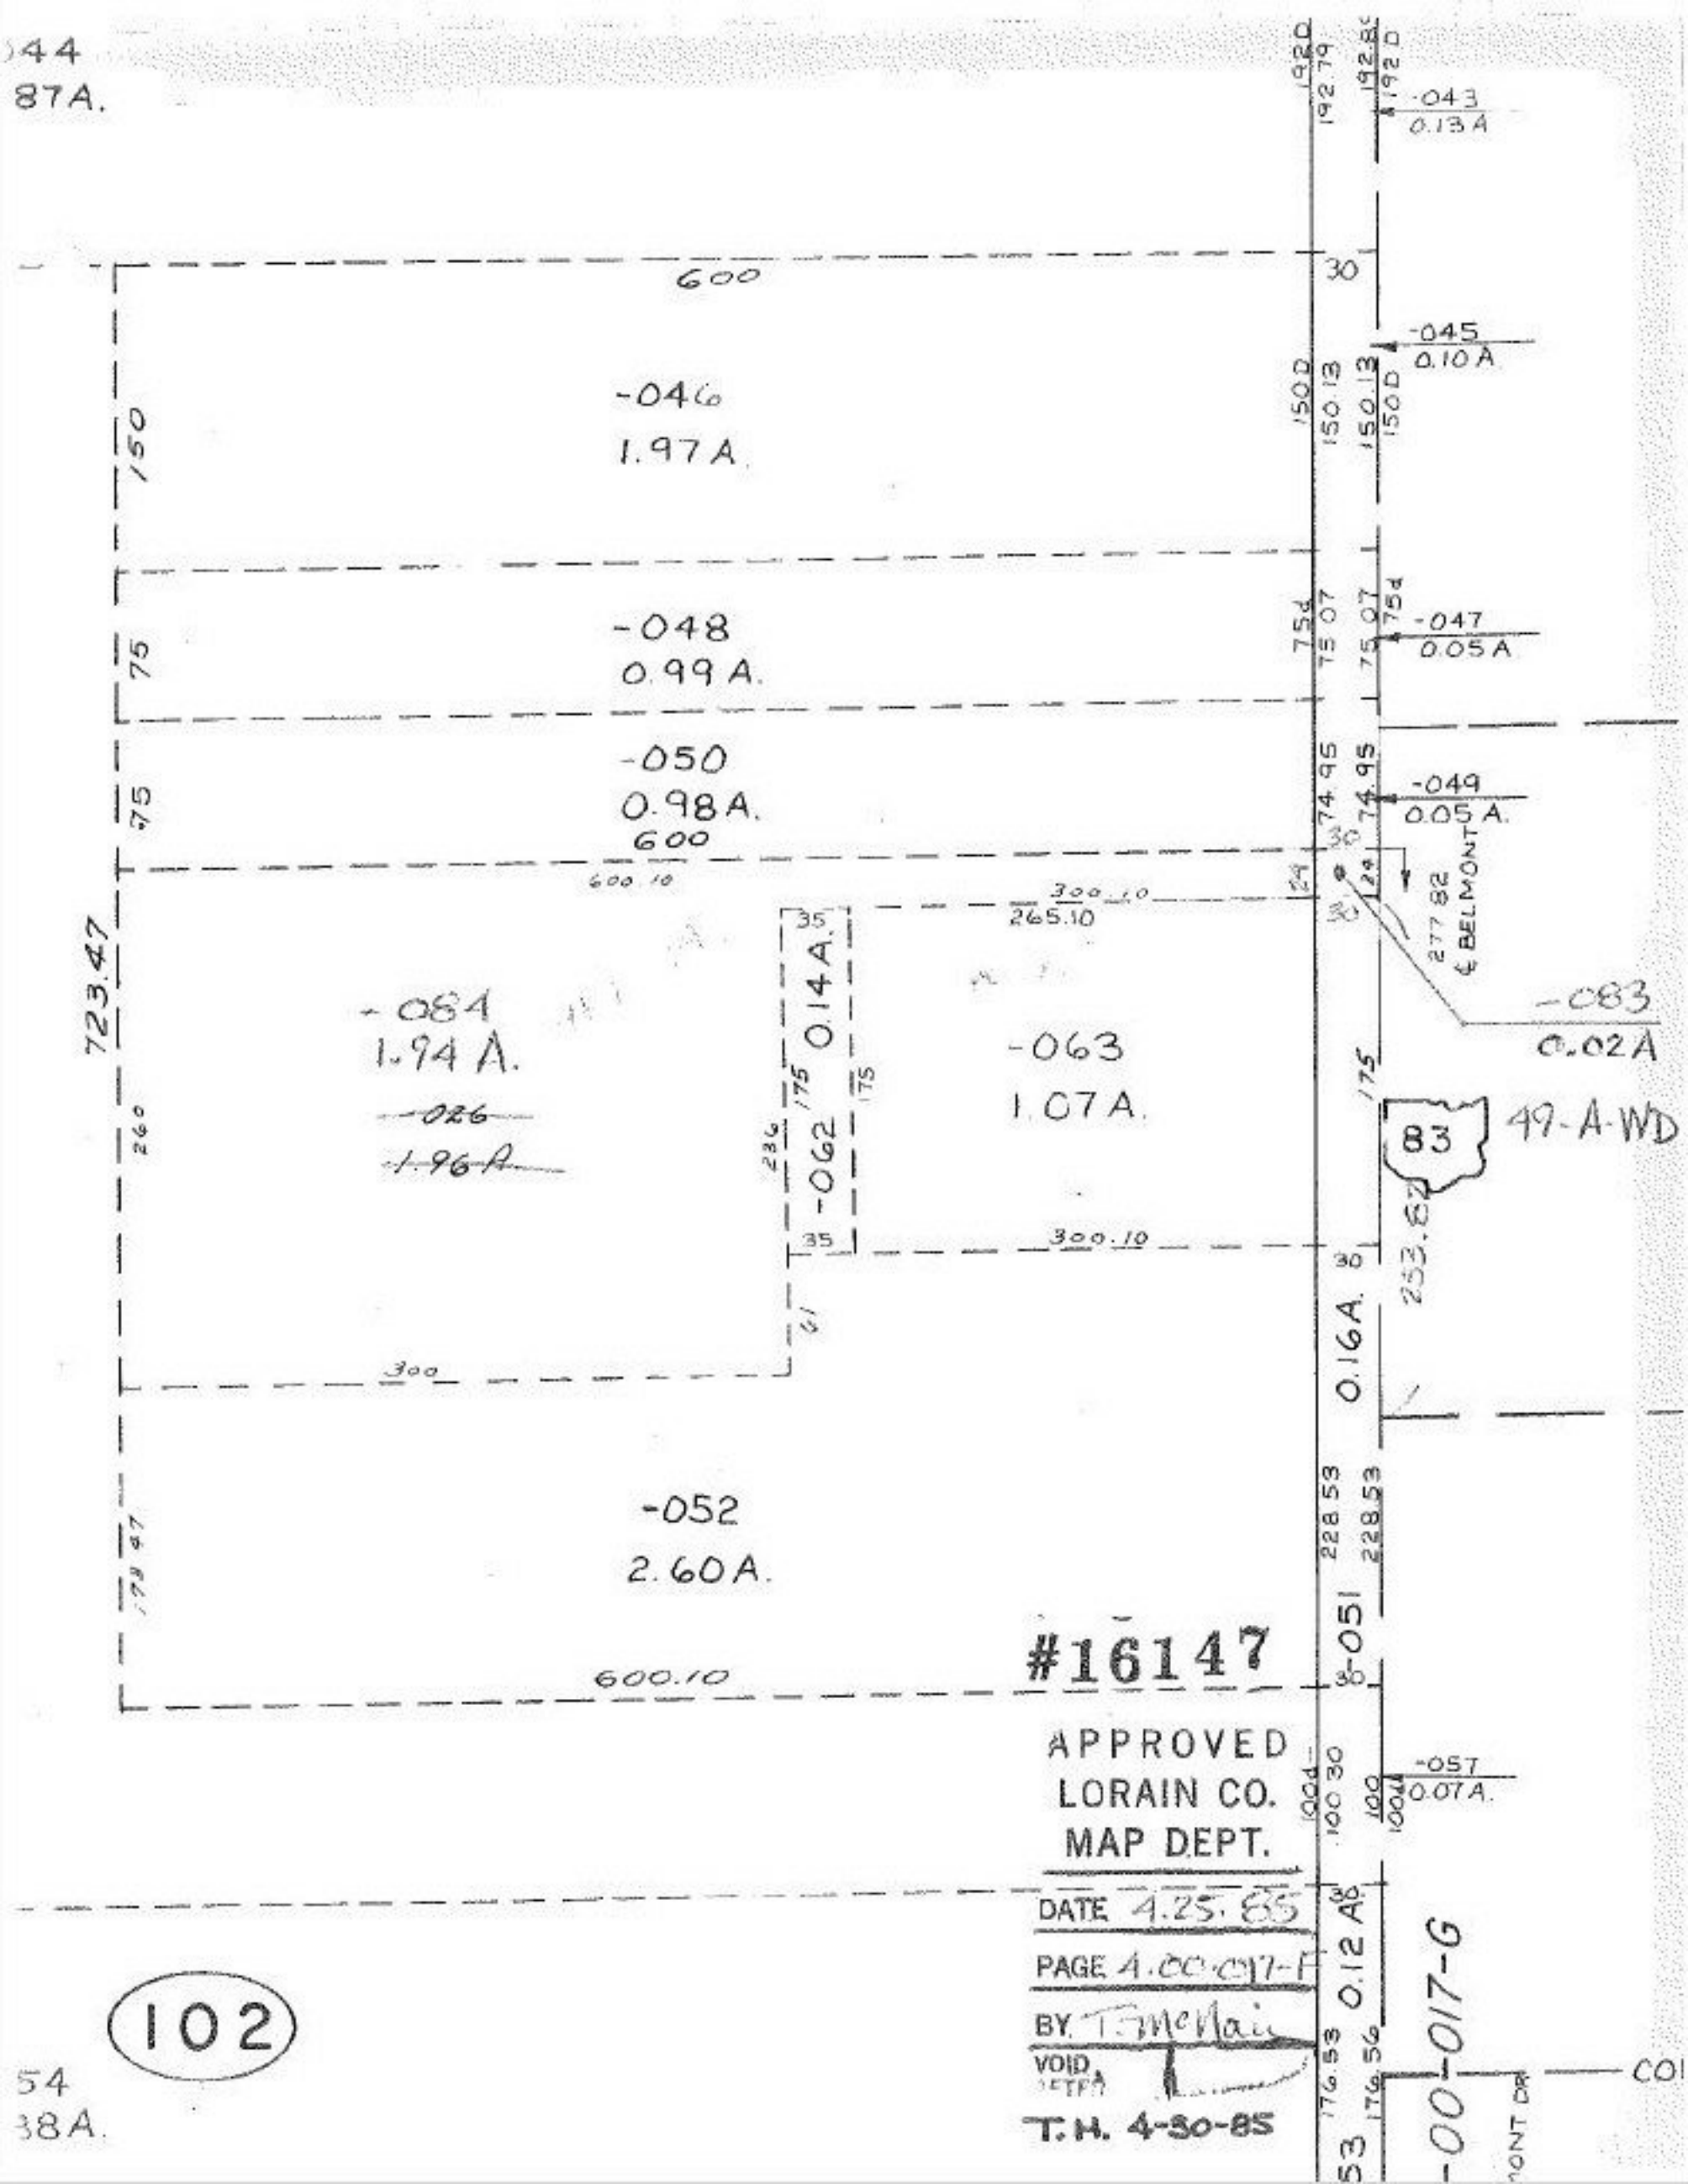

-046
1.97 A.
-048
0.99 A.
-050
0.98 A.
-084
1.94 A.
-026
1.96 A.
-062
0.14 A.
-063
1.07 A.
-052
2.60 A.
-043
0.13 A
-045
0.10 A
-047
0.05 A
-049
0.05 A.
-083
0.02 A
49-A-WD
83
0.16 A.
-051
-057
0.07 A.
0.12 A.
-00-017-G
600
150
75
75
723.47
600.10
300.10
265.10
300
300.10
600.10
277.82
℄ BELMONT
253.82
#16147
APPROVED
LORAIN CO.
MAP DEPT.
DATE 4.25.85
PAGE 4.00-017-F
BY T. McNair
VOID
T.H. 4-30-85
102