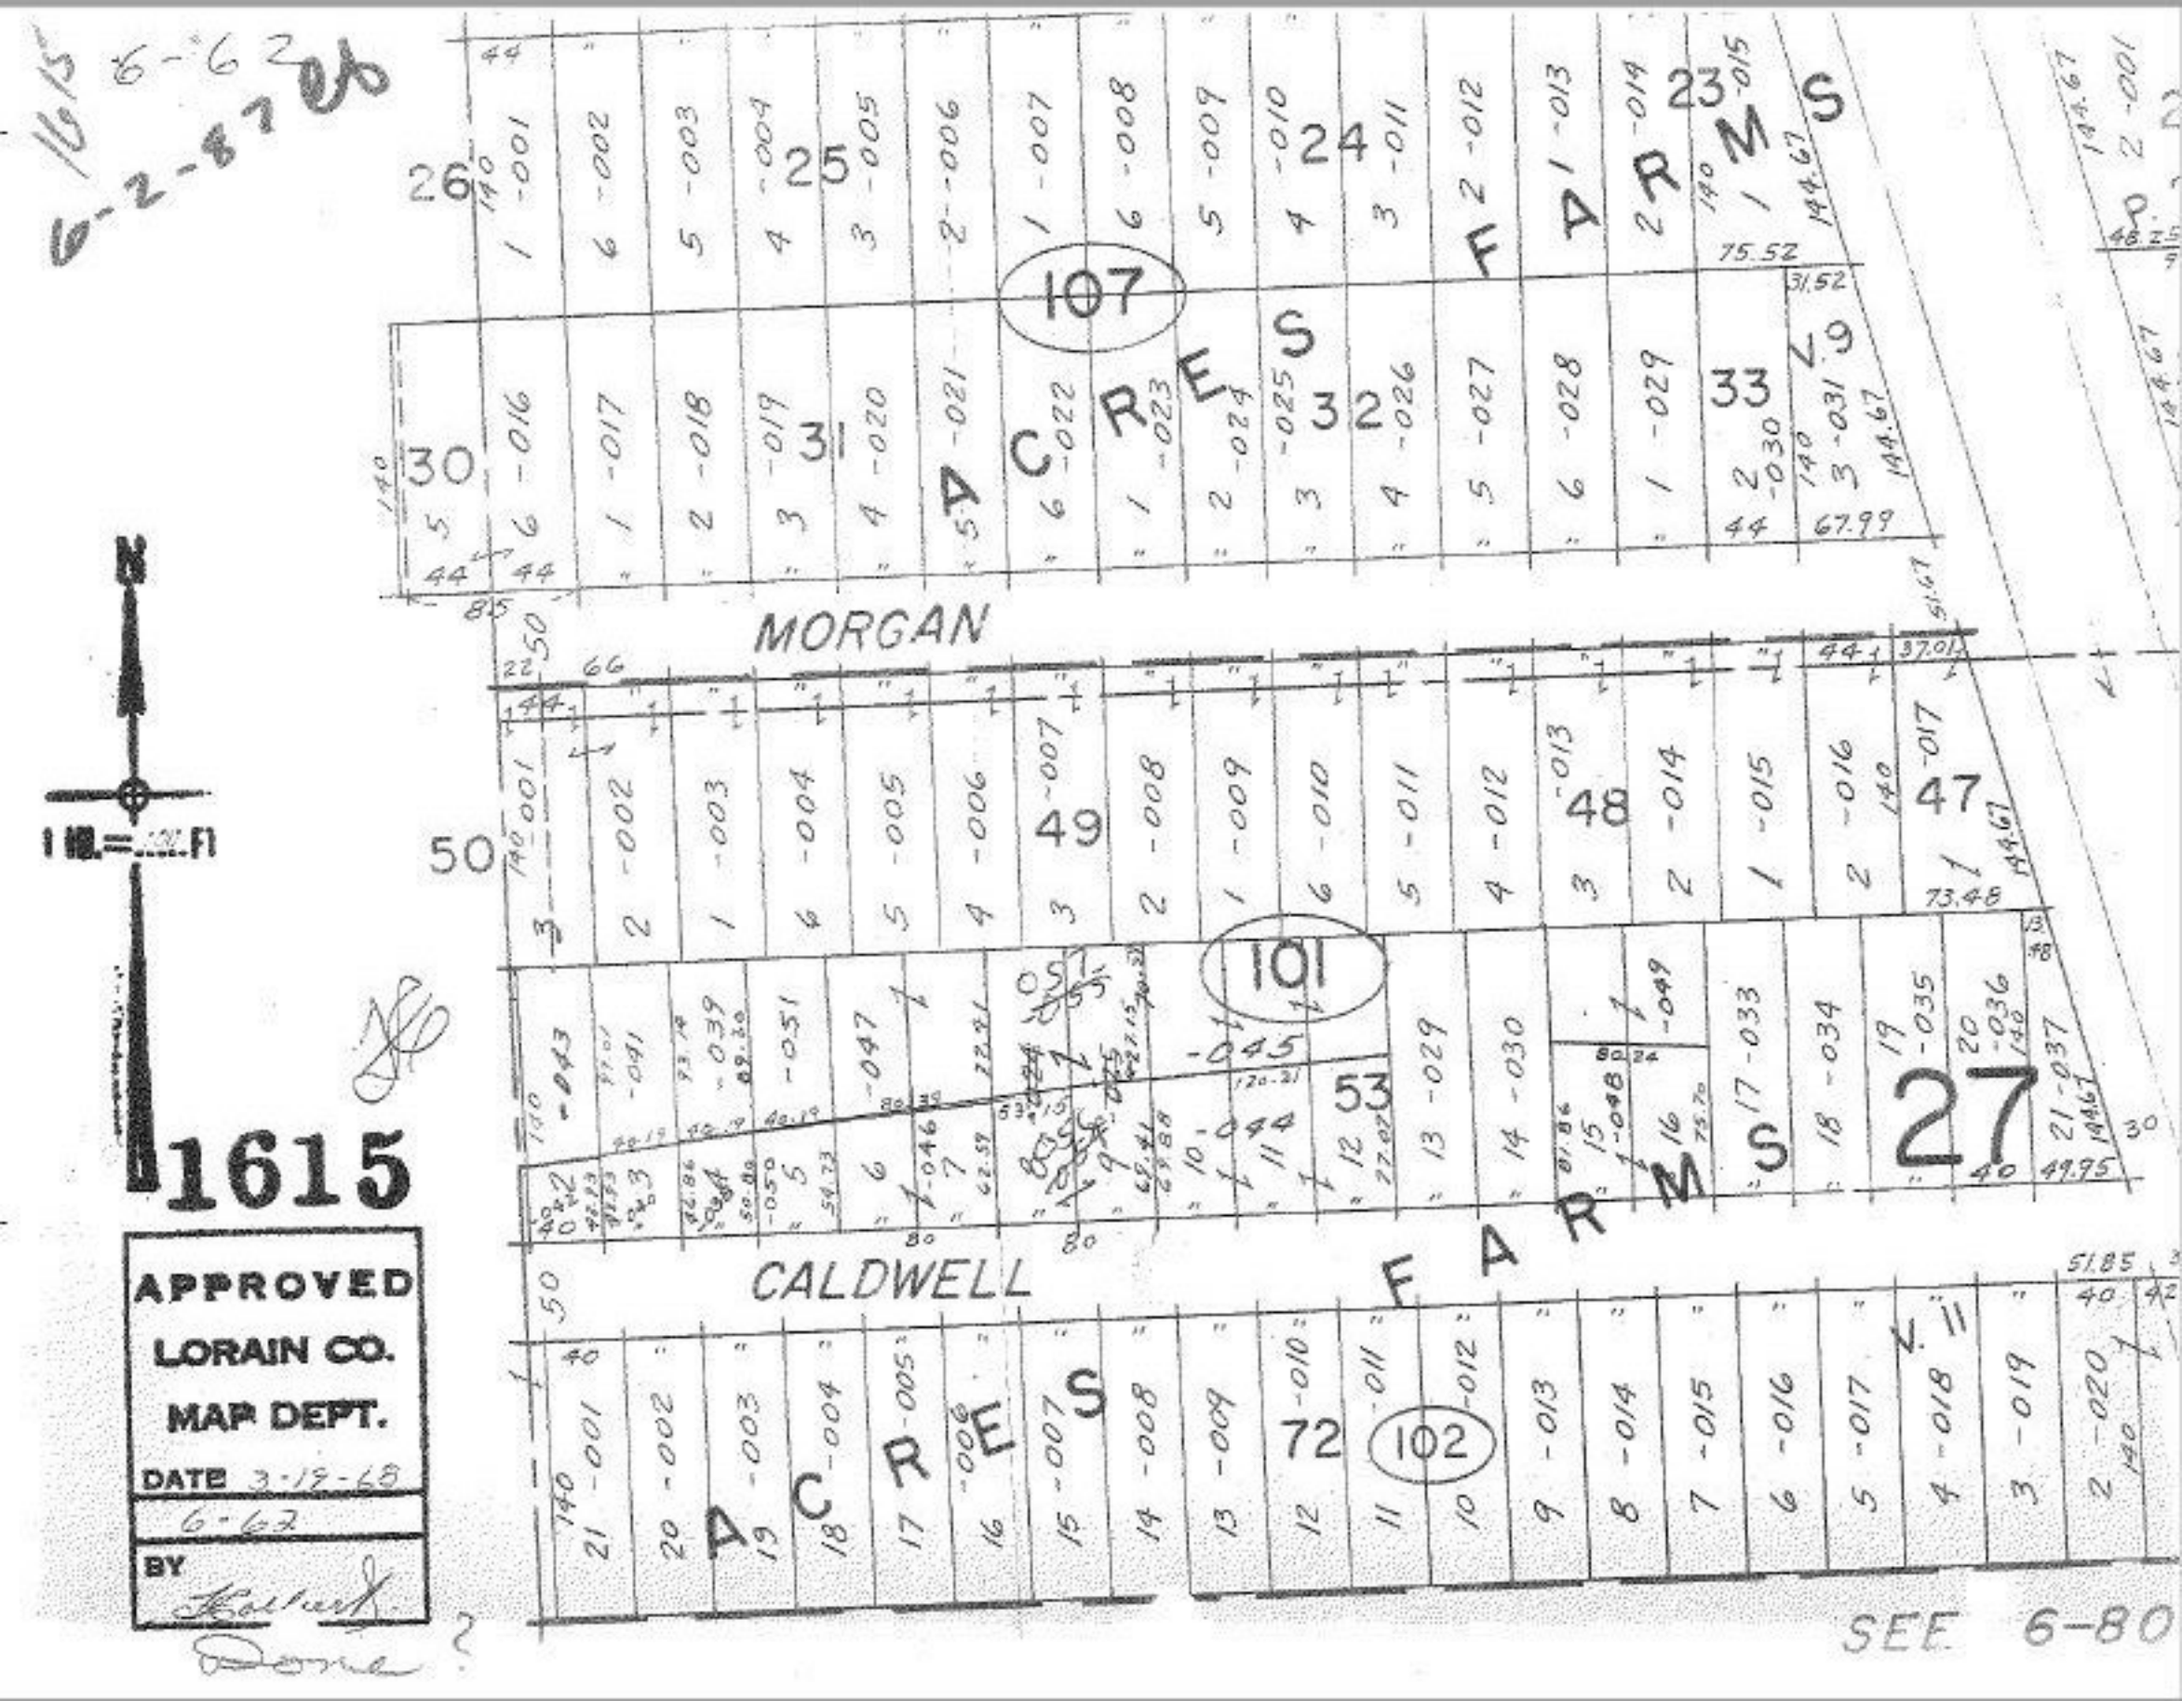
1615
6-62
6-2-87
MORGAN
CALDWELL
ACRES FARMS
107
101
102
N
1615
APPROVED
LORAIN CO.
MAP DEPT.
DATE 3-19-68
6-62
BY
Done ?
SEE 6-80