3.26
2.26
.41
5.93

COMBINATION

#16155

APPROVED
LORAIN CO.
MAP DEPT.
DATE 5-6-85
PAGE 3-00-096 B
BY [signature]
VOID AFTER 16155

T.M.
7.31.85
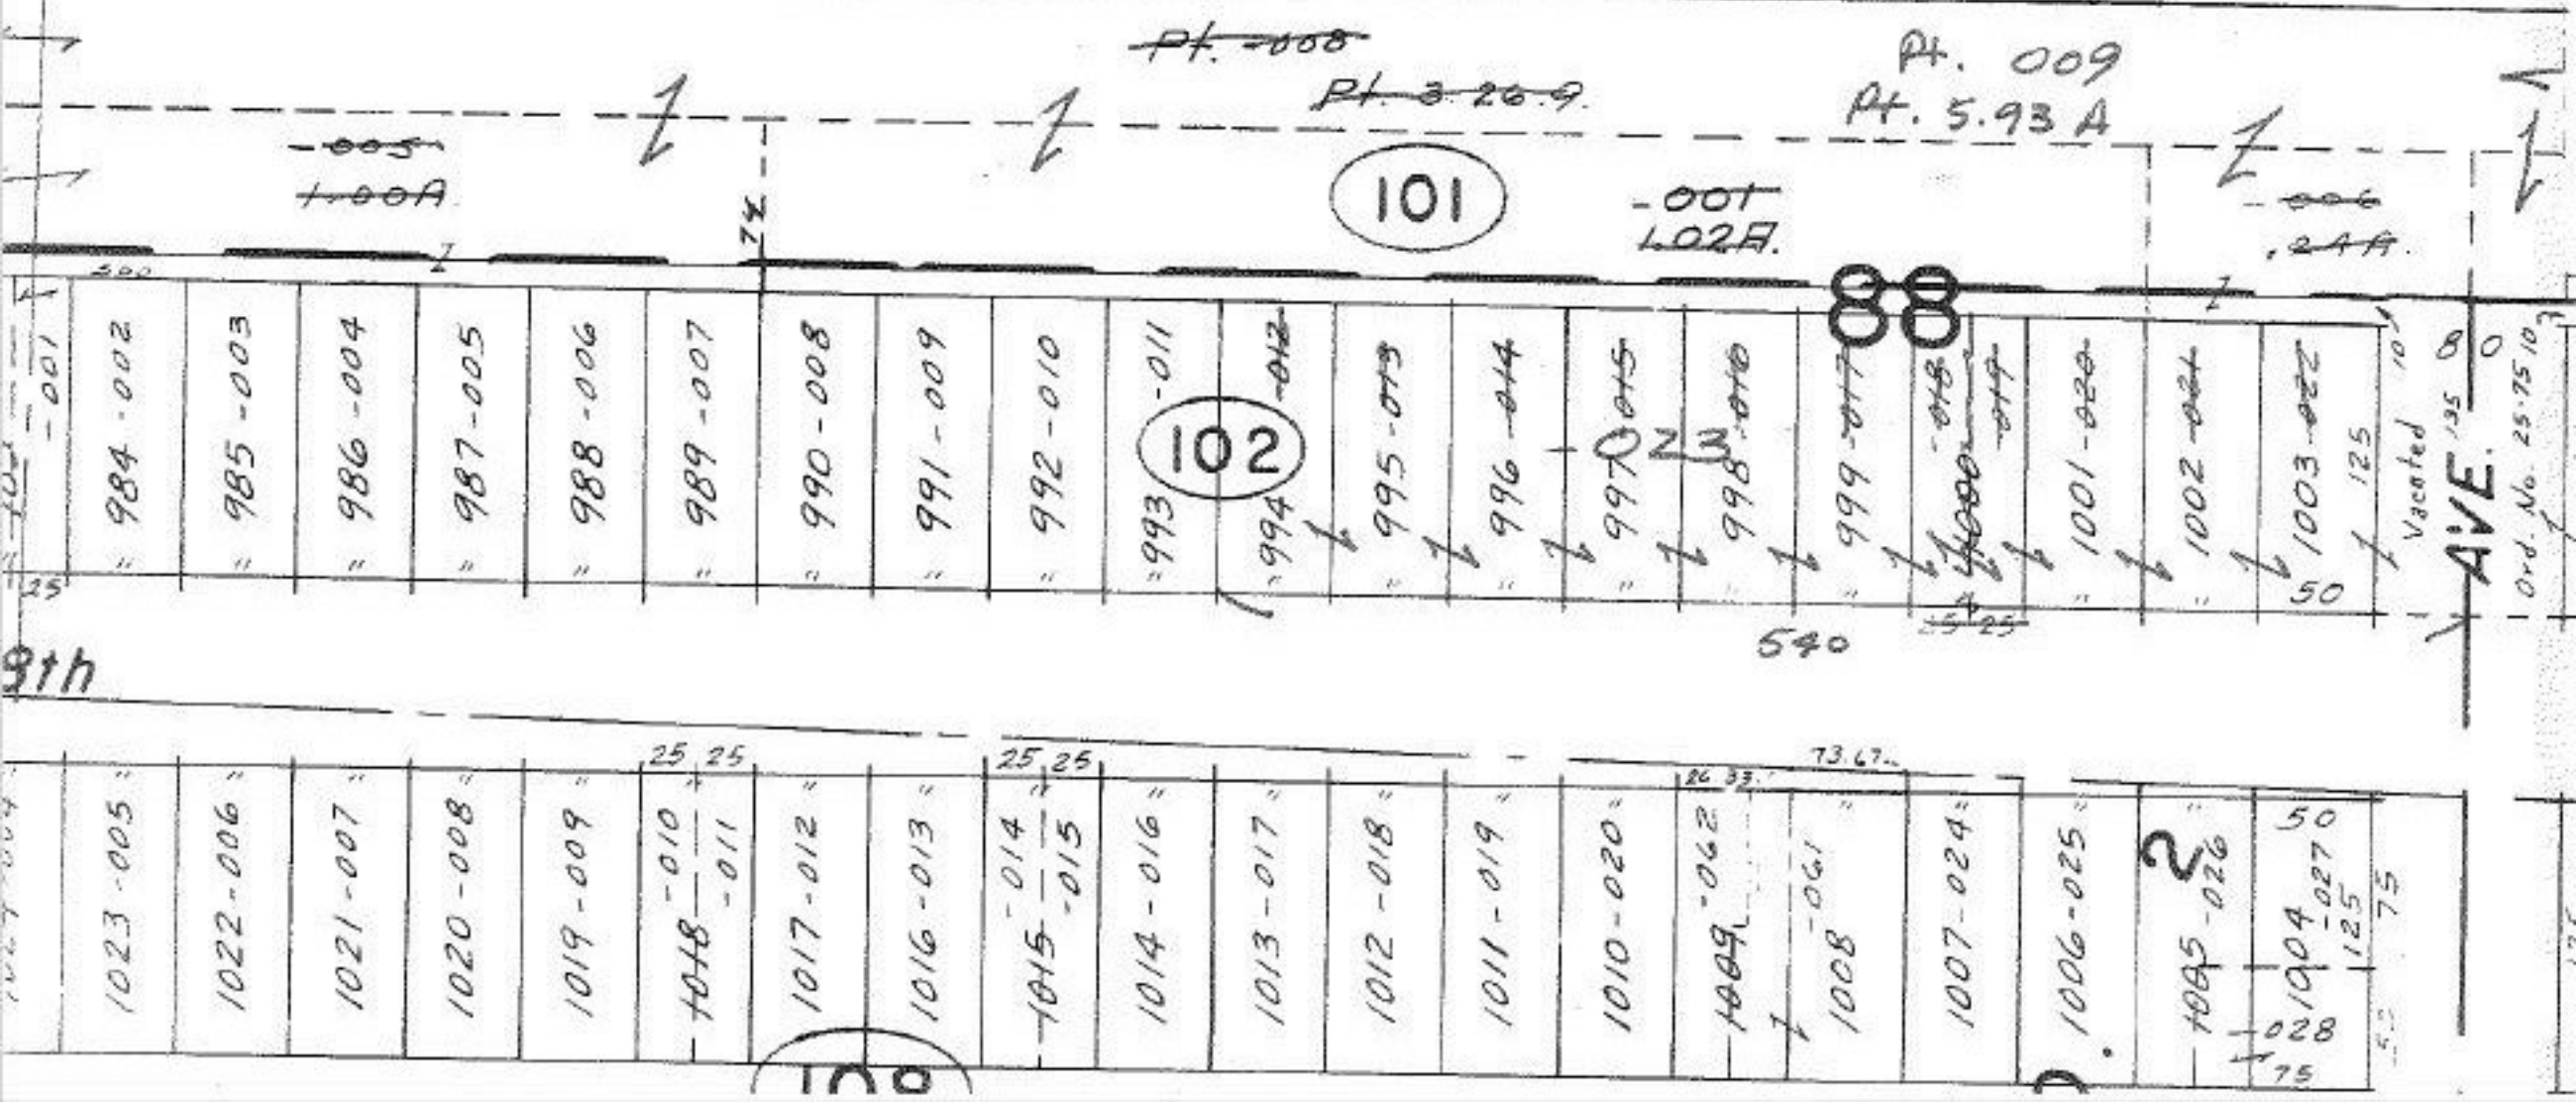
SEE 3-E