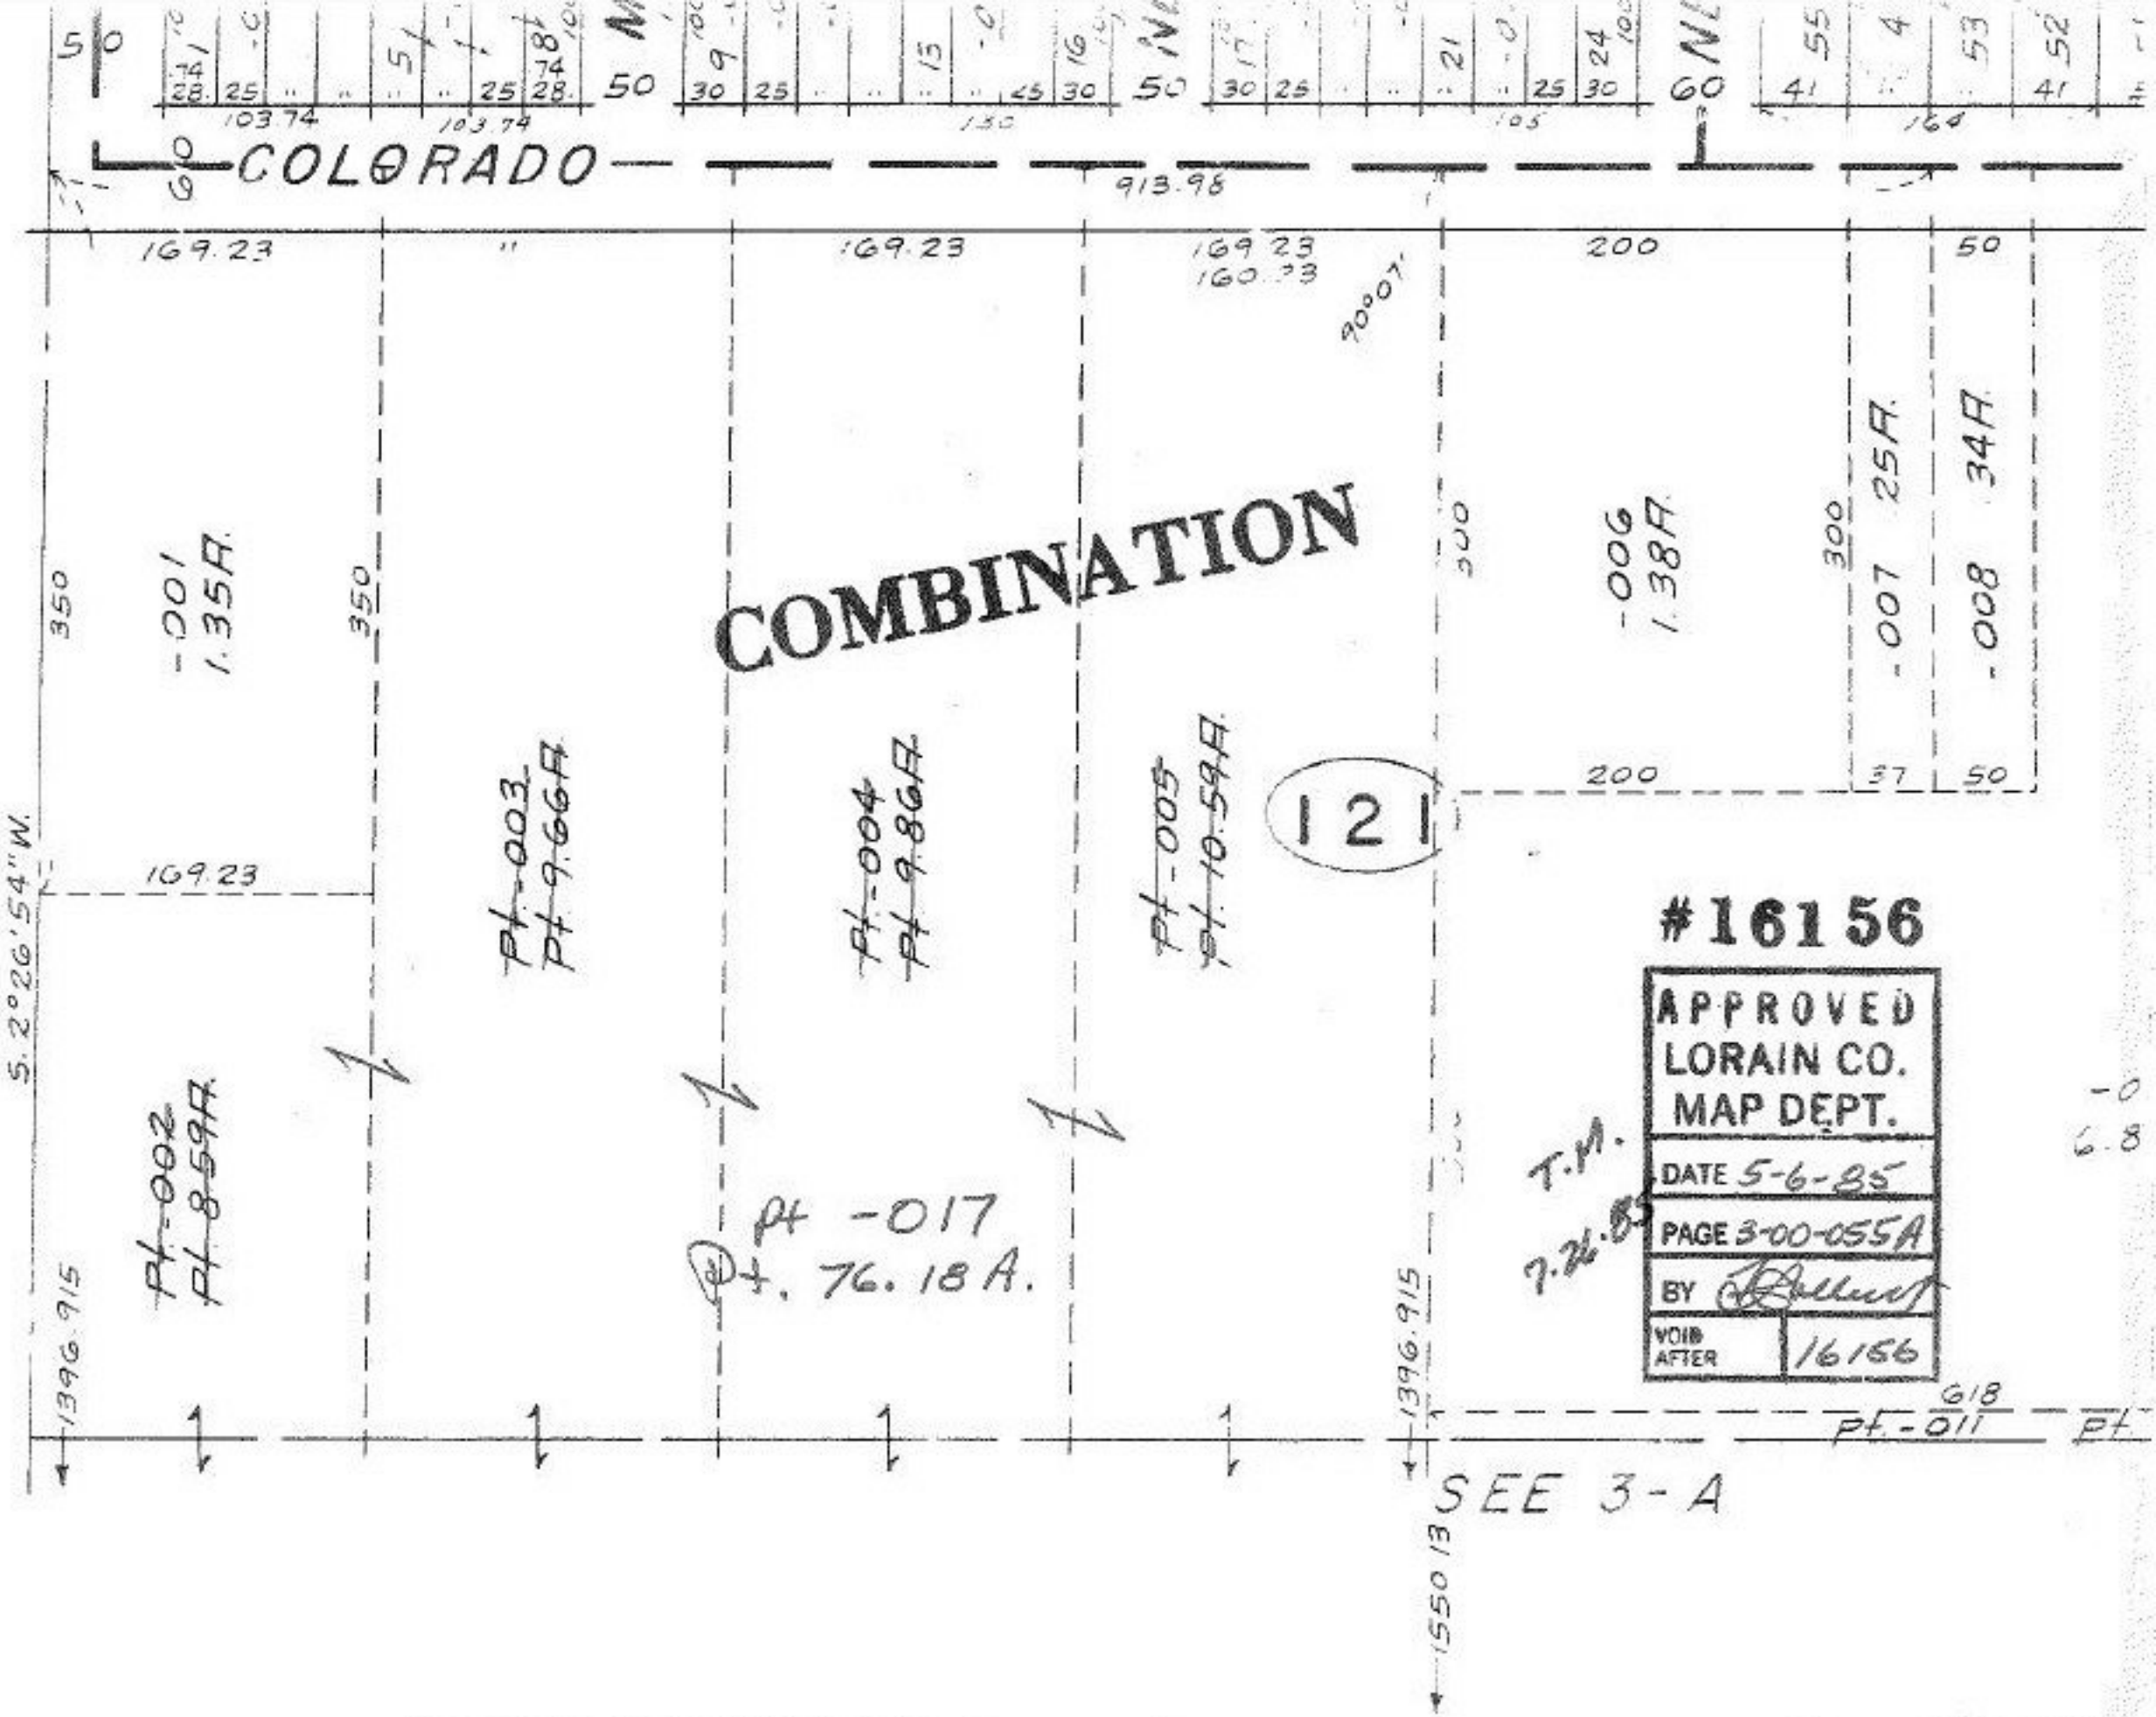
COLORADO
913.98
169.23
169.23
169.23
160.23
200
50
90°07'
COMBINATION
-001
1.35A.
350
350
-006
1.38A.
300
300
-007 25A.
-008 34A.
200
37
50
121
Pt-003
Pt 9.66A
Pt-004
Pt 9.86A
Pt-005
Pt 10.59A
169.23
S. 2°26'54" W.
Pt-002
Pt 8.59A
Pt -017
Pt. 76.18 A.
1396.915
1396.915
618
Pt-011
Pt
SEE 3-A
1550.13
#16156
APPROVED
LORAIN CO.
MAP DEPT.
DATE 5-6-85
PAGE 3-00-055A
BY
VOID AFTER 16156
T.M.
7.26.85