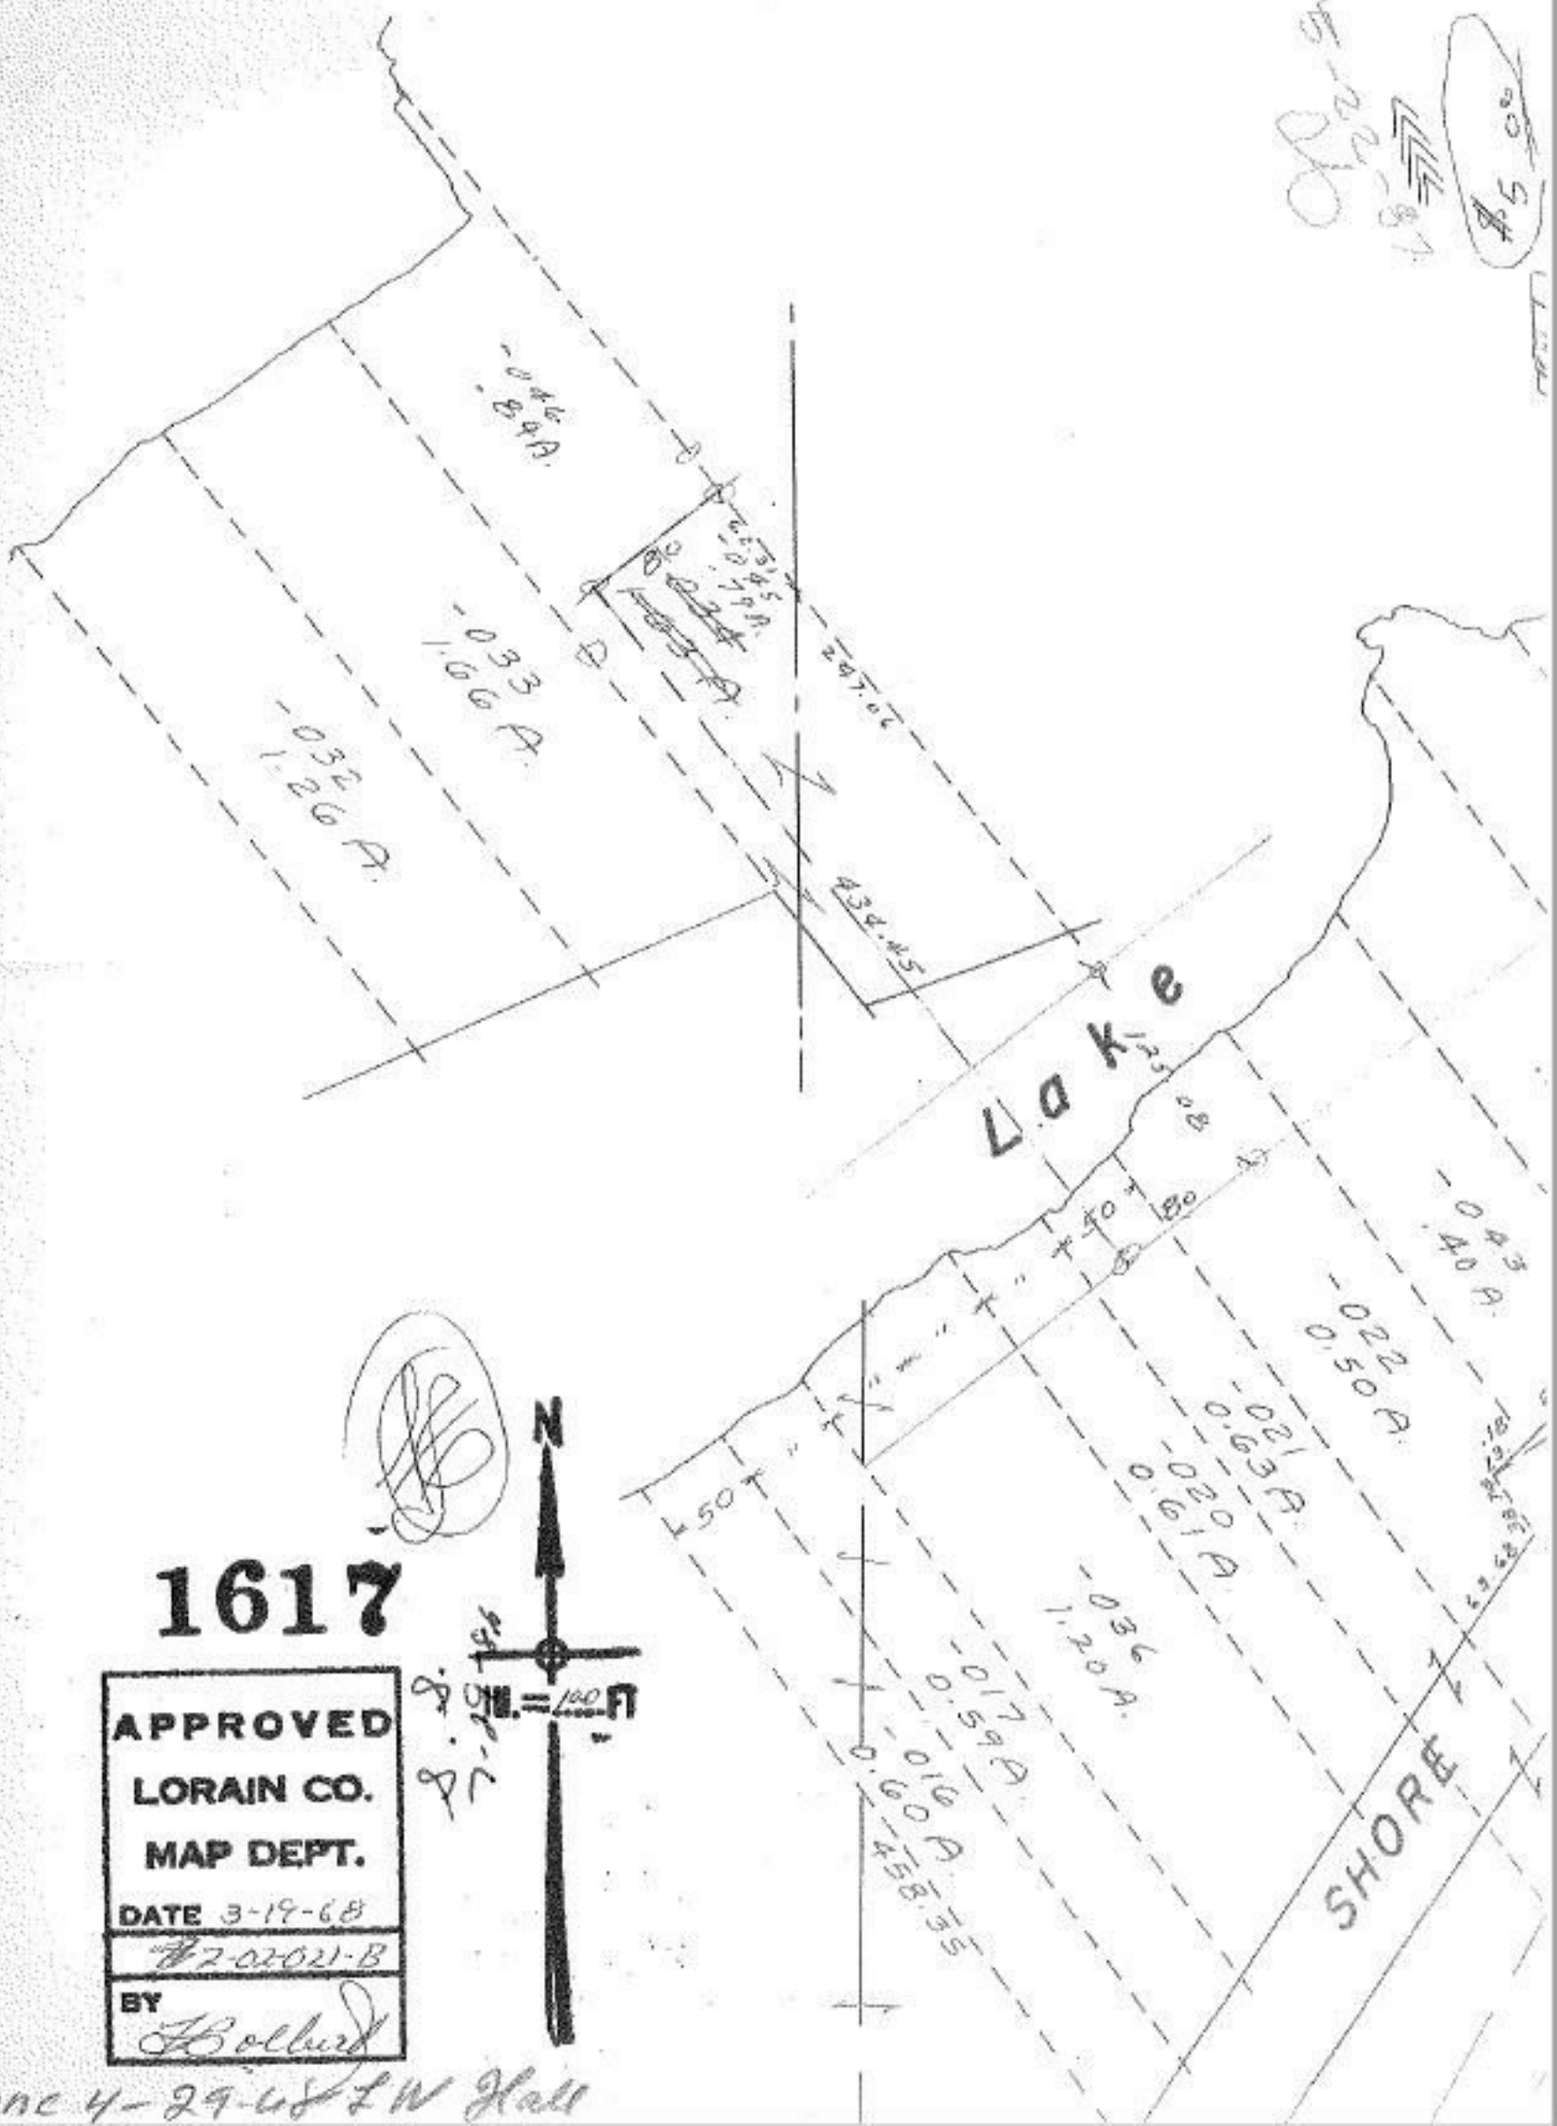

-046
.89A.
-033
1.66 A.
-032
1.26 A.
247.06
434.45
Lake
125.08
-043
.40 A.
-022
0.50 A.
-021
0.63 A.
-020
0.61 A.
-036
1.20 A.
-017
0.59 A.
-016
0.60 A.
458.35
SHORE
N
1617
APPROVED
LORAIN CO.
MAP DEPT.
DATE 3-19-68
#2-02-021-B
BY
Bolbert
Done 4-29-68 LW Hall