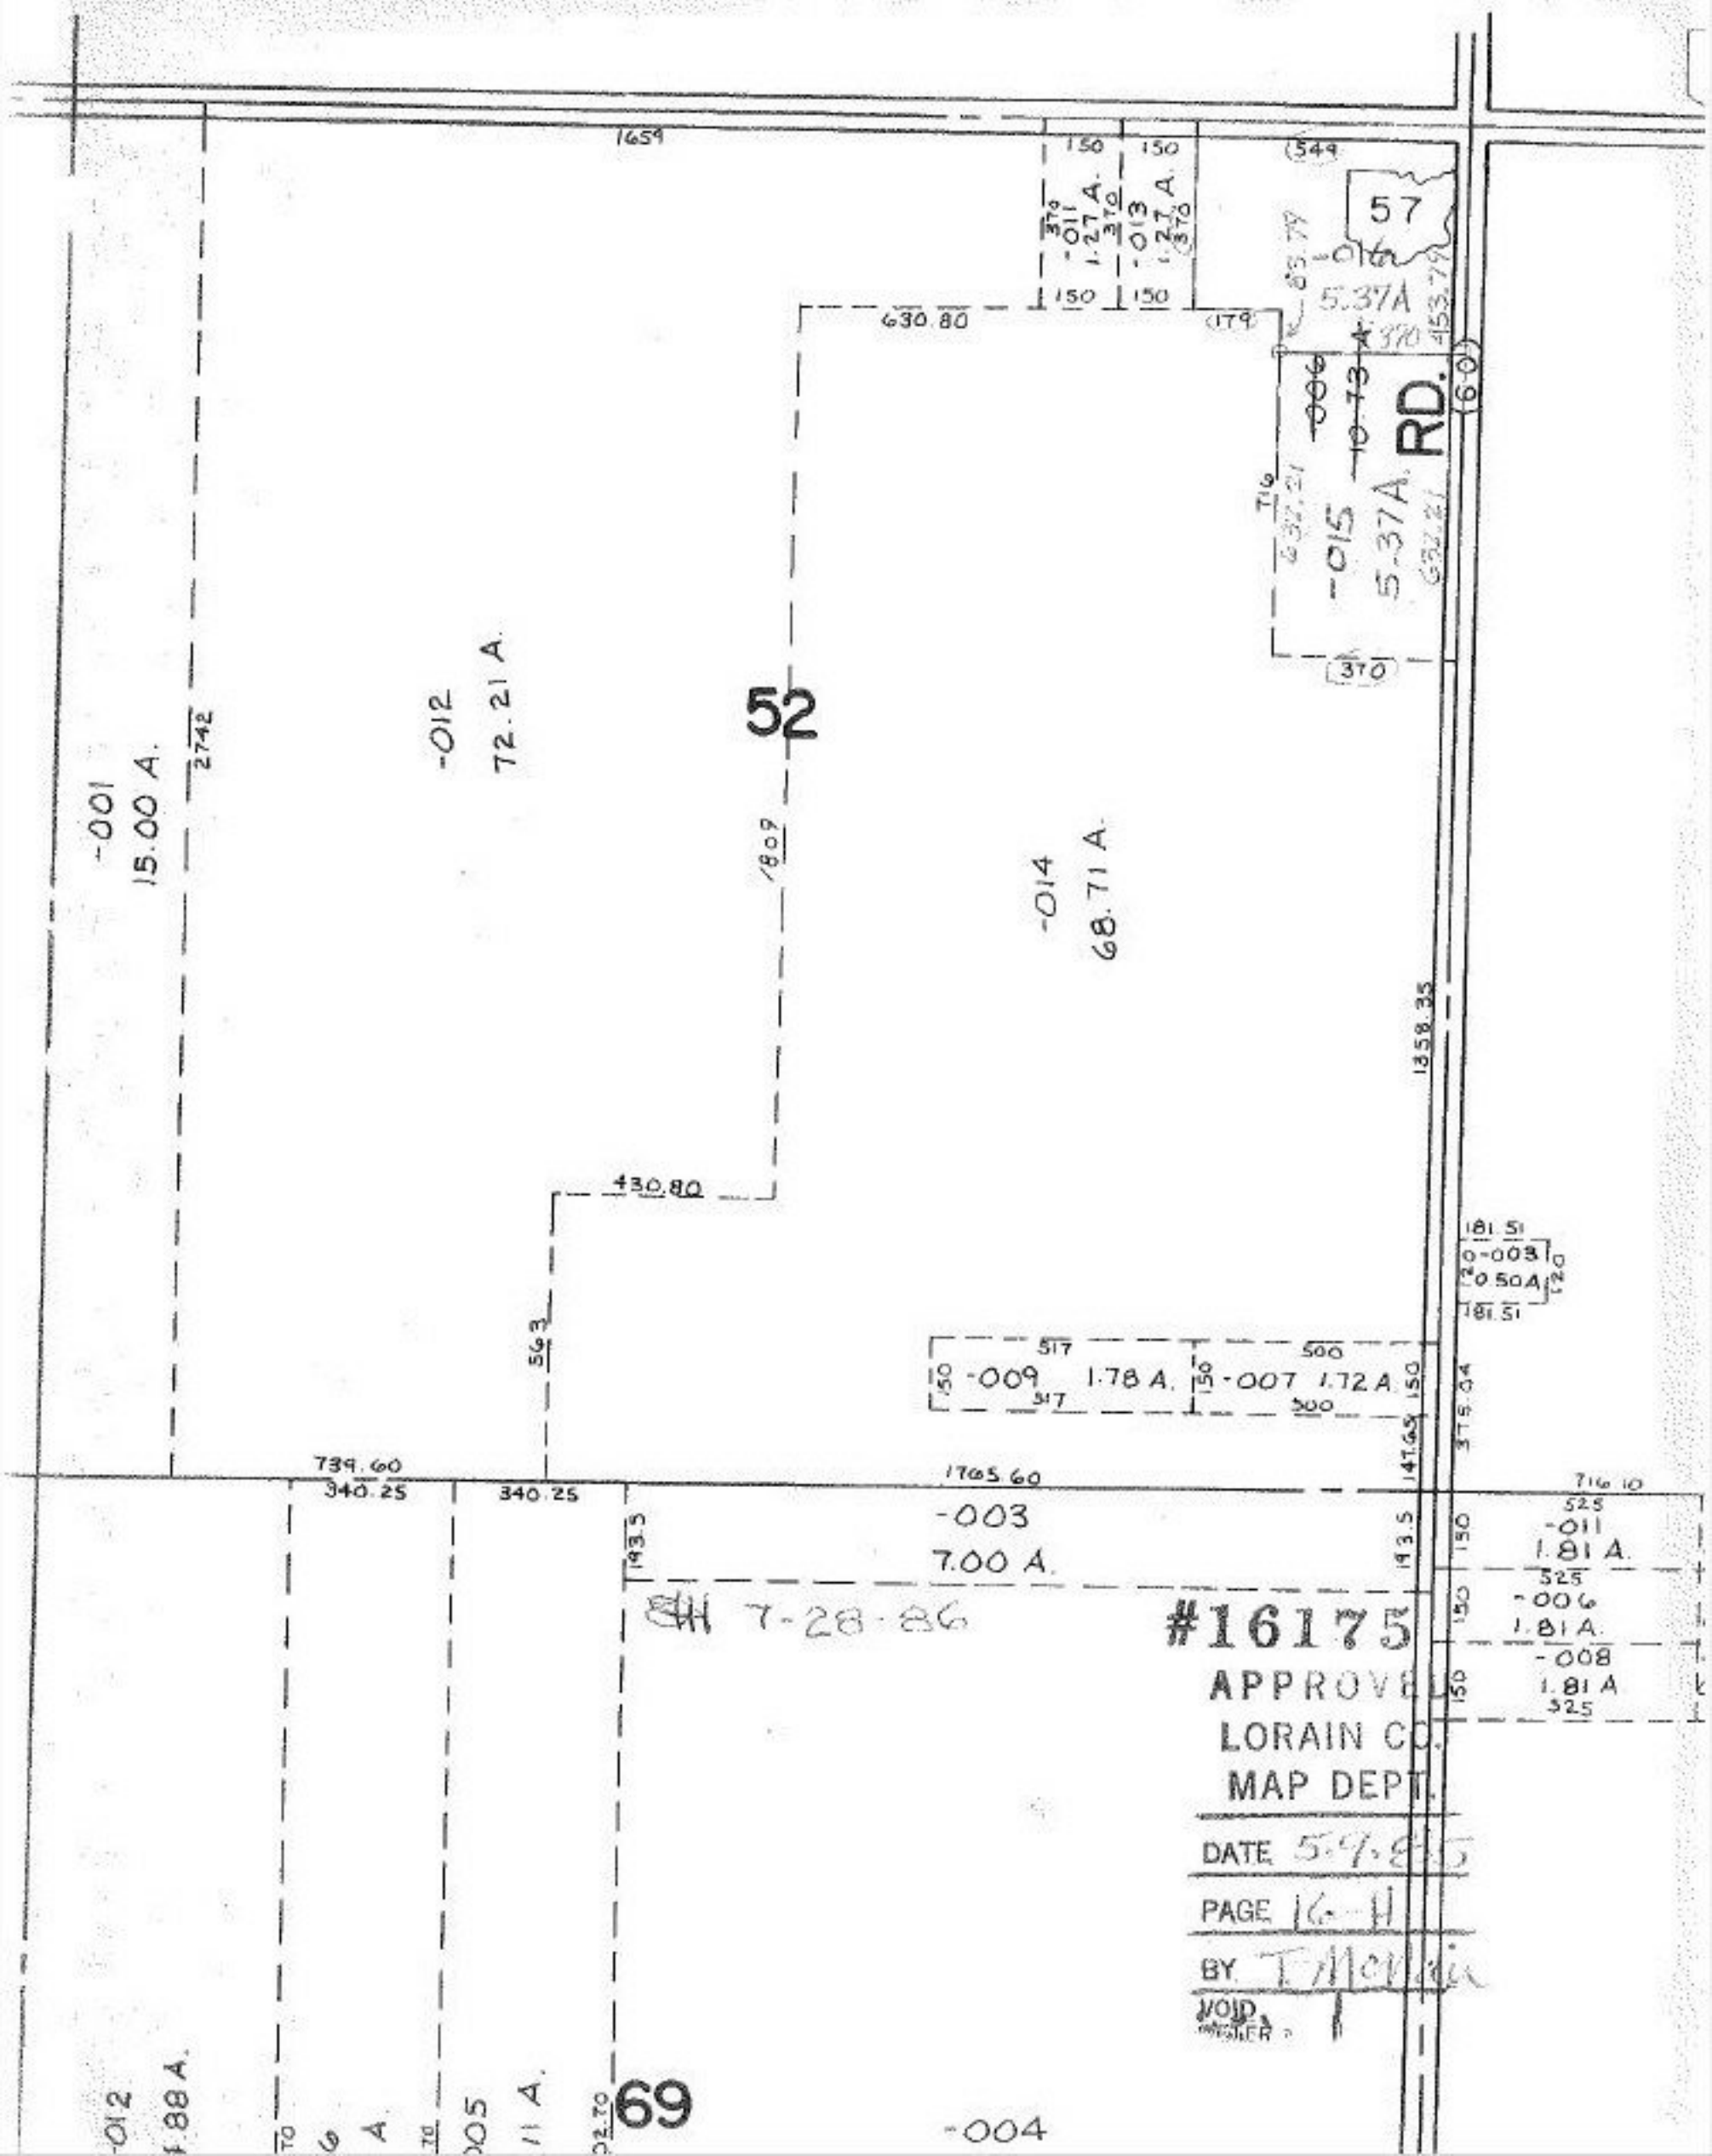

1659
150
150
549
57
-011
1.27 A.
-013
1.27 A.
-016
5.37A
630.80
179
-006
10.73 A.
RD.
60
-015
5.37A.
716
632.21
370
52
-012
72.21 A.
-001
15.00 A.
2742
1809
-014
68.71 A.
1358.35
430.80
181.51
-003
0.50A
563
517
500
-009
1.78 A.
-007
1.72 A.
375.04
147.65
739.60
340.25
340.25
1765.60
716.10
-003
7.00 A.
193.5
525
-011
1.81 A.
-006
1.81 A.
-008
1.81 A
7-28-86
#16175
APPROVED
LORAIN CO.
MAP DEPT.
DATE 5-9-85
PAGE 16-H
BY T. McNair
VOID
69
-004