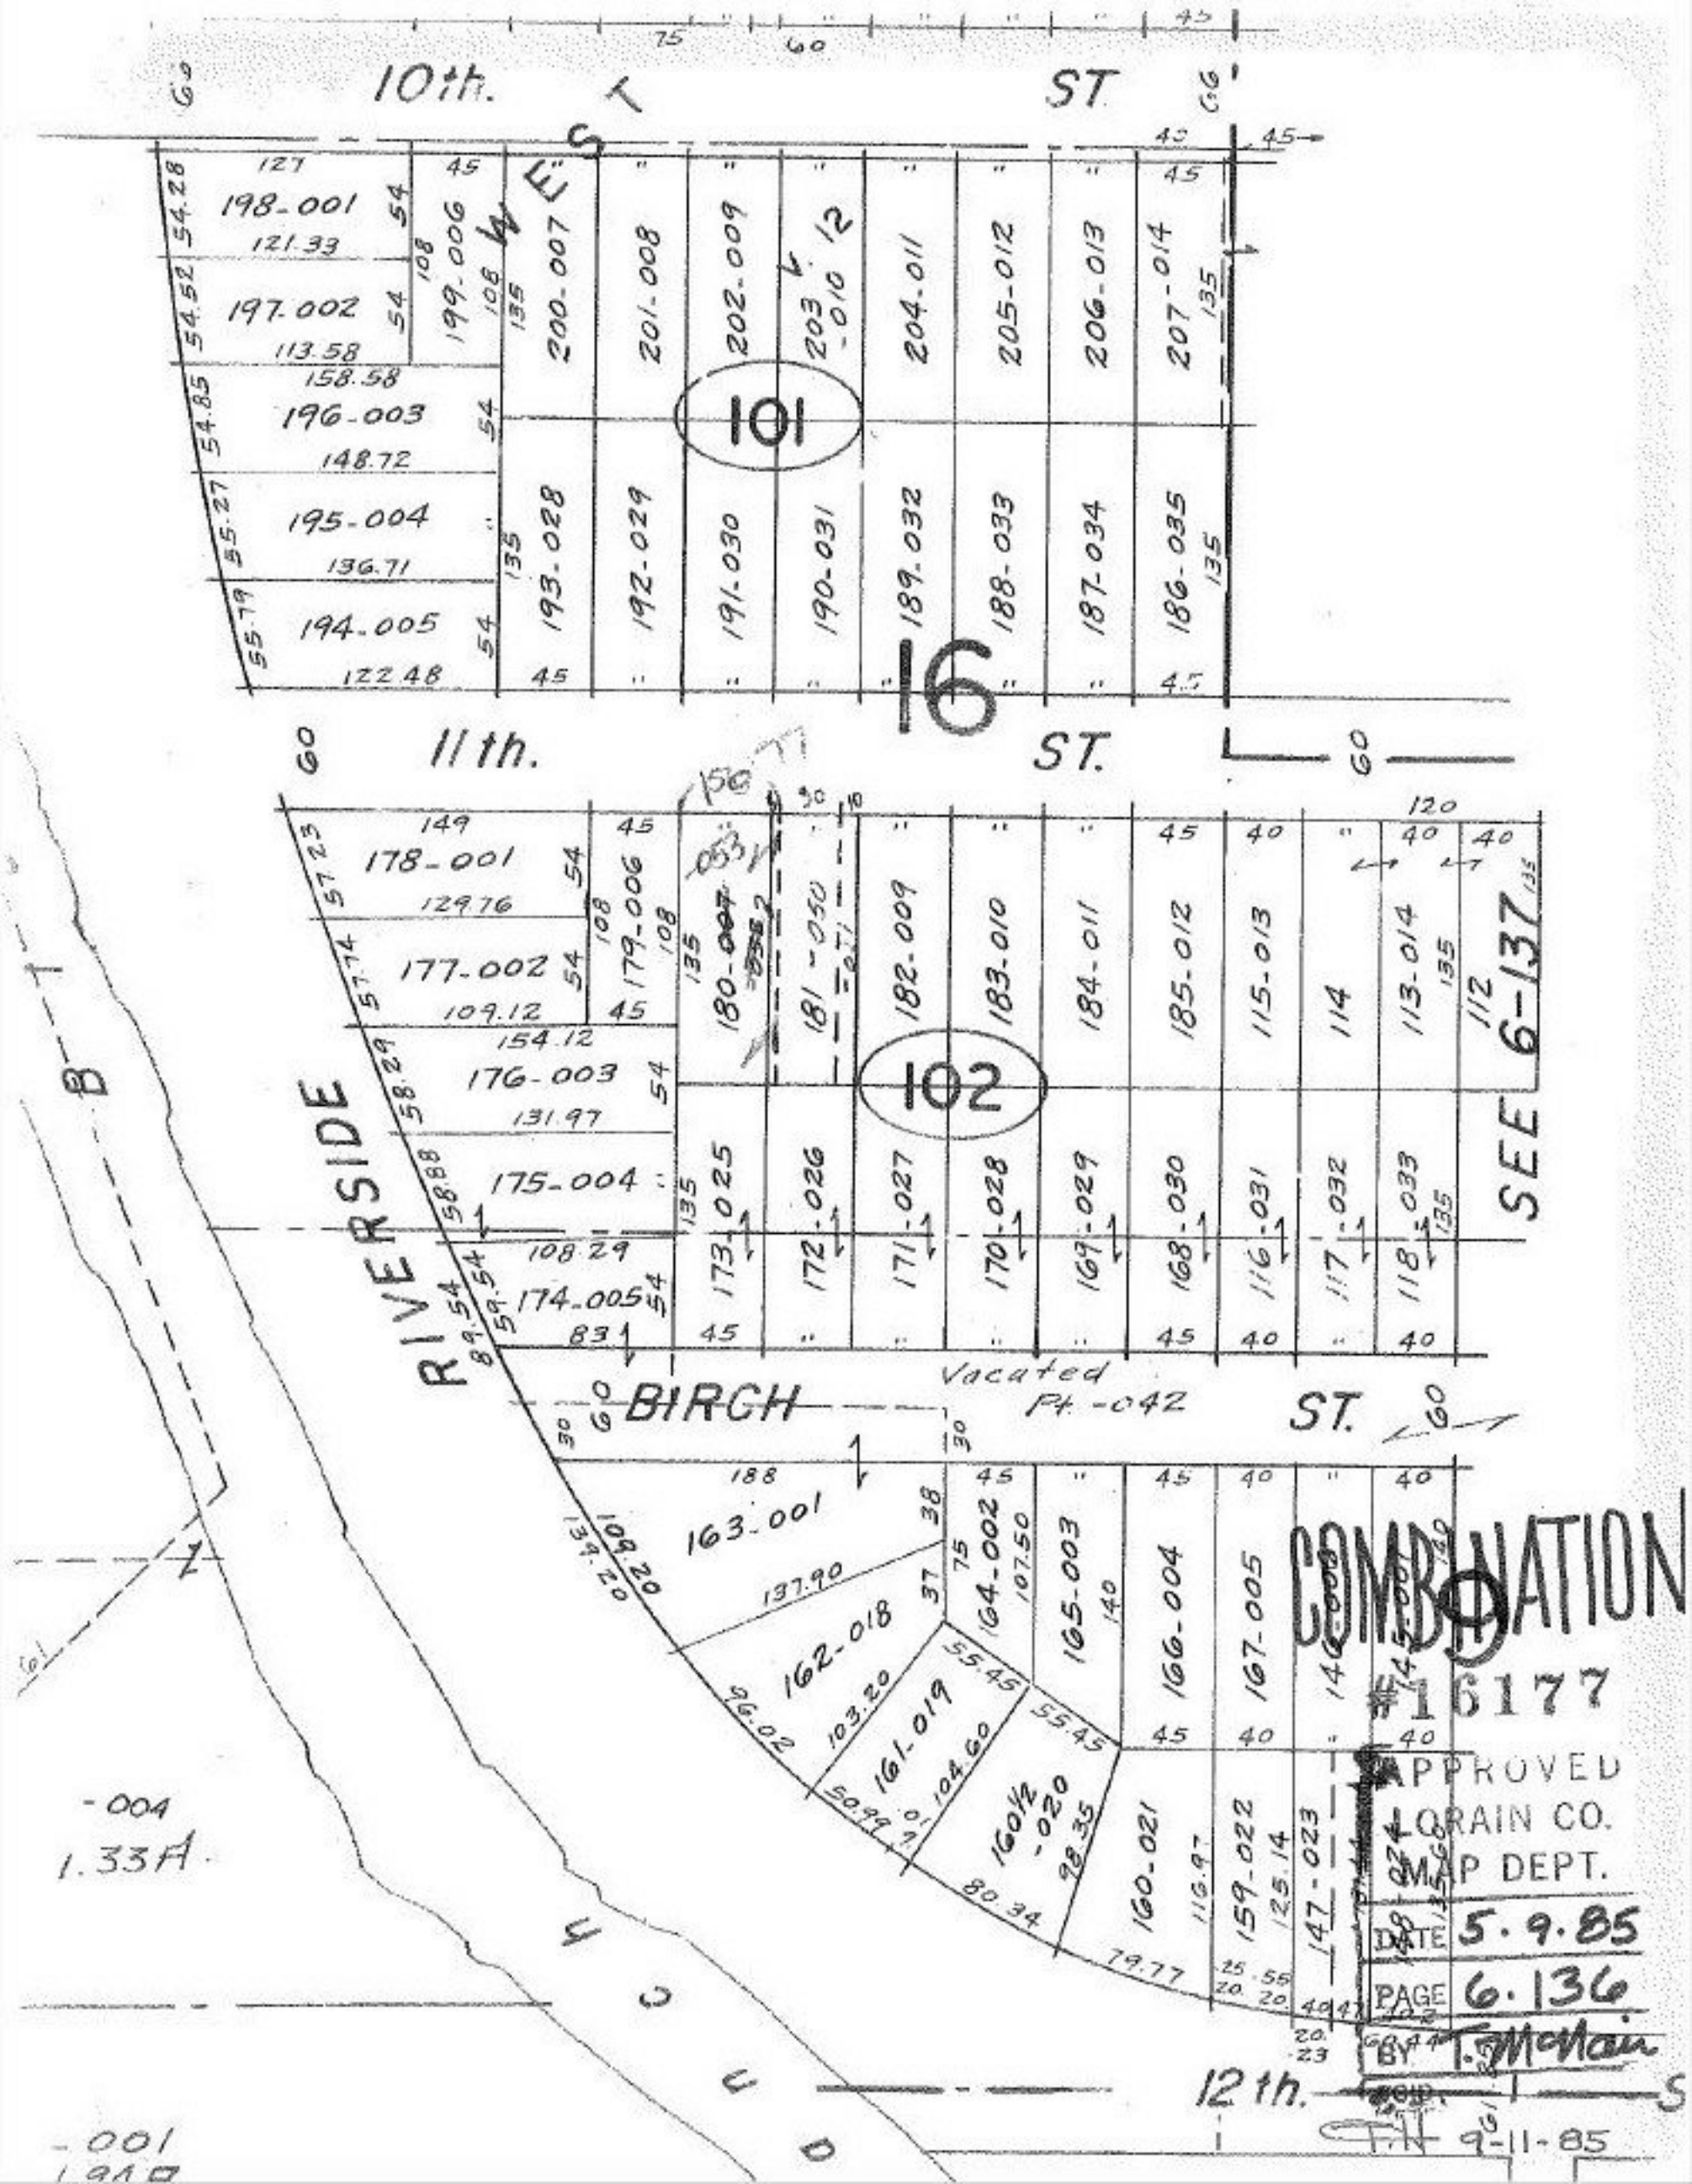
10th. ST
WEST
11th. ST.
RIVERSIDE
BIRCH ST.
12th.
SEE 6-137
101
102
16
198-001
197-002
196-003
195-004
194-005
199-006
200-007
201-008
202-009
203-010
204-011
205-012
206-013
207-014
193-028
192-029
191-030
190-031
189-032
188-033
187-034
186-035
178-001
177-002
176-003
175-004
174-005
179-006
180-007
181-050
182-009
183-010
184-011
185-012
115-013
114
113-014
112
173-025
172-026
171-027
170-028
169-029
168-030
116-031
117-032
118-033
Vacated Pt.-042
163-001
162-018
161-019
160½-020
164-002
165-003
166-004
167-005
160-021
159-022
147-023
-004
1.33A
-001
COMBINATION
#16177
APPROVED
LORAIN CO.
MAP DEPT.
DATE 5.9.85
PAGE 6.136
BY T. McNair
9-11-85