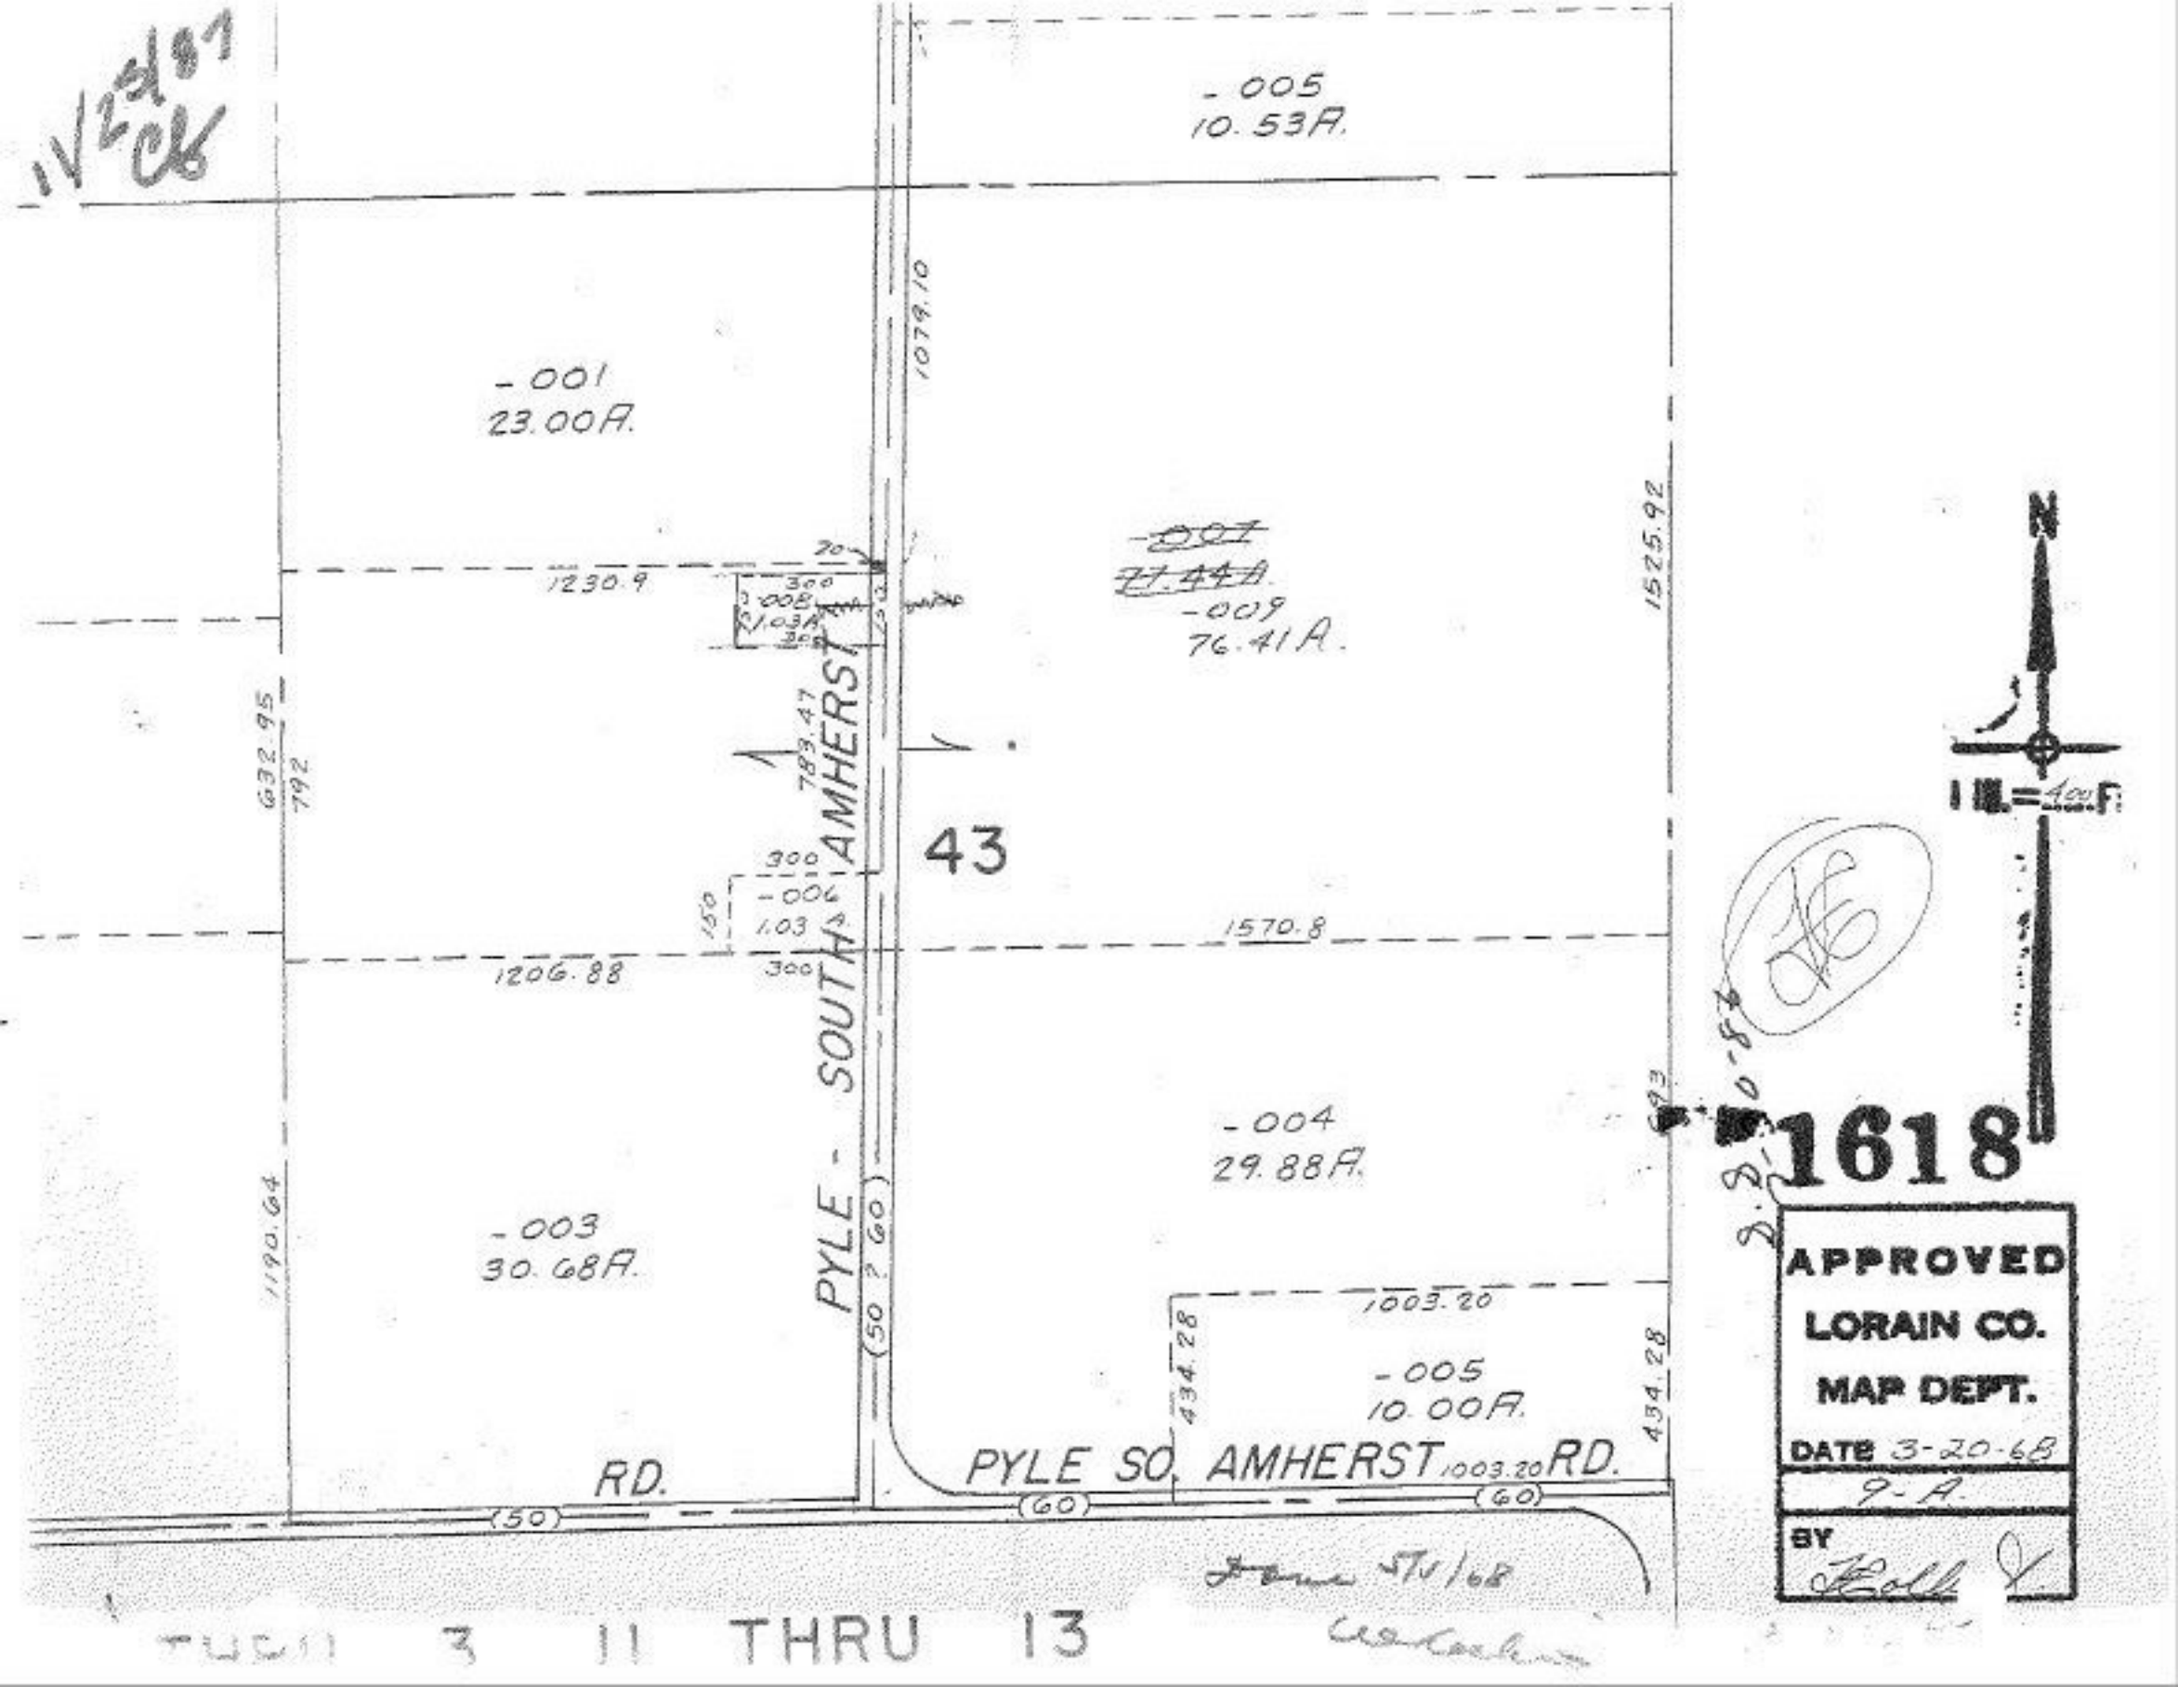
-005
10.53A.
-001
23.00A.
1079.10
1525.92
-007
7.44A.
-009
76.41A.
1230.9
20
300
-008
1.03A.
300
150
632.95
792
789.47
PYLE - SOUTH AMHERST
43
300
-006
1.03A.
300
150
1570.8
1206.88
-004
29.88A.
1190.64
-003
30.68A.
(50 ? 60)
1003.20
434.28
-005
10.00A.
434.28
PYLE SO. AMHERST 1003.20 RD.
RD.
(50)
(60)
(60)
N
1" = 400'
1618
APPROVED
LORAIN CO.
MAP DEPT.
DATE 3-20-68
9-A.
BY
TWP 3 11 THRU 13