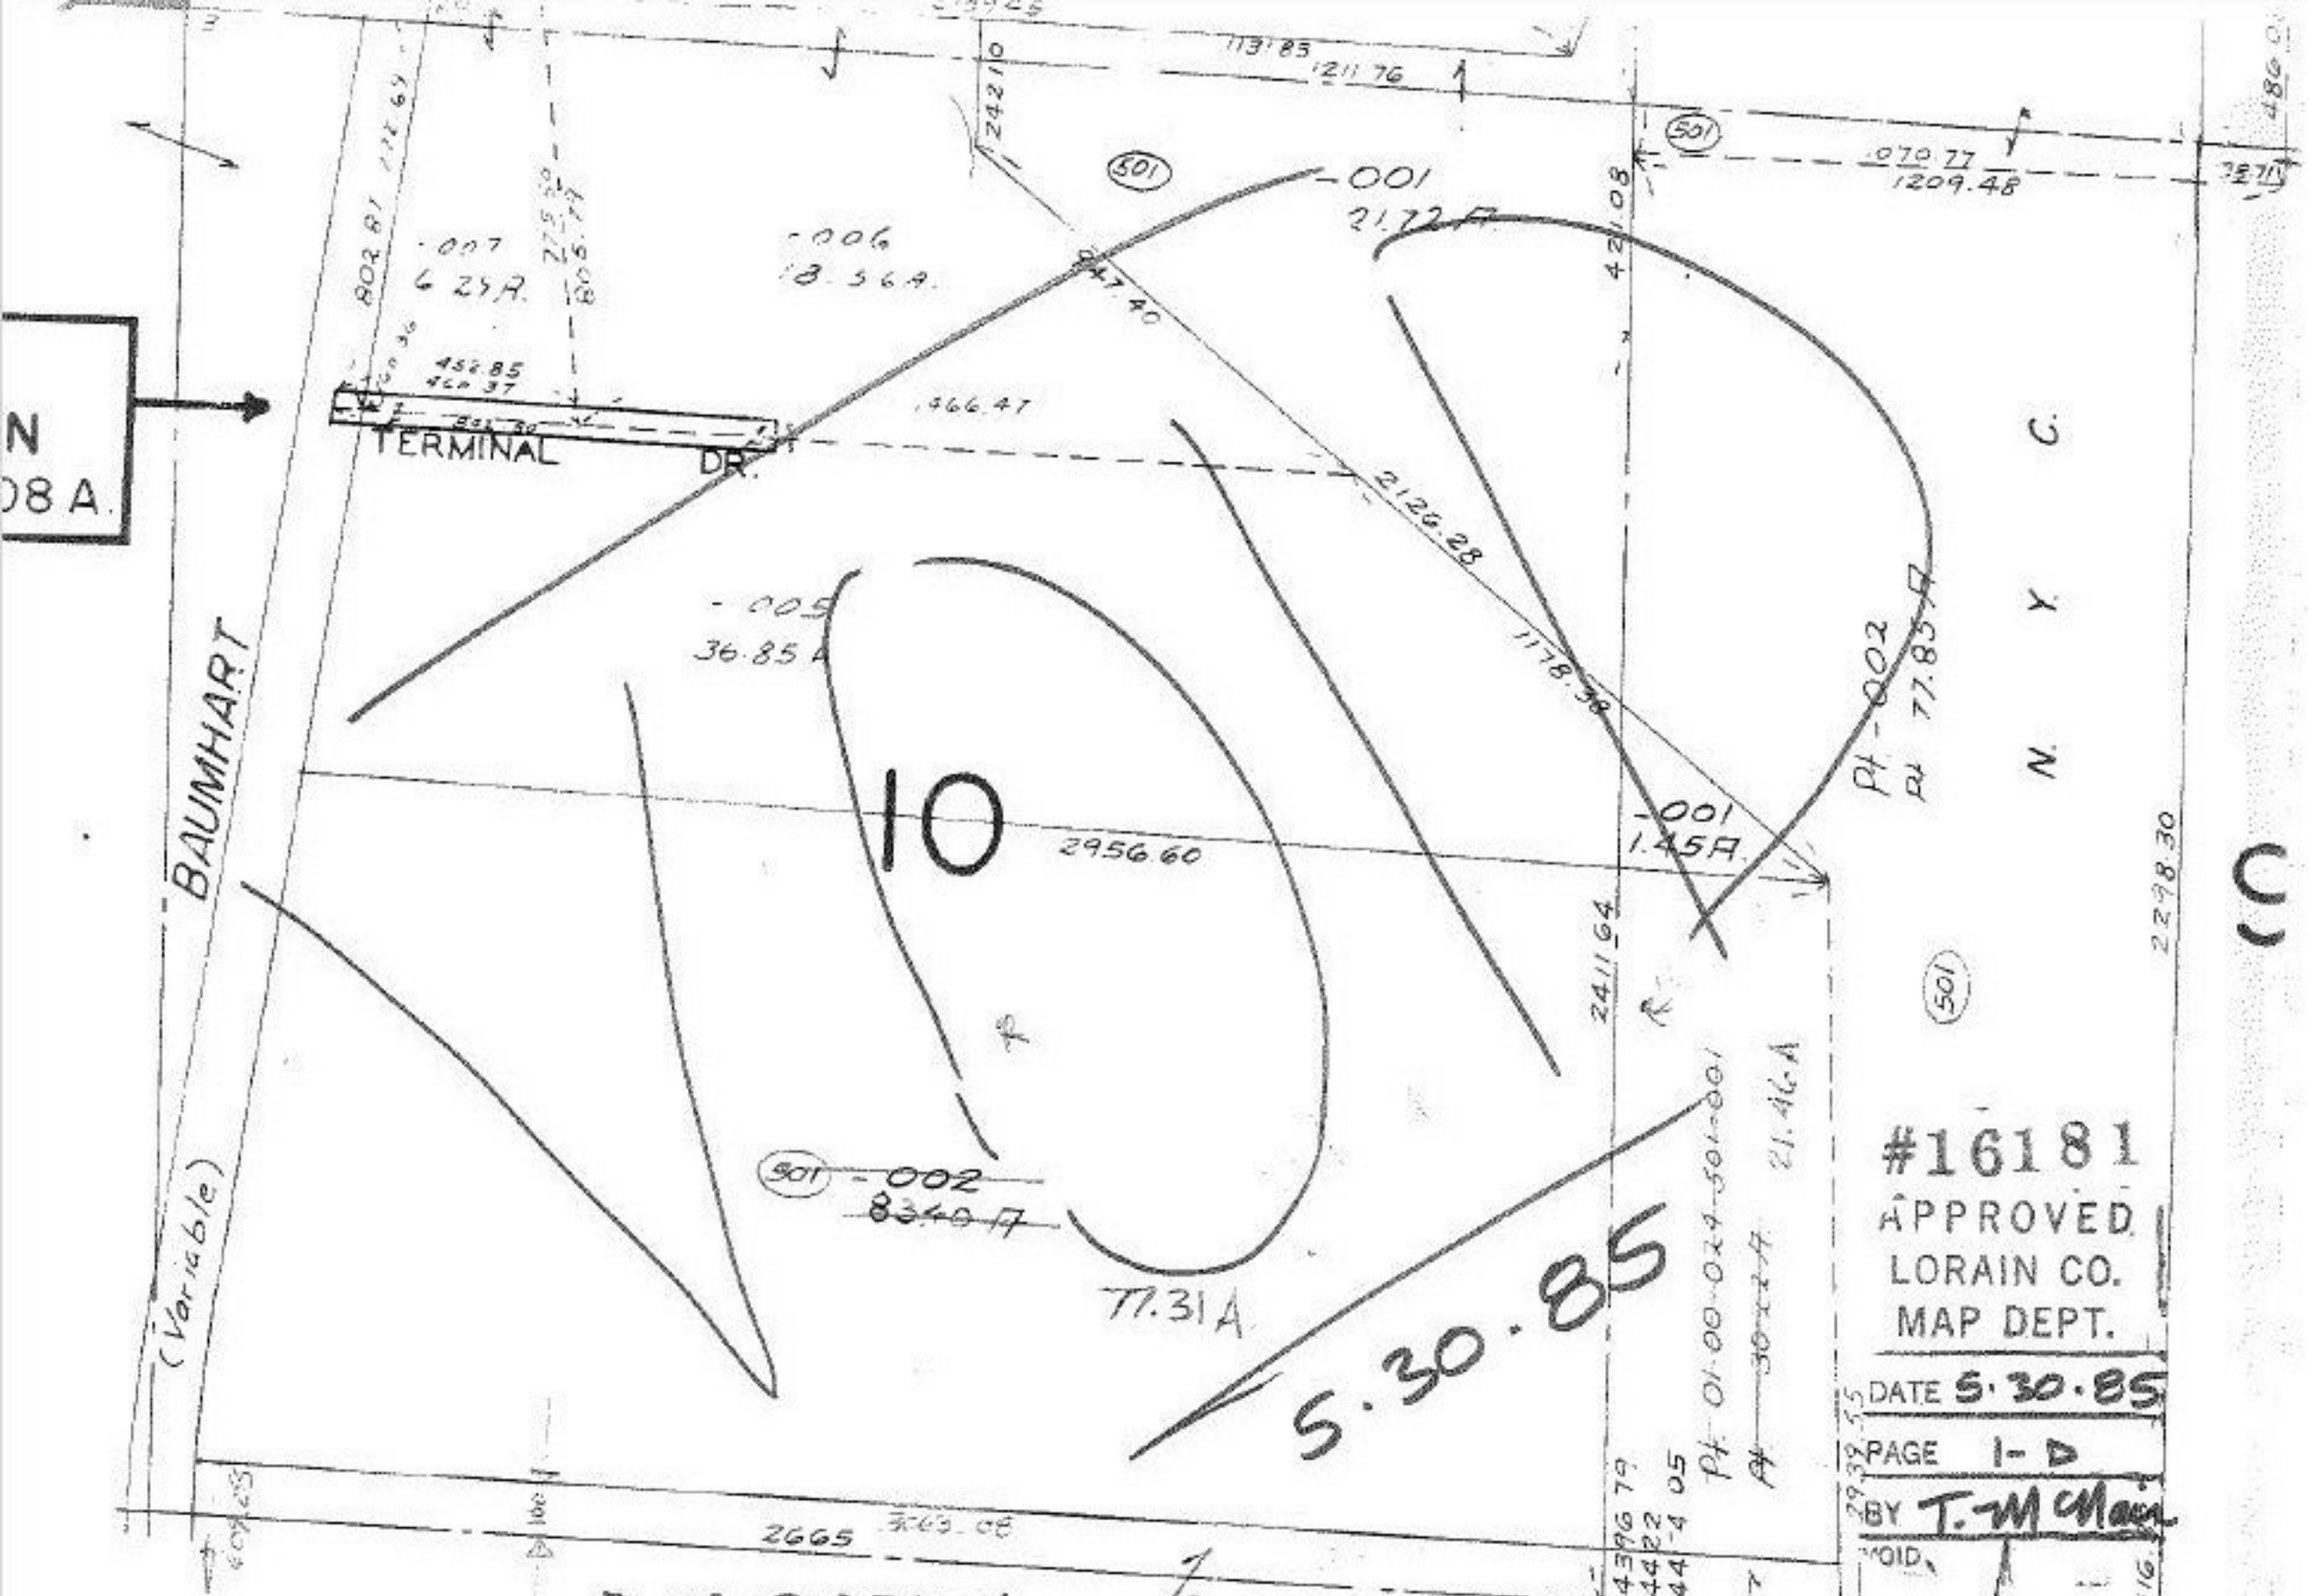

DESCRIPTION BEING REVISED
BY DEMPSEY & ASSOC.