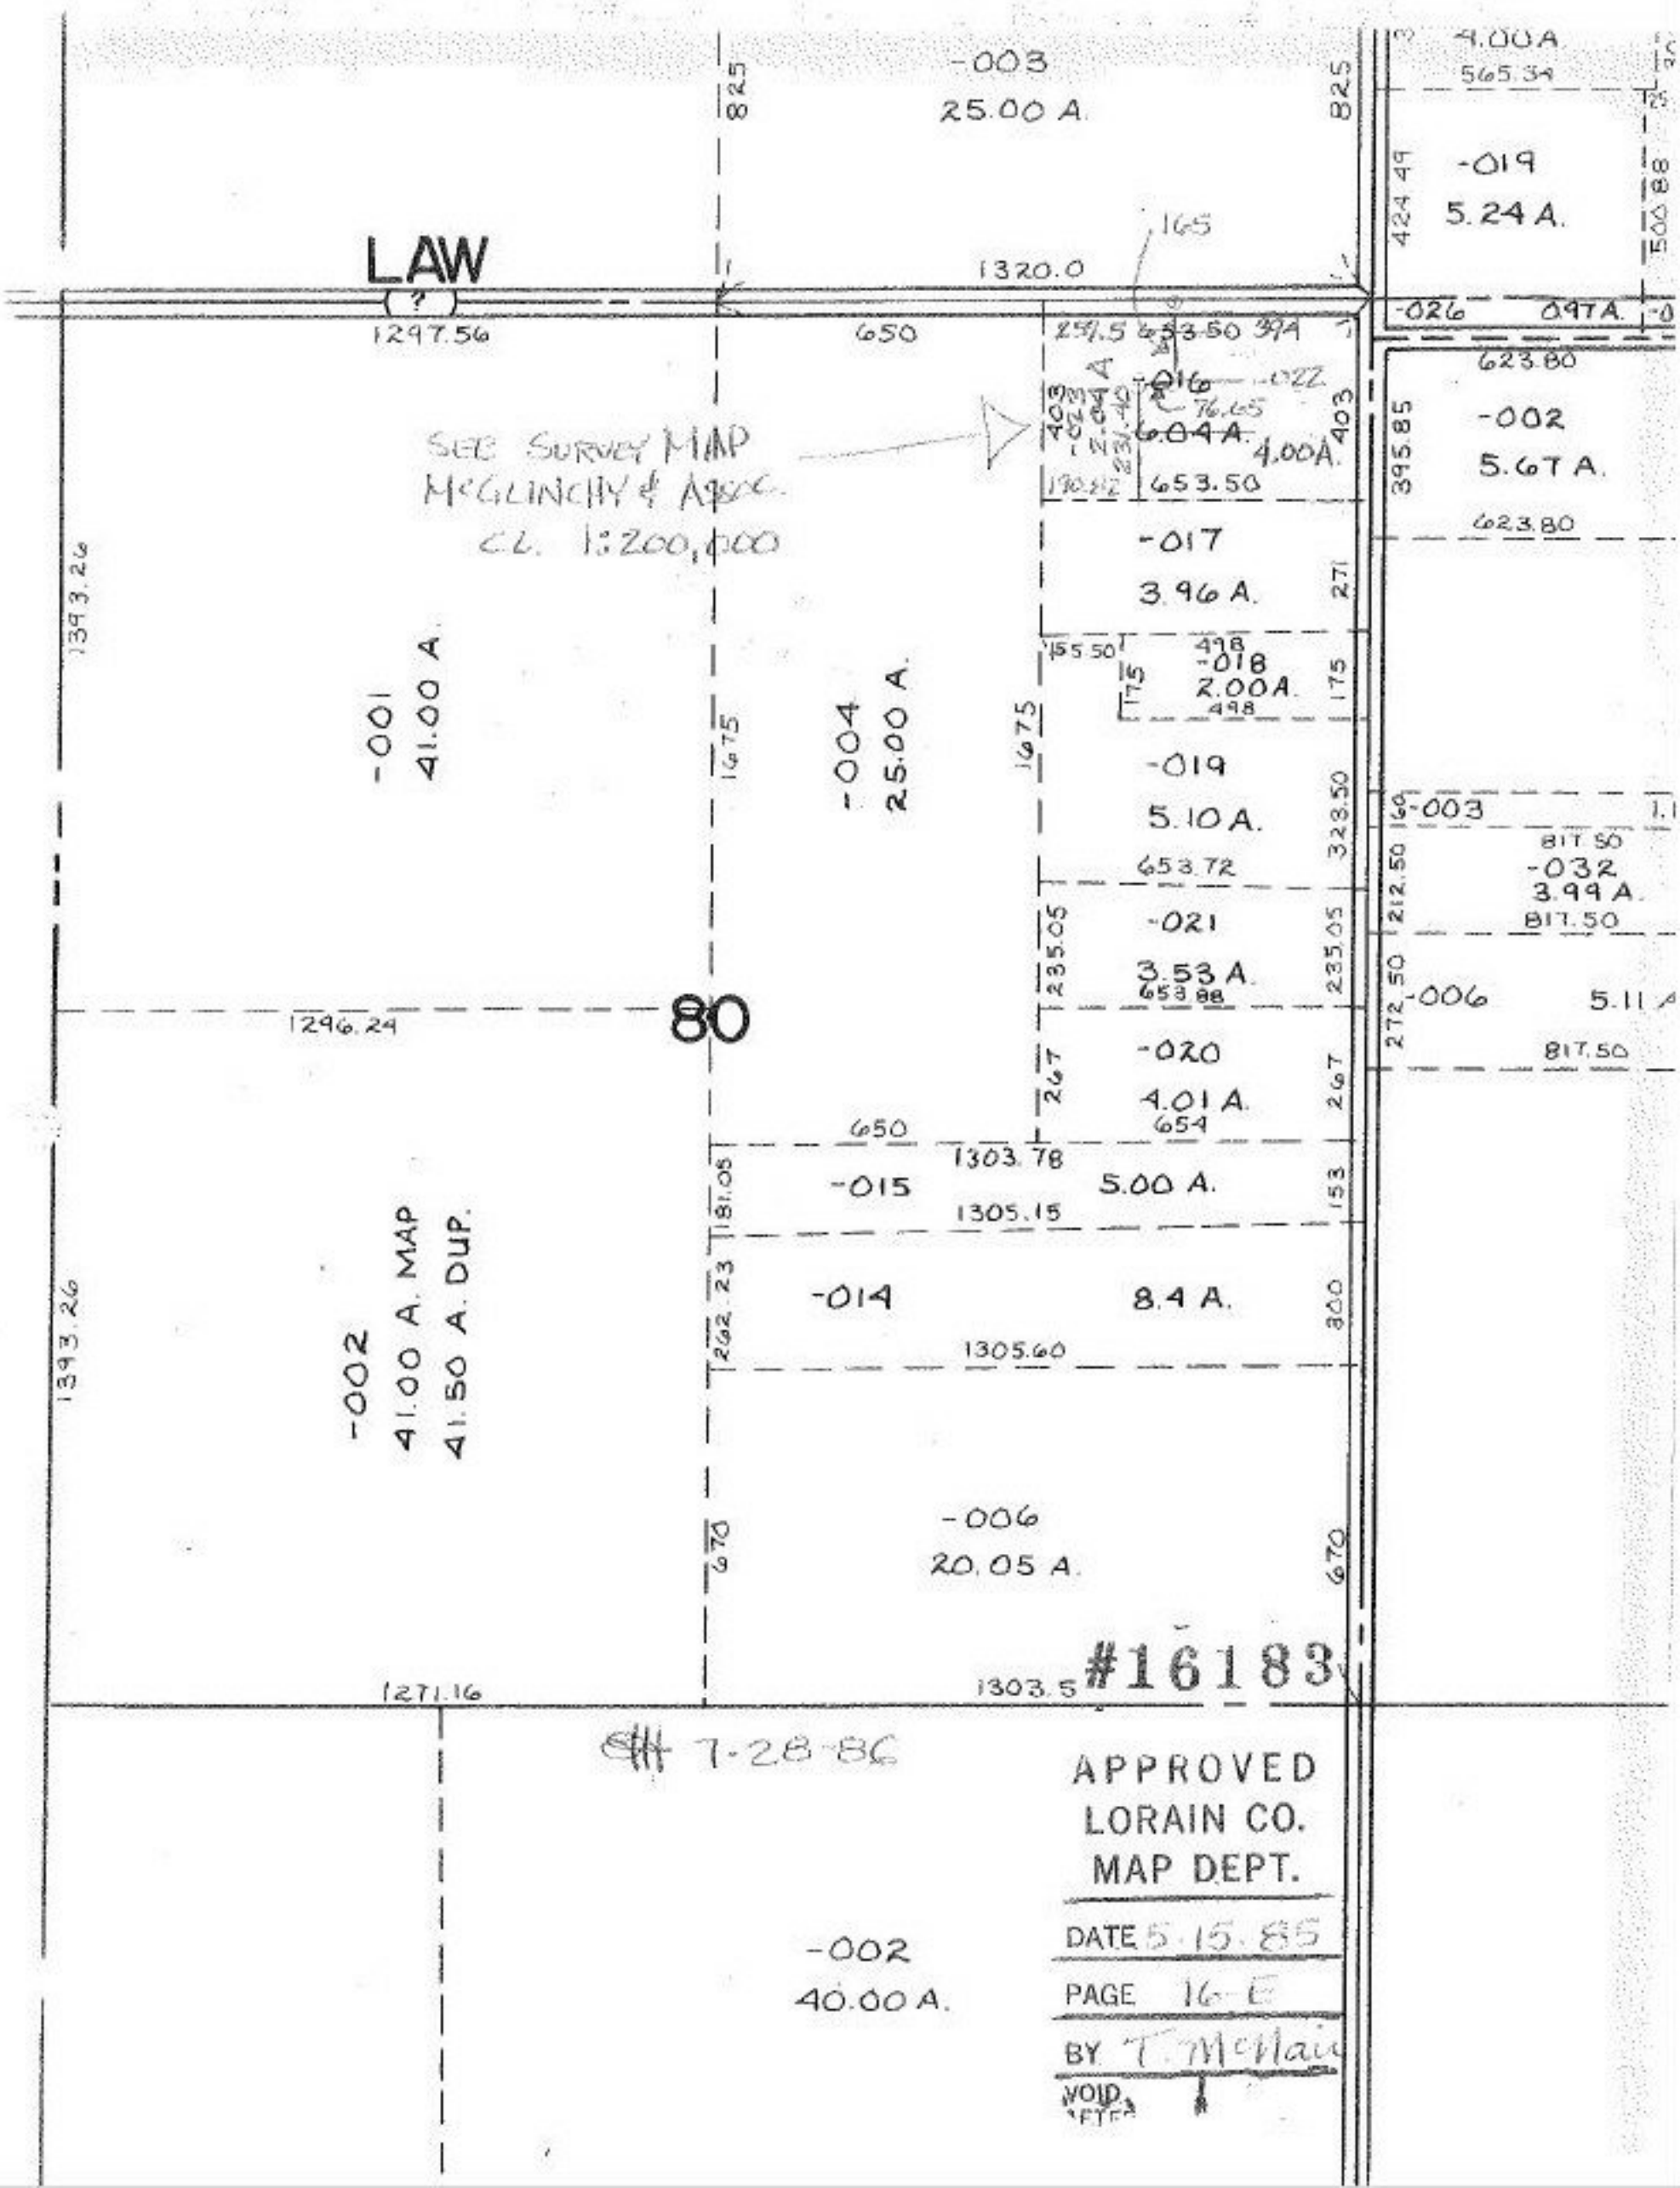

LAW
-003
25.00 A.
825
825
4.00A
565.34
-019
5.24 A.
424.49
500.88
165
1320.0
-026
0.97A.
1297.56
650
259.5
653.50
394
-016
-022
76.65
6.04 A.
4.00A.
403
403
395.85
-002
5.67 A.
623.80
623.80
SEE SURVEY MAP
McGLINCHY & ASSOC.
CL. 1:200,000
653.50
-017
3.96 A.
271
1393.26
155.50
498
-018
2.00A.
498
175
175
-001
41.00 A.
1675
-004
25.00 A.
1675
-019
5.10 A.
323.50
-003
817.50
-032
3.99 A.
817.50
653.72
212.50
-021
3.53 A.
653.88
235.05
235.05
272.50
-006
5.11 A
817.50
1296.24
80
-020
4.01 A.
654
267
267
650
1303.78
-015
5.00 A.
153
181.05
1305.15
-002
41.00 A. MAP
41.50 A. DUP.
1393.26
262.23
-014
8.4 A.
300
1305.60
-006
20.05 A.
670
670
#16183
1271.16
1303.5
7-28-86
APPROVED
LORAIN CO.
MAP DEPT.
DATE 5.15.85
PAGE 16-E
BY T. McNair
VOID
-002
40.00 A.