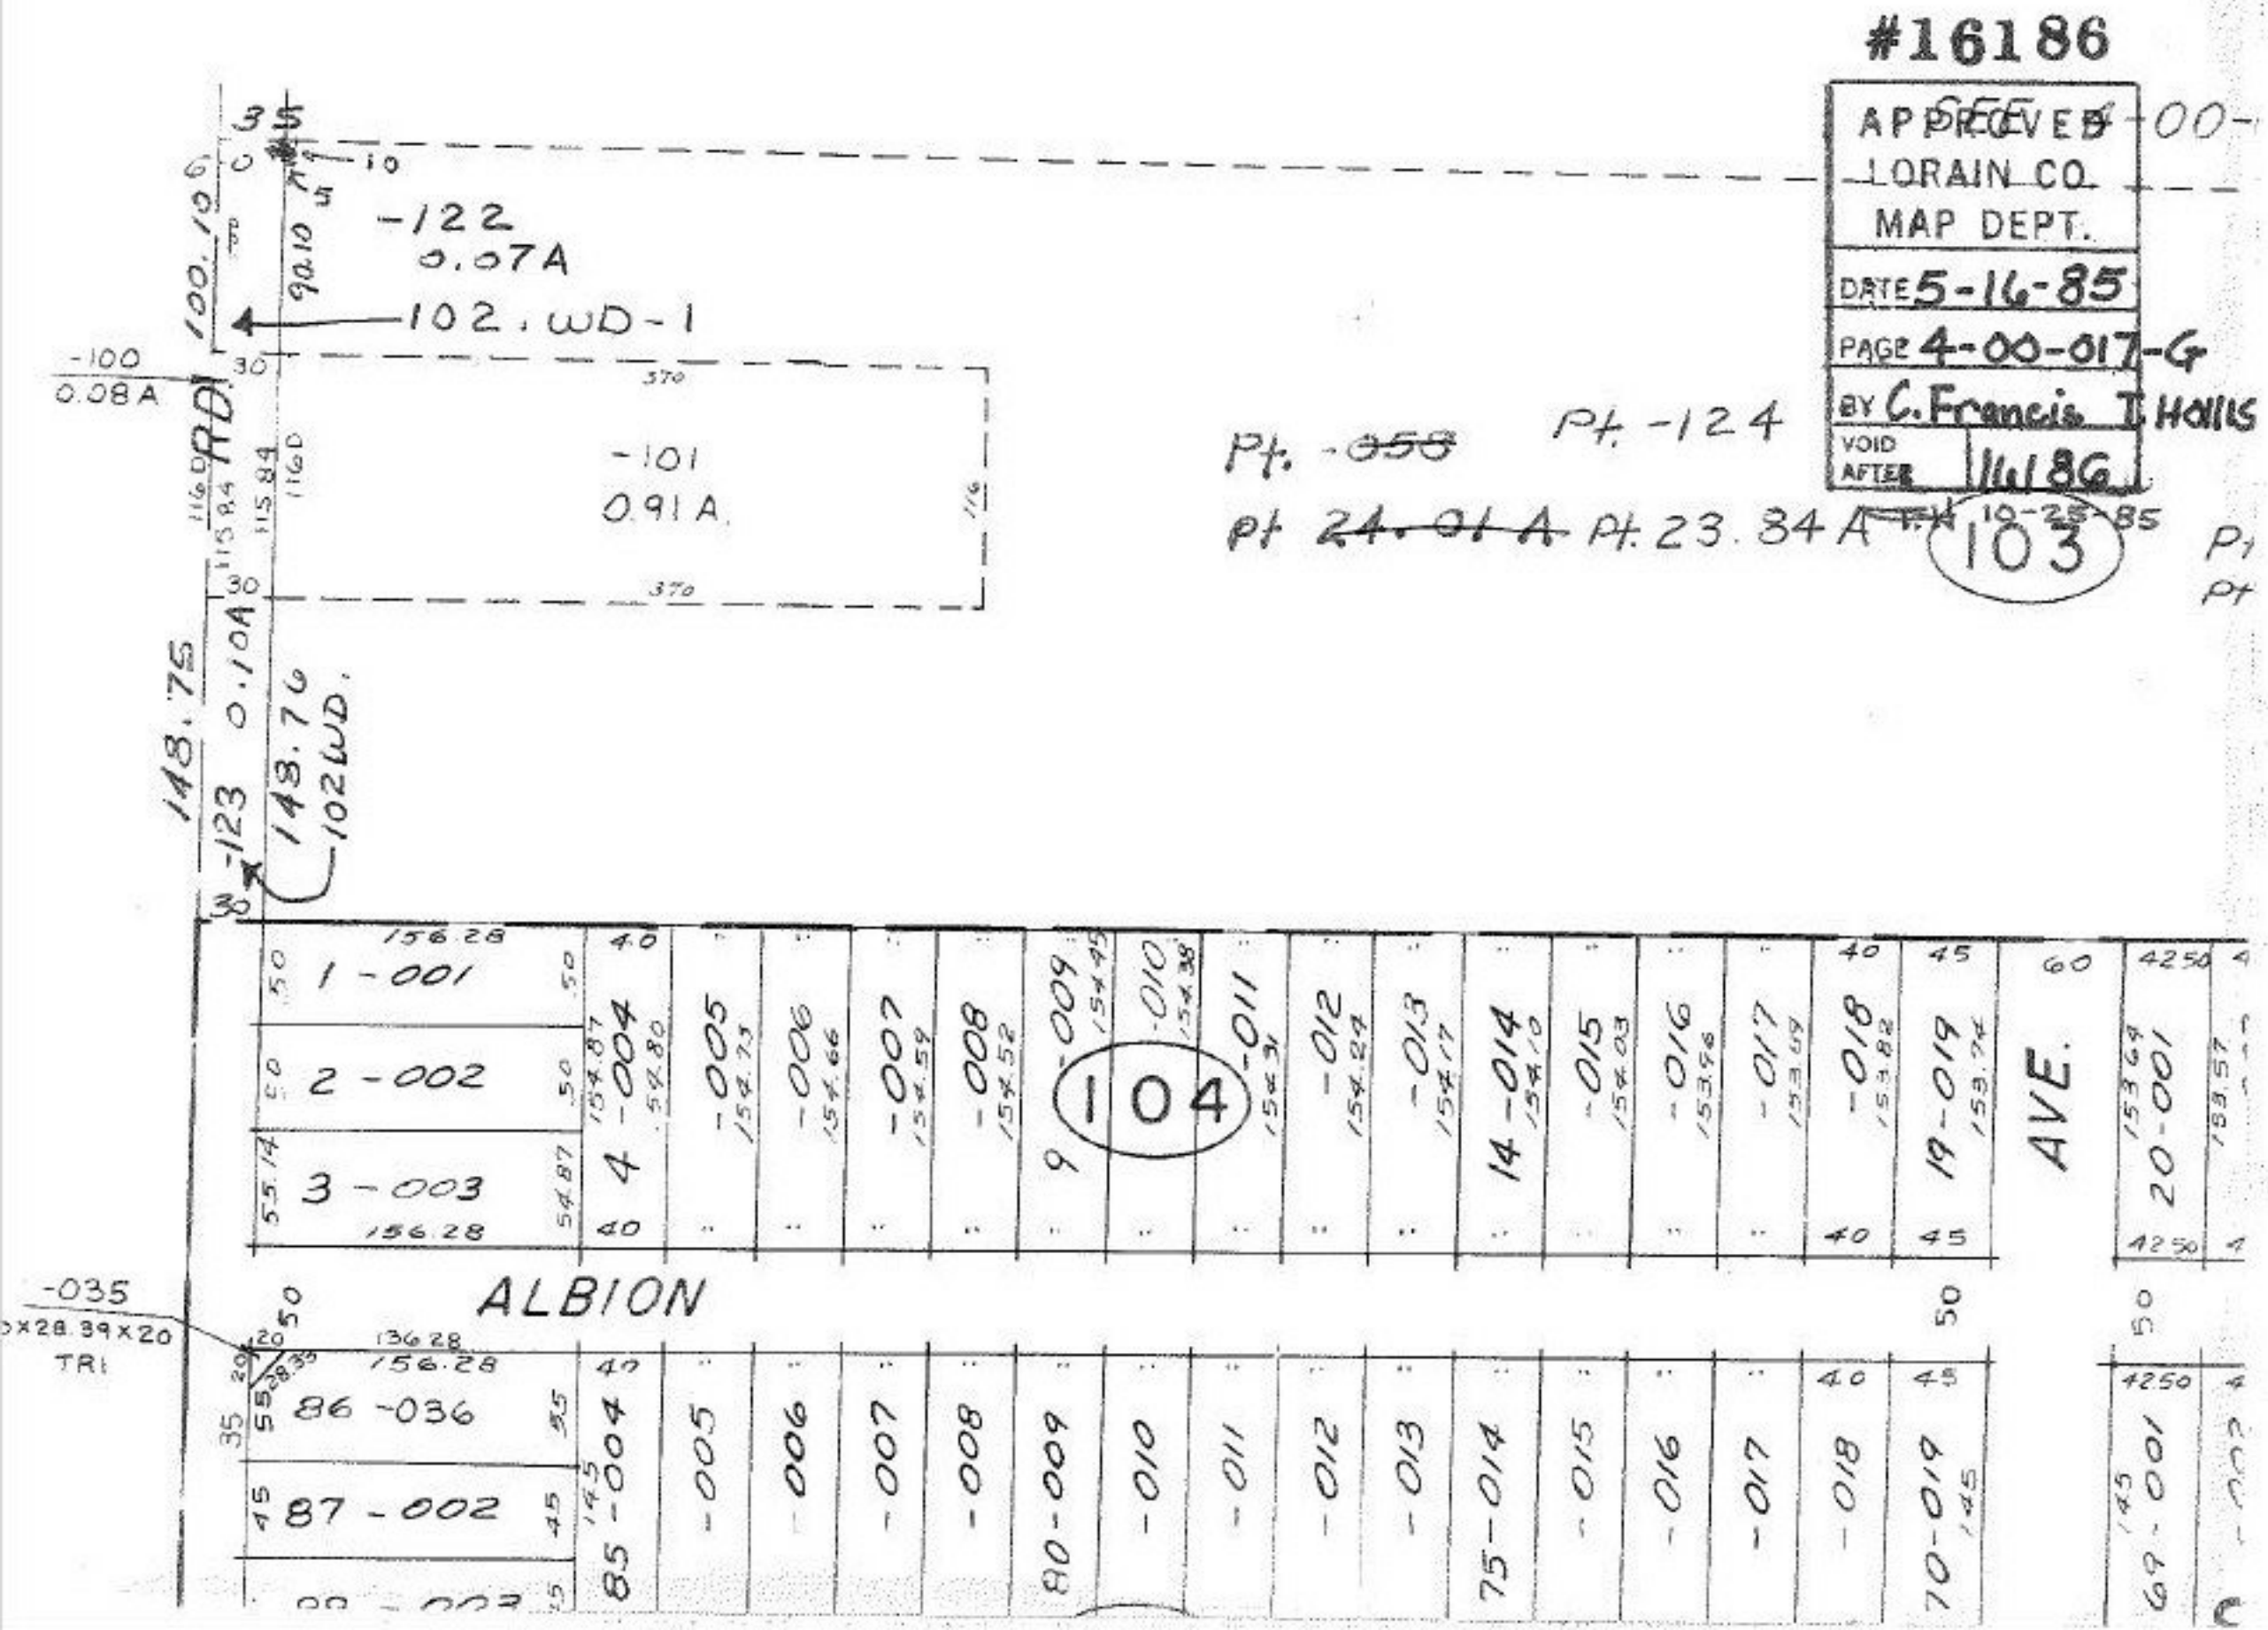
#16186
APPROVED
LORAIN CO.
MAP DEPT.
DATE 5-16-85
PAGE 4-00-017-G
BY C. Francis T. Hollis
VOID AFTER 16186
SEE 4-00-
-122
0.07A
102. WD-1
-100
0.08A
-101
0.91 A.
Pt. -124
Pt. 23.84 A
103
-123
148.75
0.10A
148.76
102WD.
1-001
2-002
3-003
4-004
-005
-006
-007
-008
9-009
-010
-011
-012
-013
14-014
-015
-016
-017
-018
19-019
20-001
104
AVE.
ALBION
-035
TRI
86-036
87-002
85-004
80-009
75-014
70-019
69-001