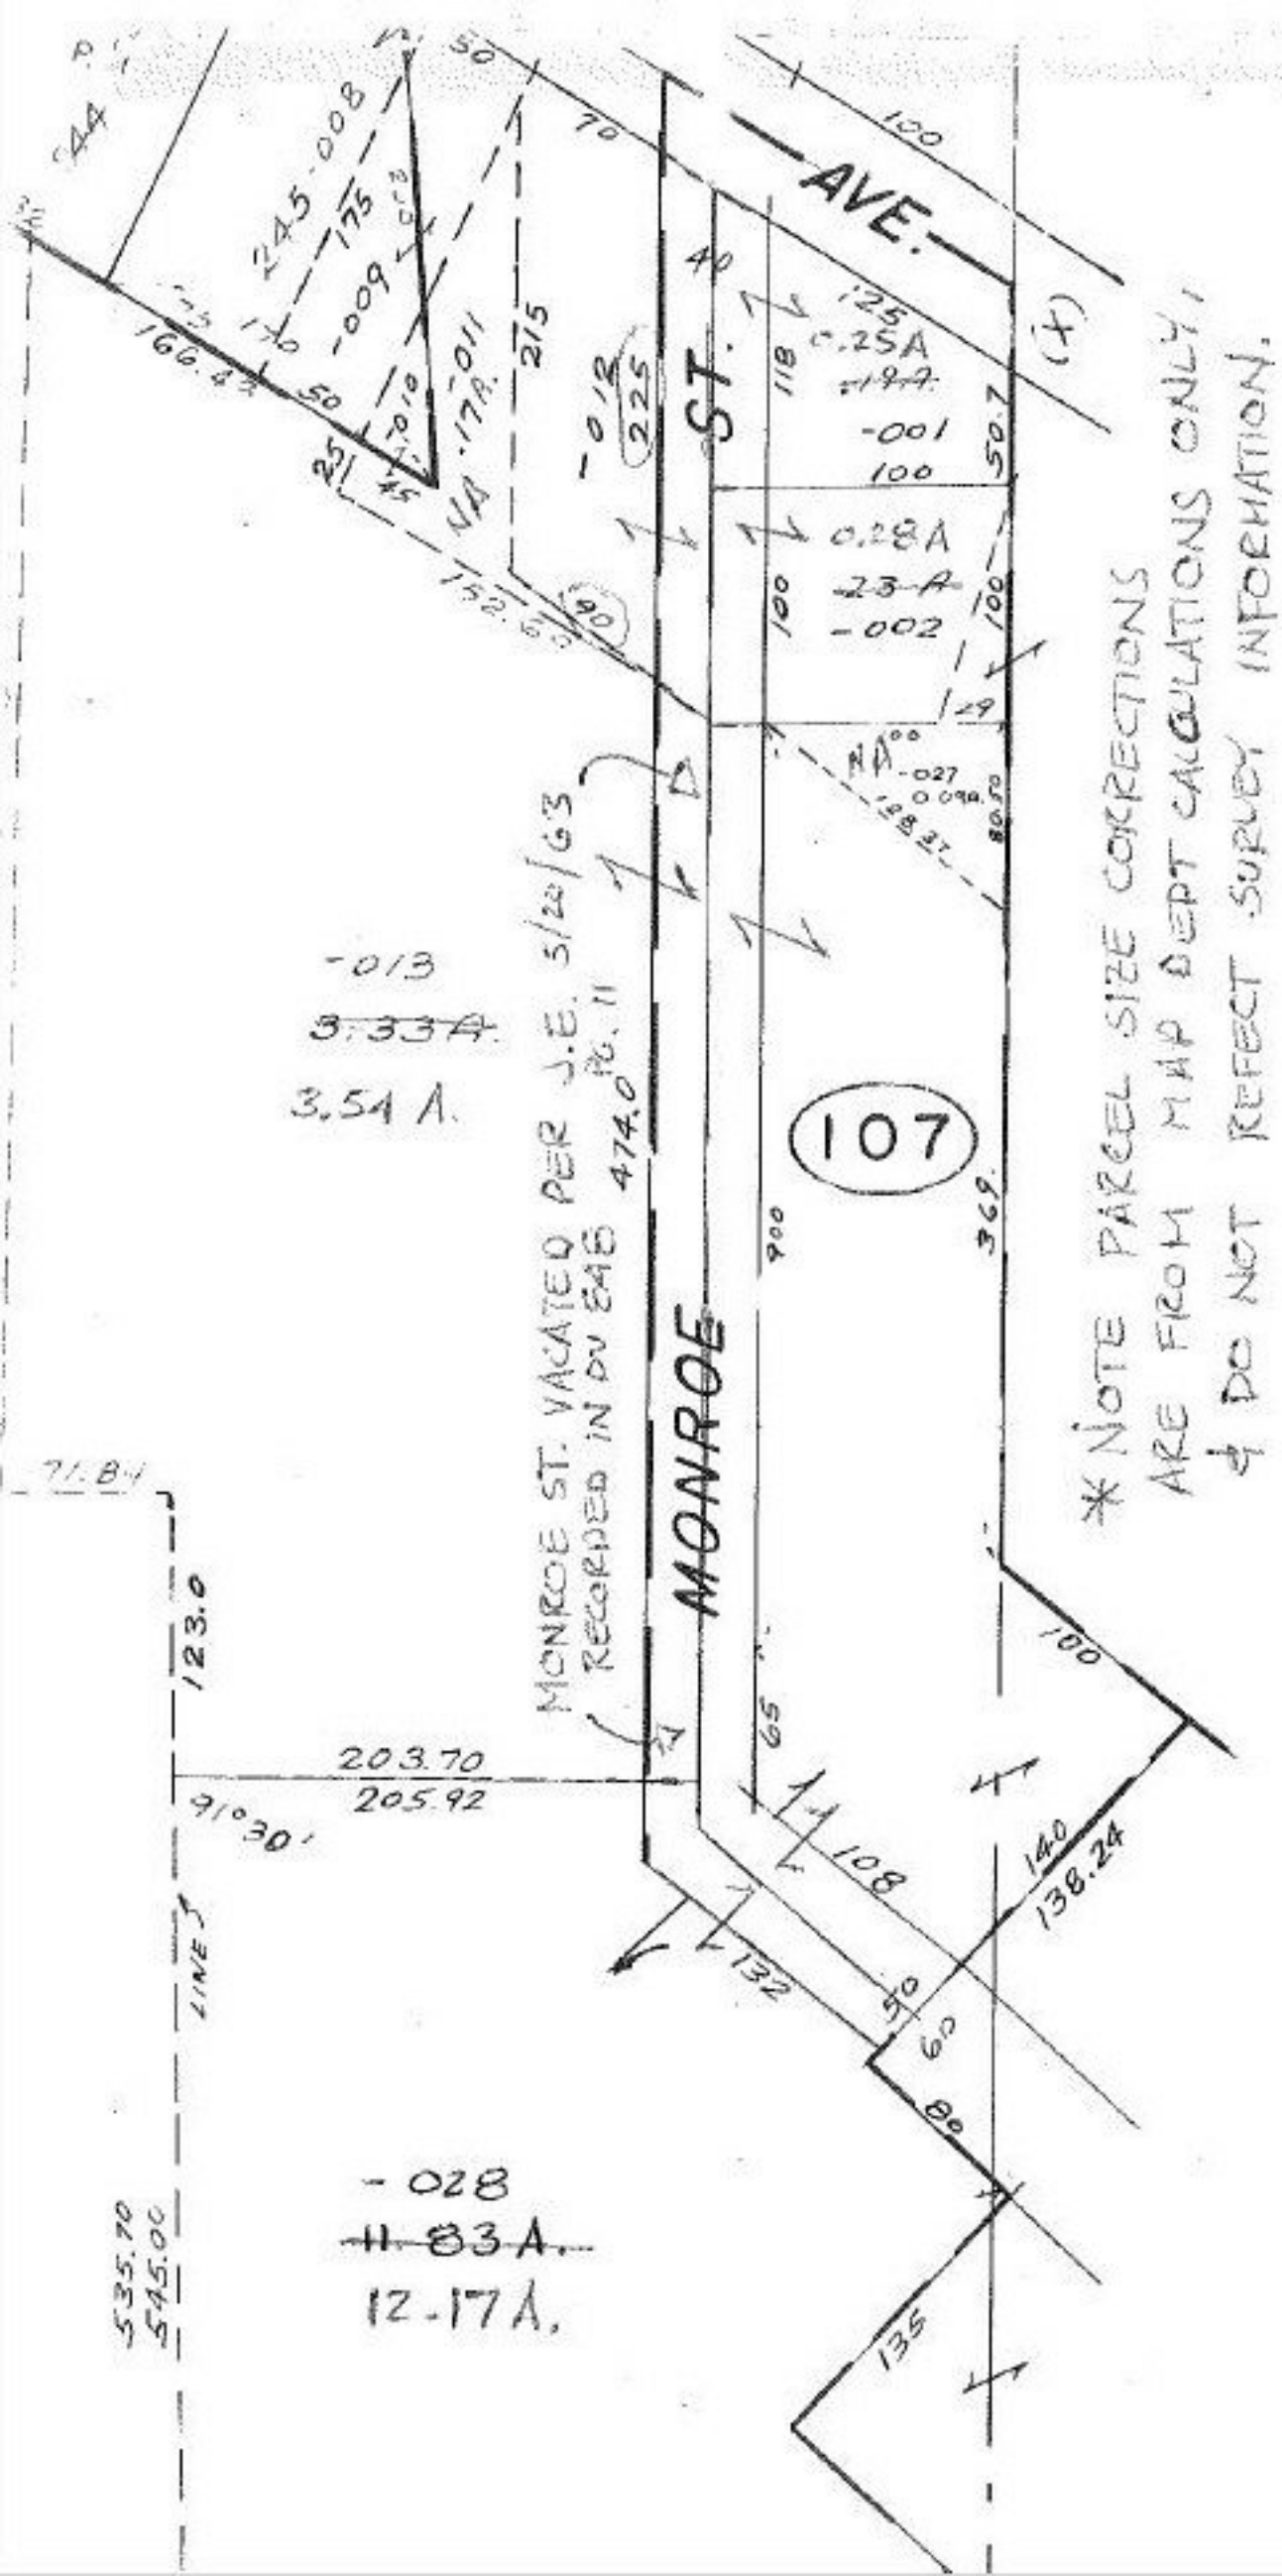
AVE.
ST.
MONROE
107
-013
3.334
3.51 A.
-028
11.83 A.
12.17 A.
0.25A
-001
0.28A
-002
MONROE ST. VACATED PER J.E. 5/22/63
RECORDED IN DV 648 PG. 11
* NOTE PARCEL SIZE CORRECTIONS ARE FROM MAP DEPT CALCULATIONS ONLY, & DO NOT REFLECT SURVEY INFORMATION.
SEE 5-00-036-A
STREET VACATION
#16189
APPROVED
LORAIN CO.
MAP DEPT.
DATE 5.20.85
PAGE 5.00.025 B
BY T. McNair
VOID
T.M.
7.17.85