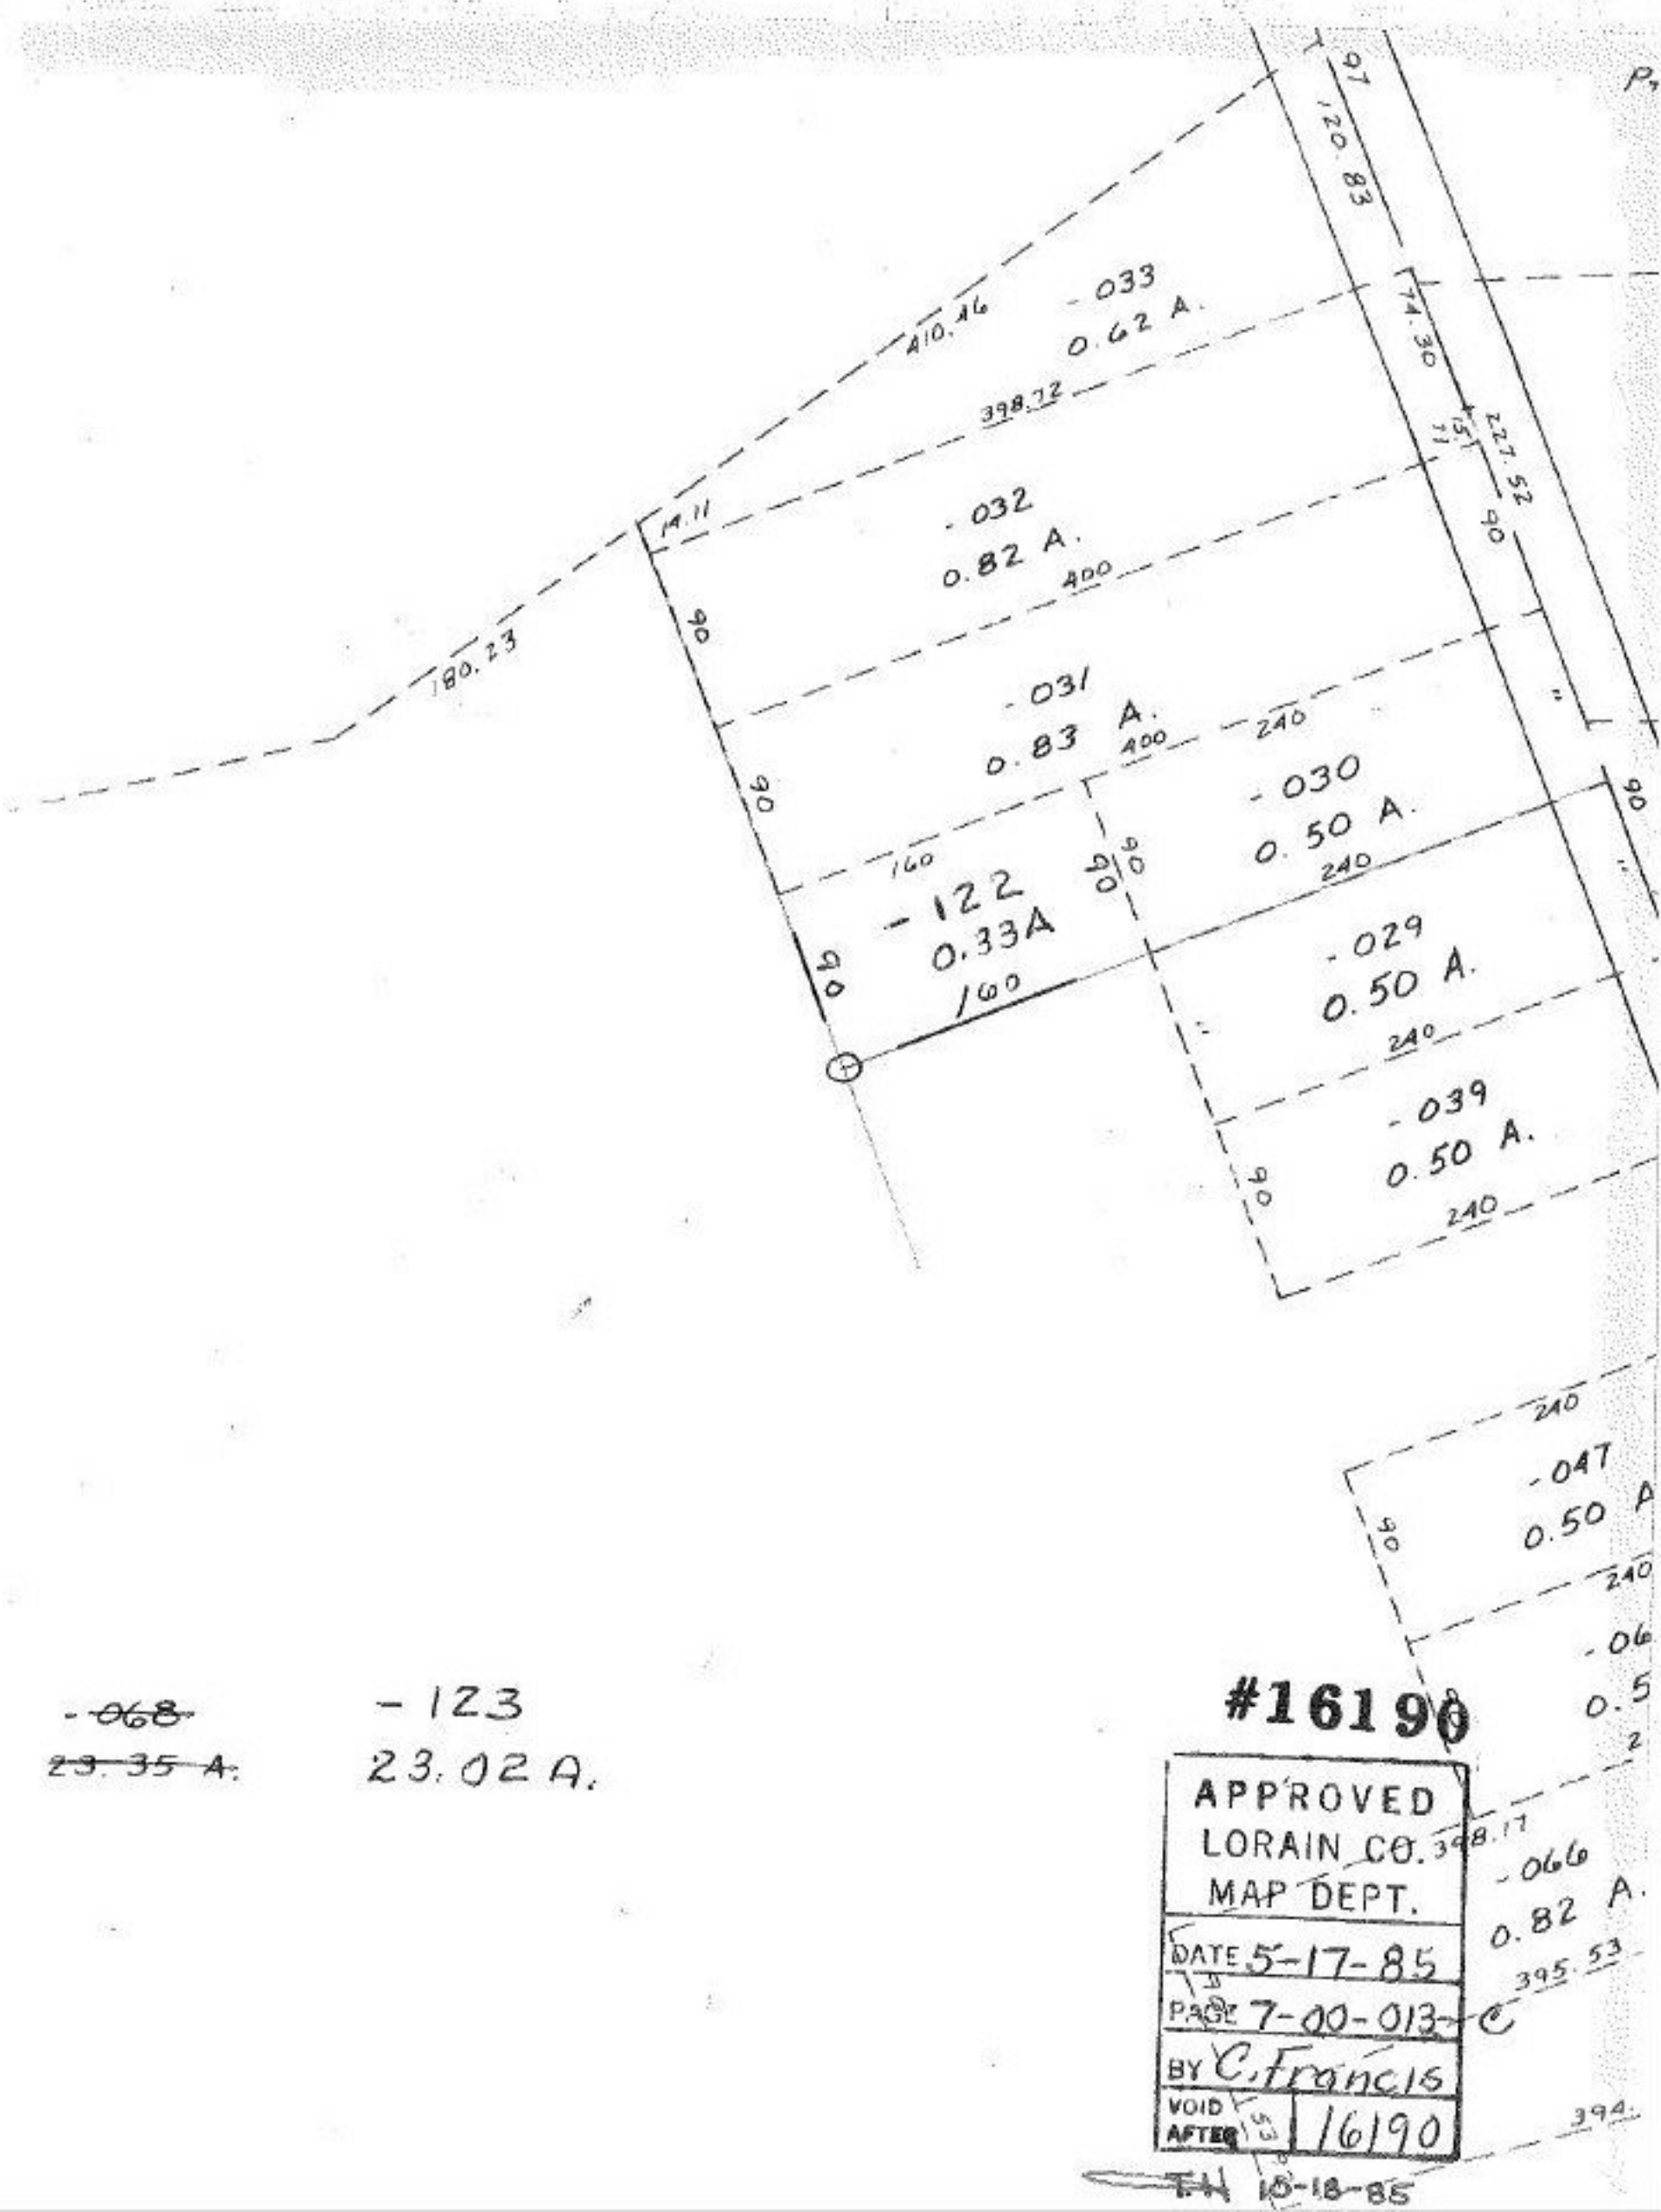

~~-068~~
~~23.35 A.~~

-123
23.02 A.

#16190

APPROVED
LORAIN CO.
MAP DEPT.
DATE 5-17-85
PAGE 7-00-013-C
BY C. Francis
VOID AFTER 16190

T.H. 10-18-85