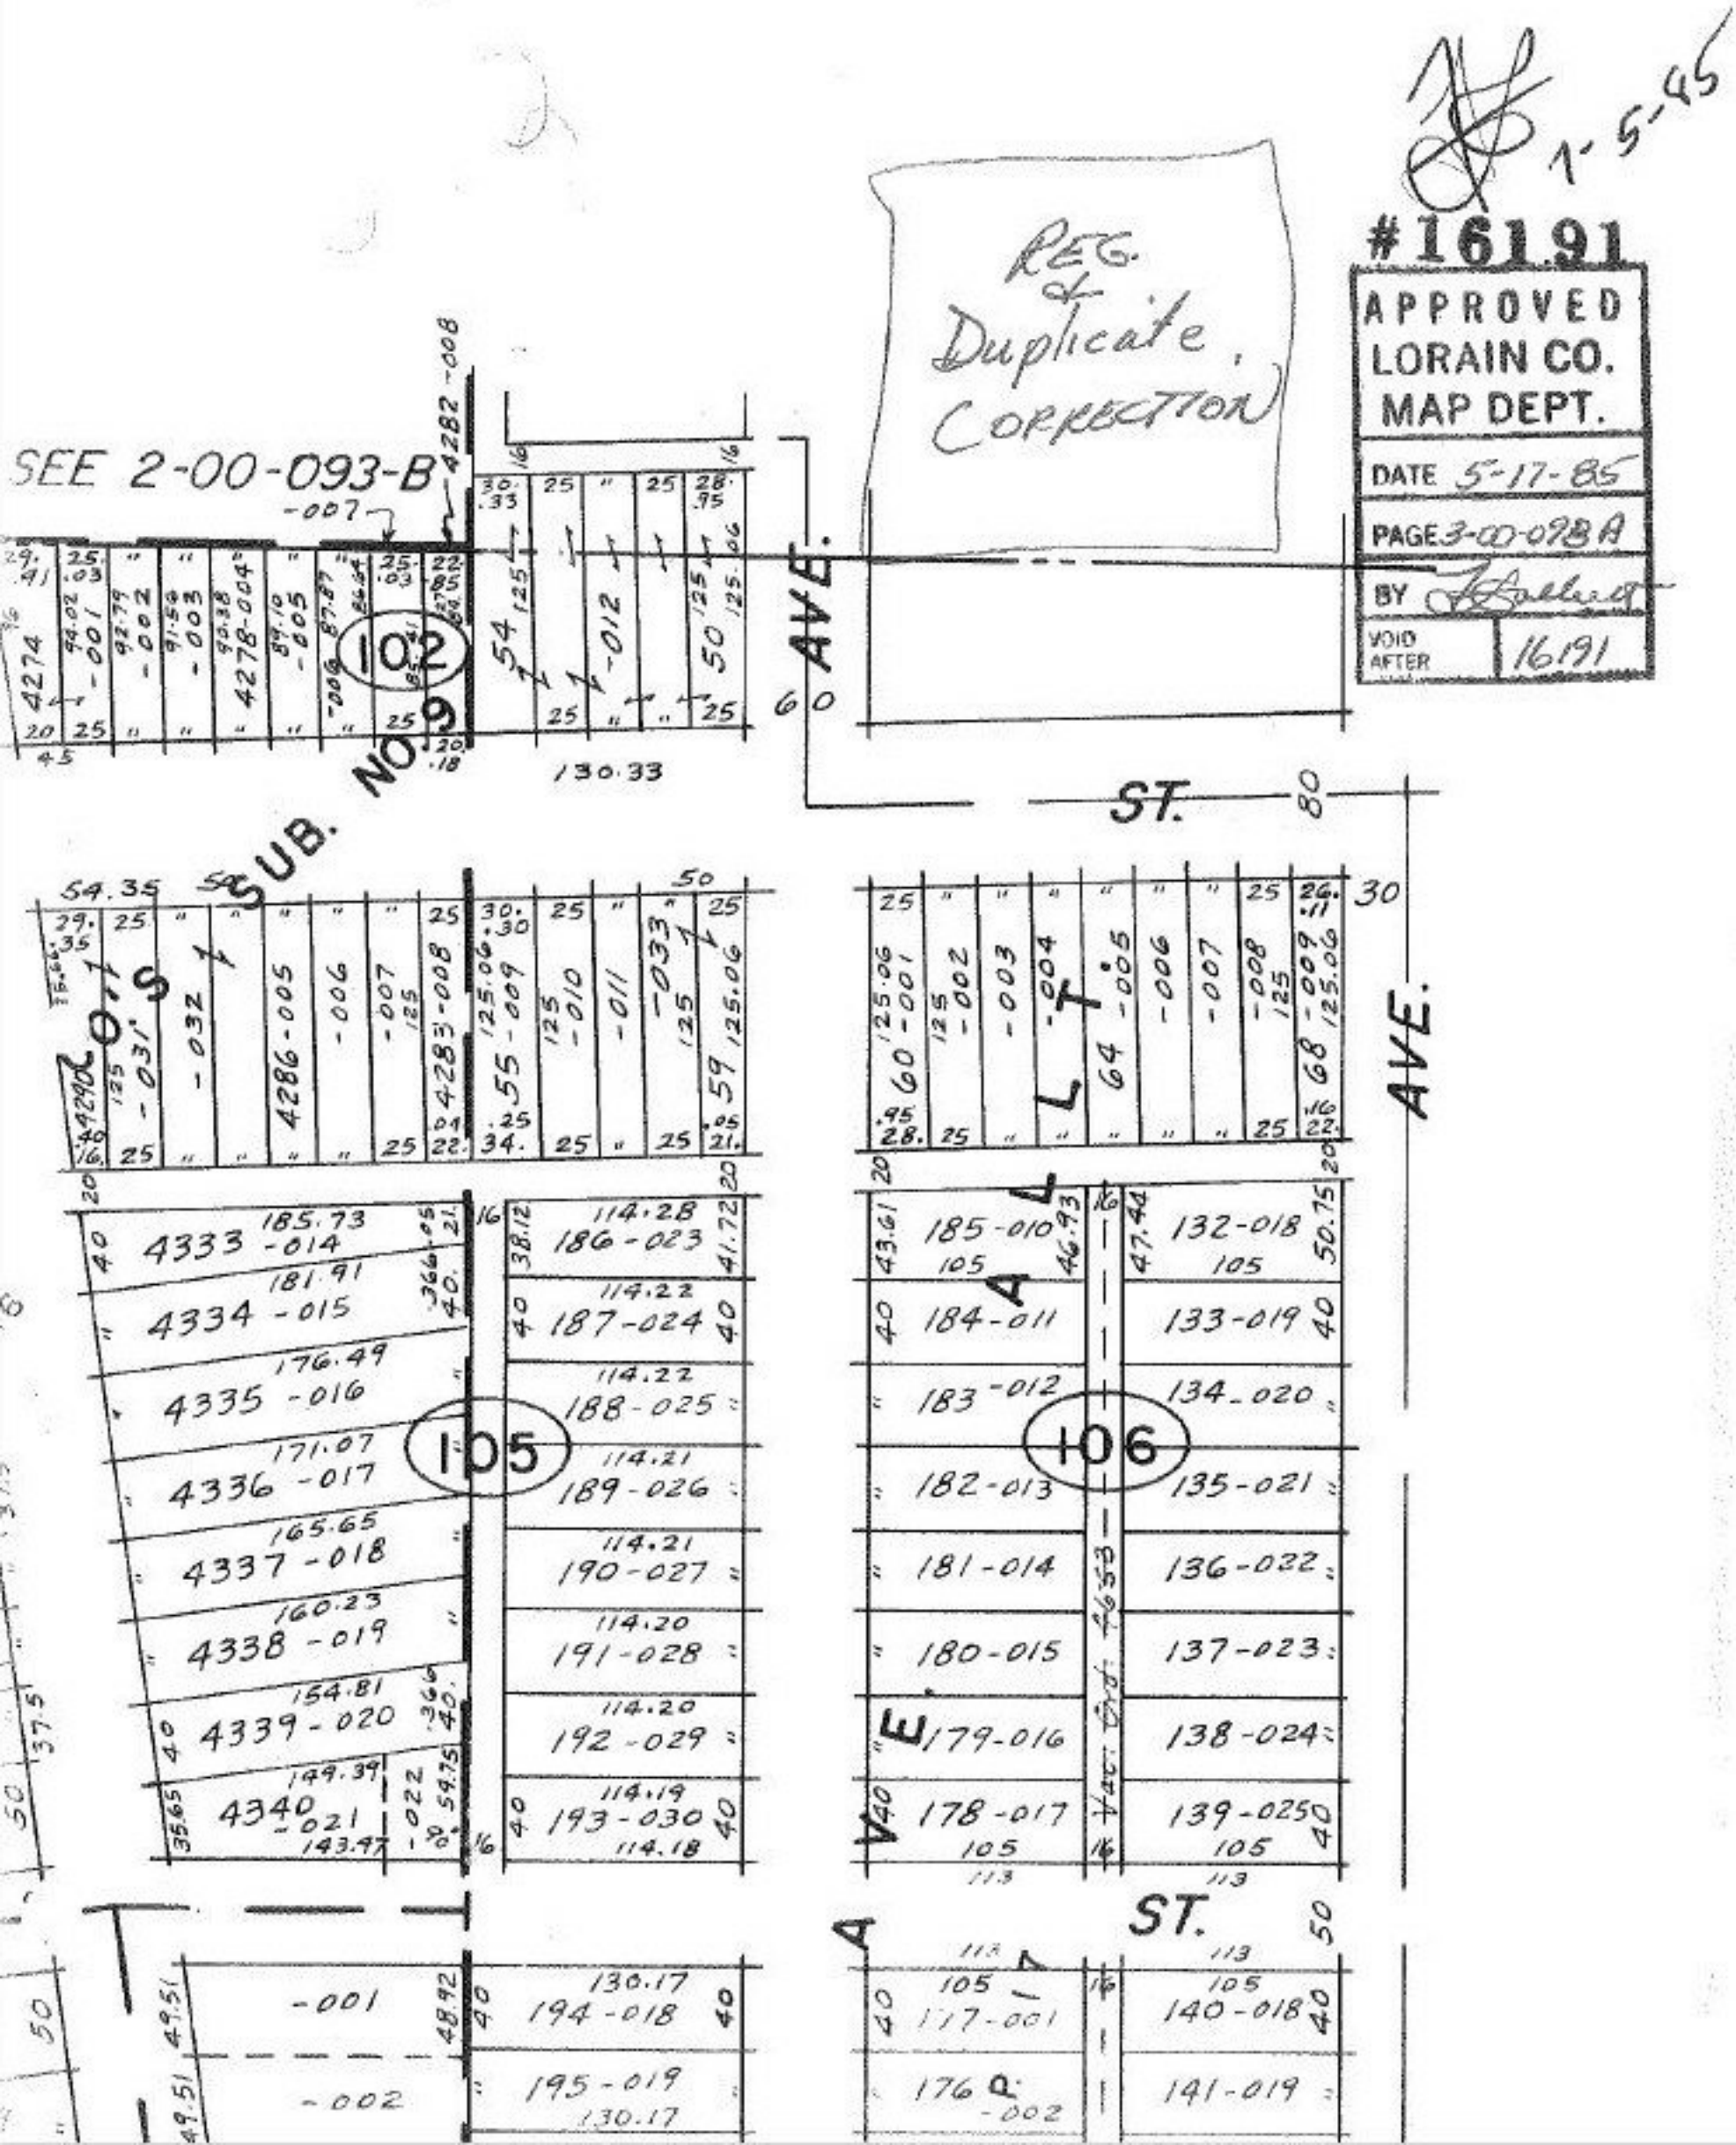

1-5-85
#16191
APPROVED
LORAIN CO.
MAP DEPT.
DATE 5-17-85
PAGE 3-00-098A
BY
VOID AFTER 16191
REG. & Duplicate CORRECTION
SEE 2-00-093-B
SUB. NO. 9
102
105
106
AVE.
ST.
130.33
4282-008
4274
4278-004
4286-005
4283-008
4290
4333-014
4334-015
4335-016
4336-017
4337-018
4338-019
4339-020
4340-021
186-023
187-024
188-025
189-026
190-027
191-028
192-029
193-030
194-018
195-019
185-010
184-011
183-012
182-013
181-014
180-015
179-016
178-017
177-001
176-002
132-018
133-019
134-020
135-021
136-022
137-023
138-024
139-025
140-018
141-019