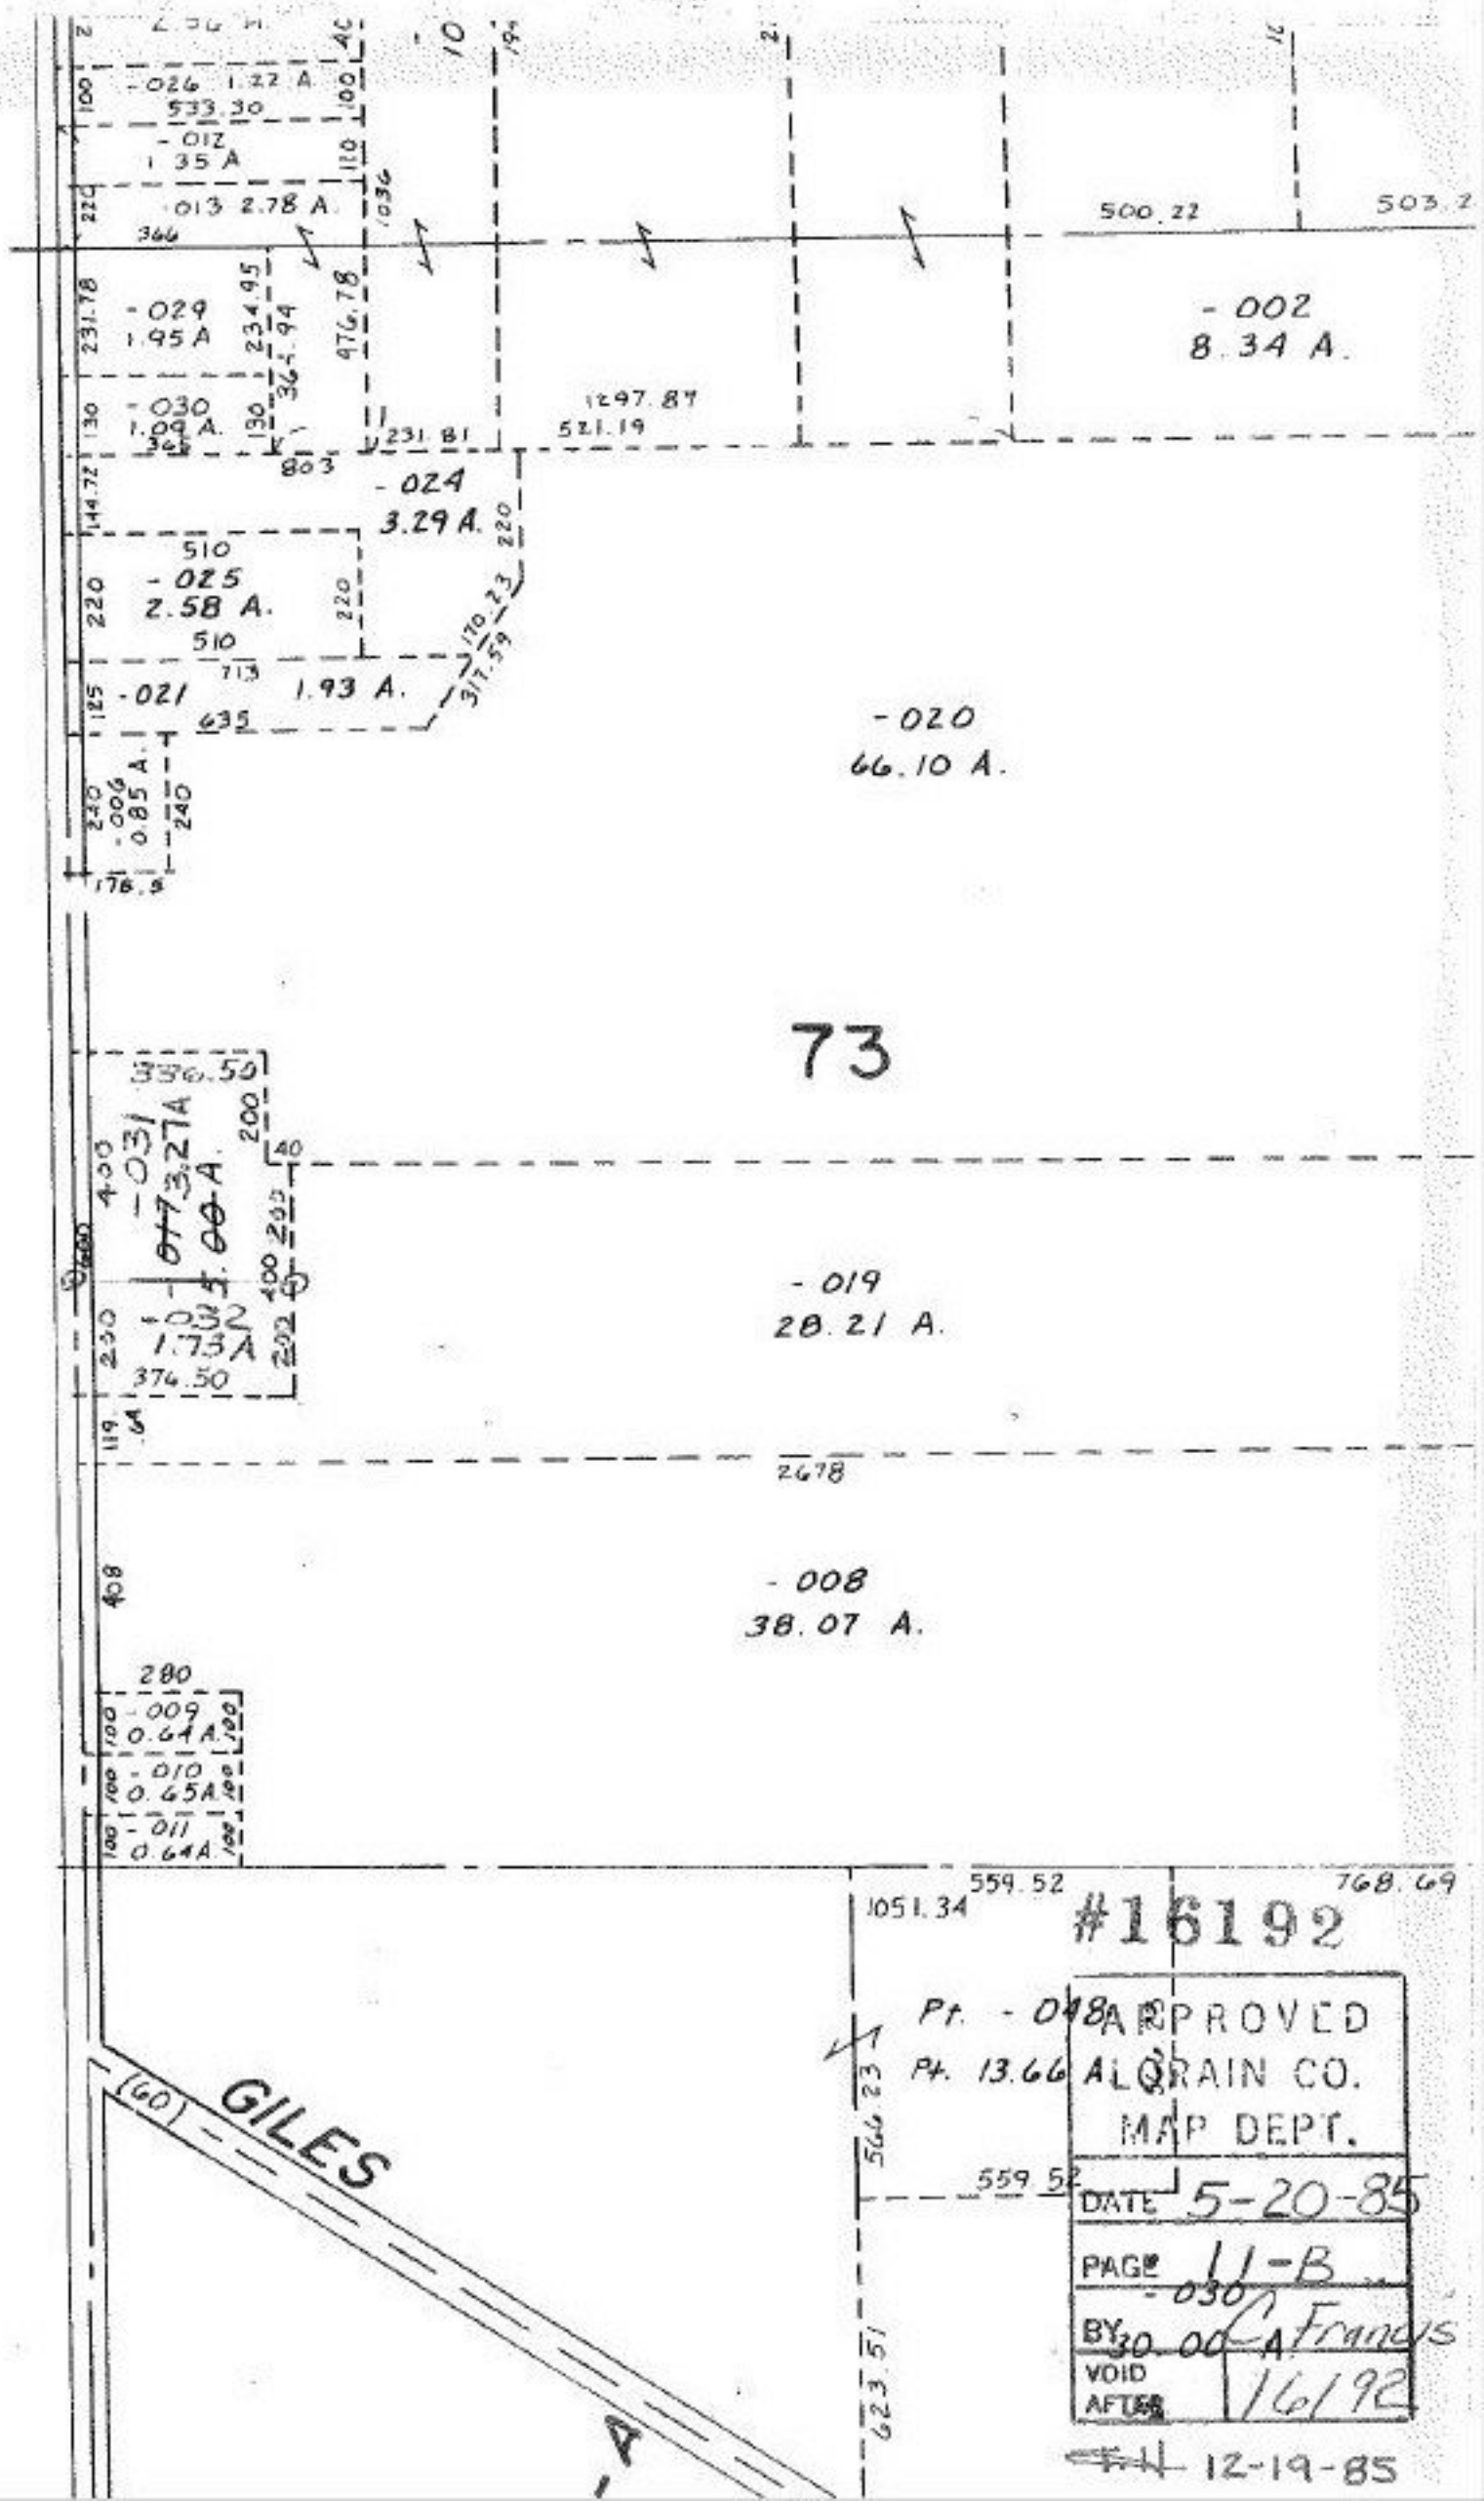

-026 1.22 A.
533.30
-012
1.35 A
-013 2.78 A.
366
500.22
503.2
-029
1.95 A
234.95
364.94
476.78
-002
8.34 A.
-030
1.09 A.
365
1297.87
521.19
231.81
803
-024
3.29 A.
510
-025
2.58 A.
510
713
-021
1.93 A.
635
170.23
317.59
-020
66.10 A.
-006
0.85 A.
240
176.5
73
336.50
-031
3.27A
-032
1.73A
374.50
-019
28.21 A.
2678
-008
38.07 A.
280
-009
0.64 A.
-010
0.65A
-011
0.64A
559.52
768.69
1051.34
#16192
Pt. -048
Pt. 13.66 A
APPROVED
LORAIN CO.
MAP DEPT.
DATE 5-20-85
PAGE 11-B
BY -030 30.00 A Francis
VOID AFTER 16192
(60)
GILES
566.23
559.52
623.51
12-19-85