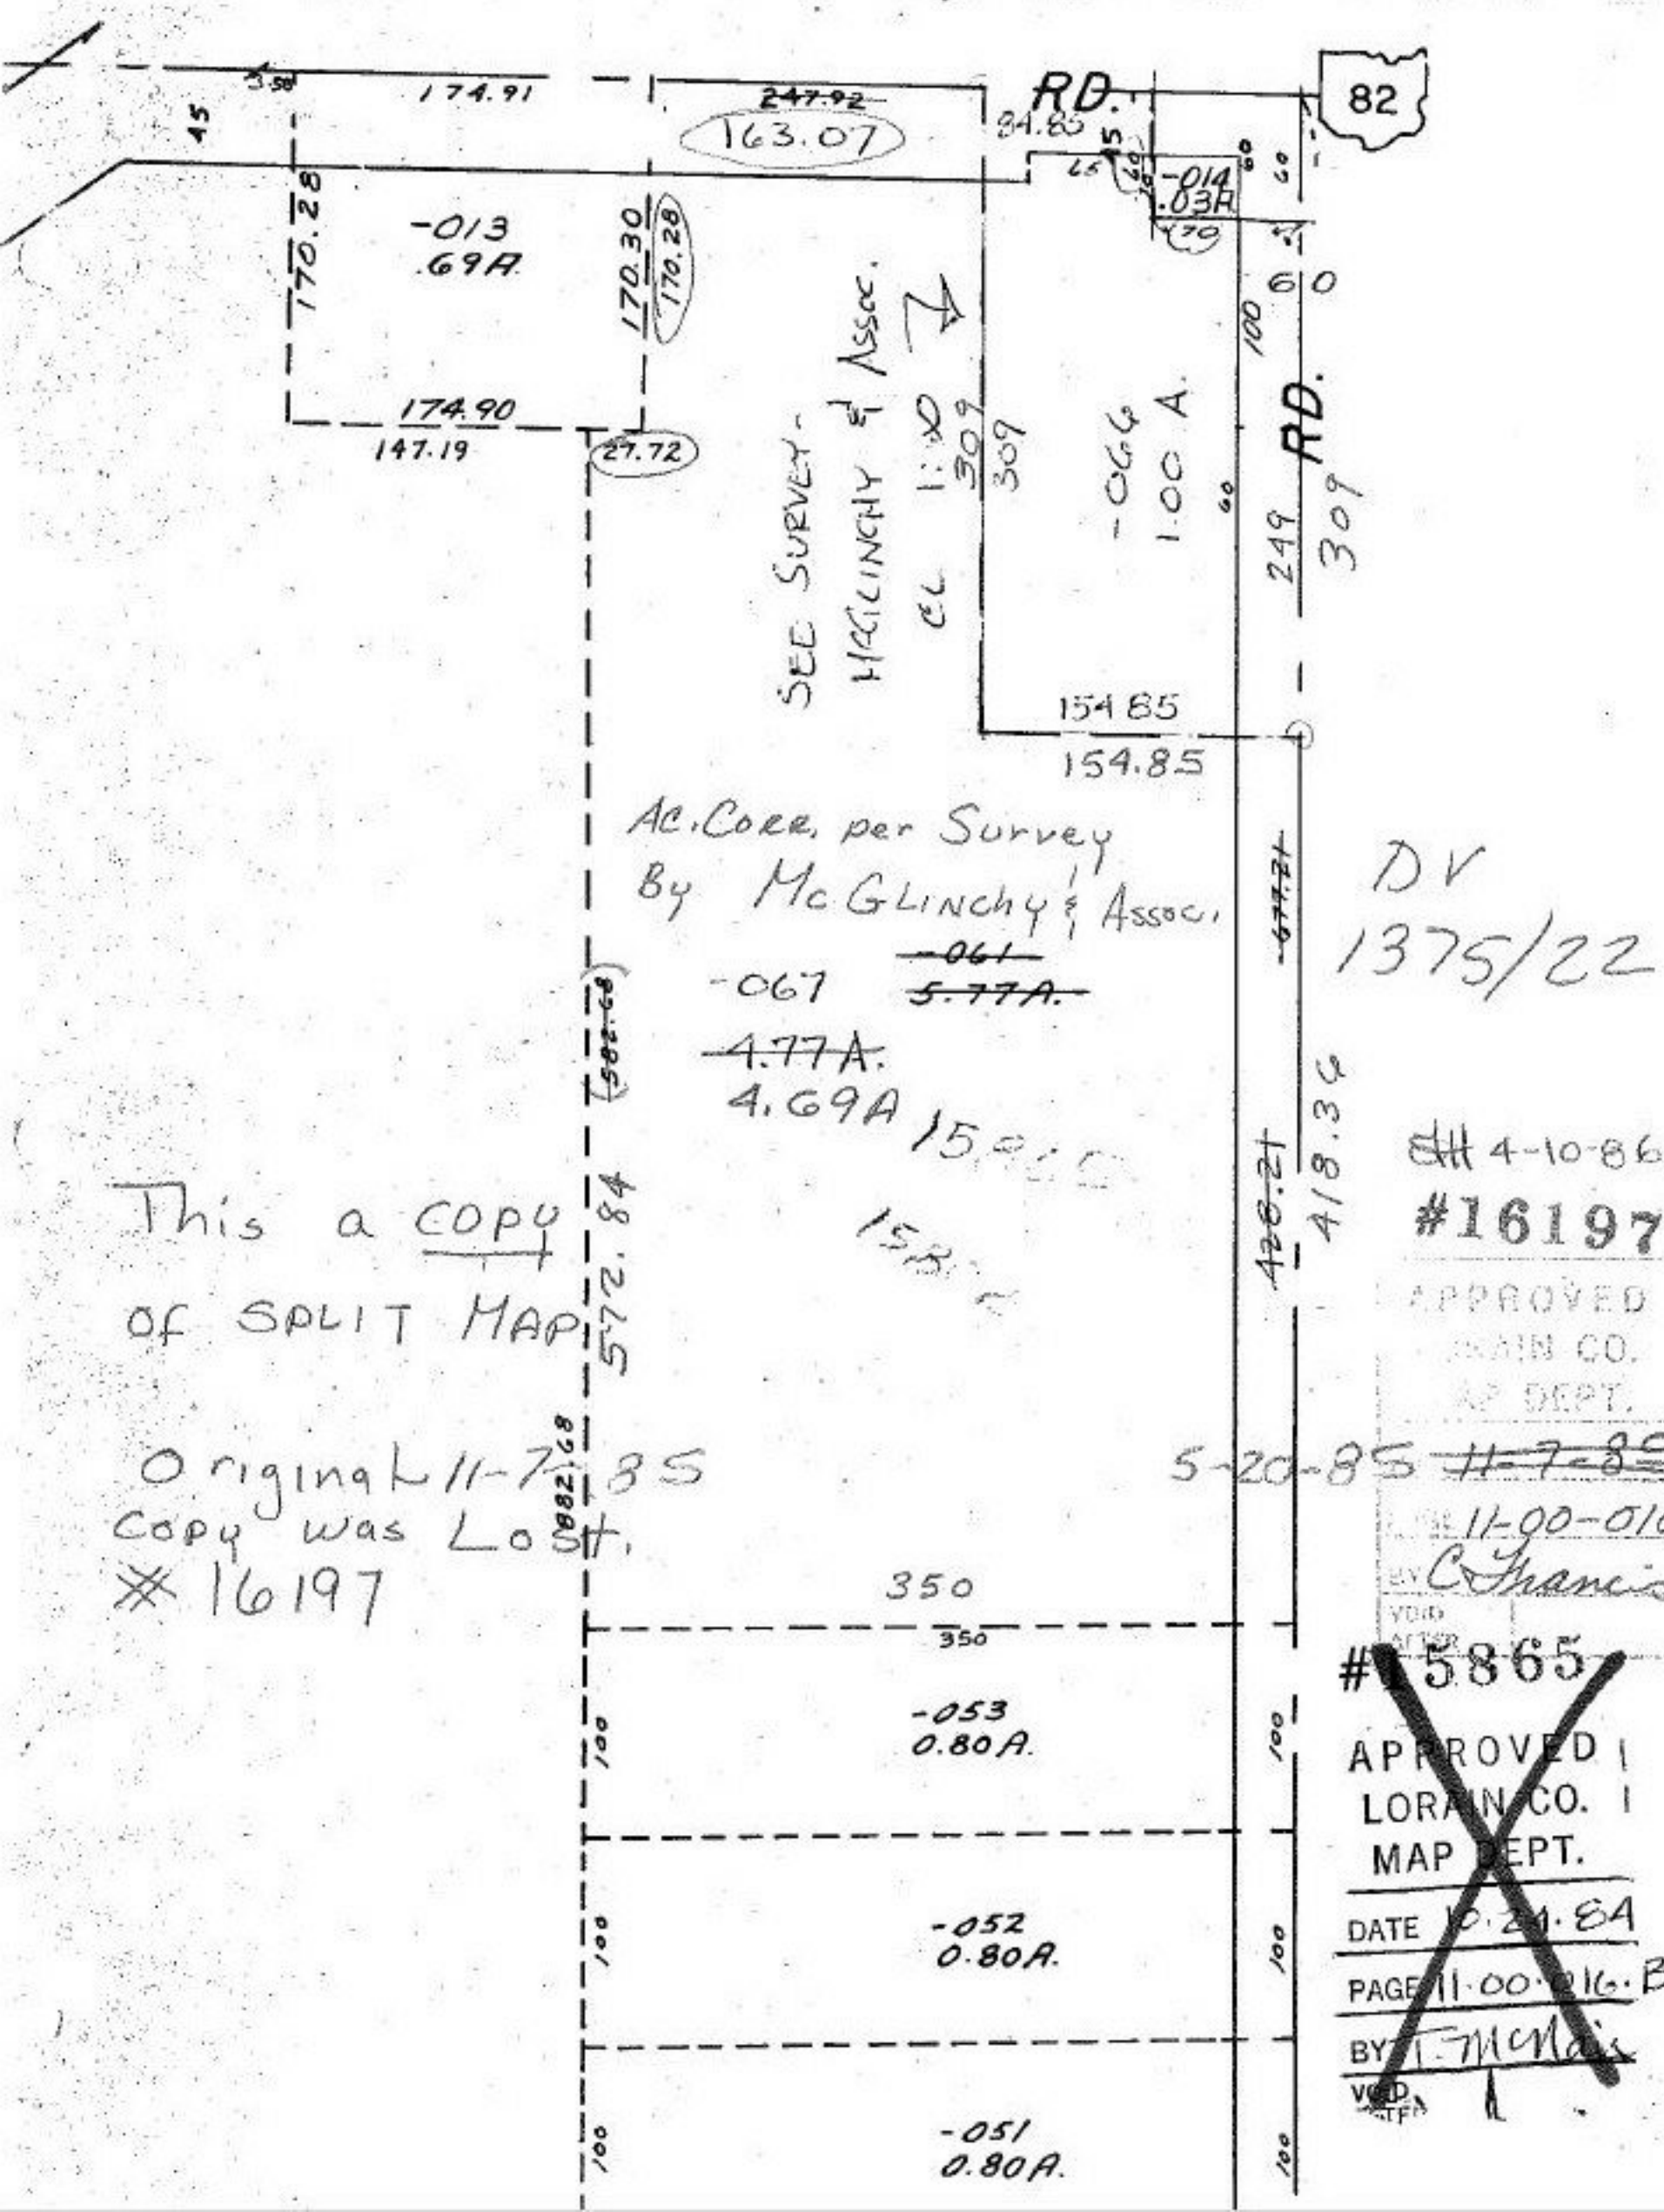

DV
1375/22

This a COPY
of SPLIT MAP

Original 11-7-85
Copy was Lost.
16197

4-10-86
#16197
APPROVED
LORAIN CO.
MAP DEPT.
5-20-85 ~~11-7-85~~
11-00-016-B
BY C Francis
VOID
AFTER

#15865
APPROVED
LORAIN CO.
MAP DEPT.
DATE 10.24.84
PAGE 11.00.016.B
BY T. McNair
VOID
AFTER