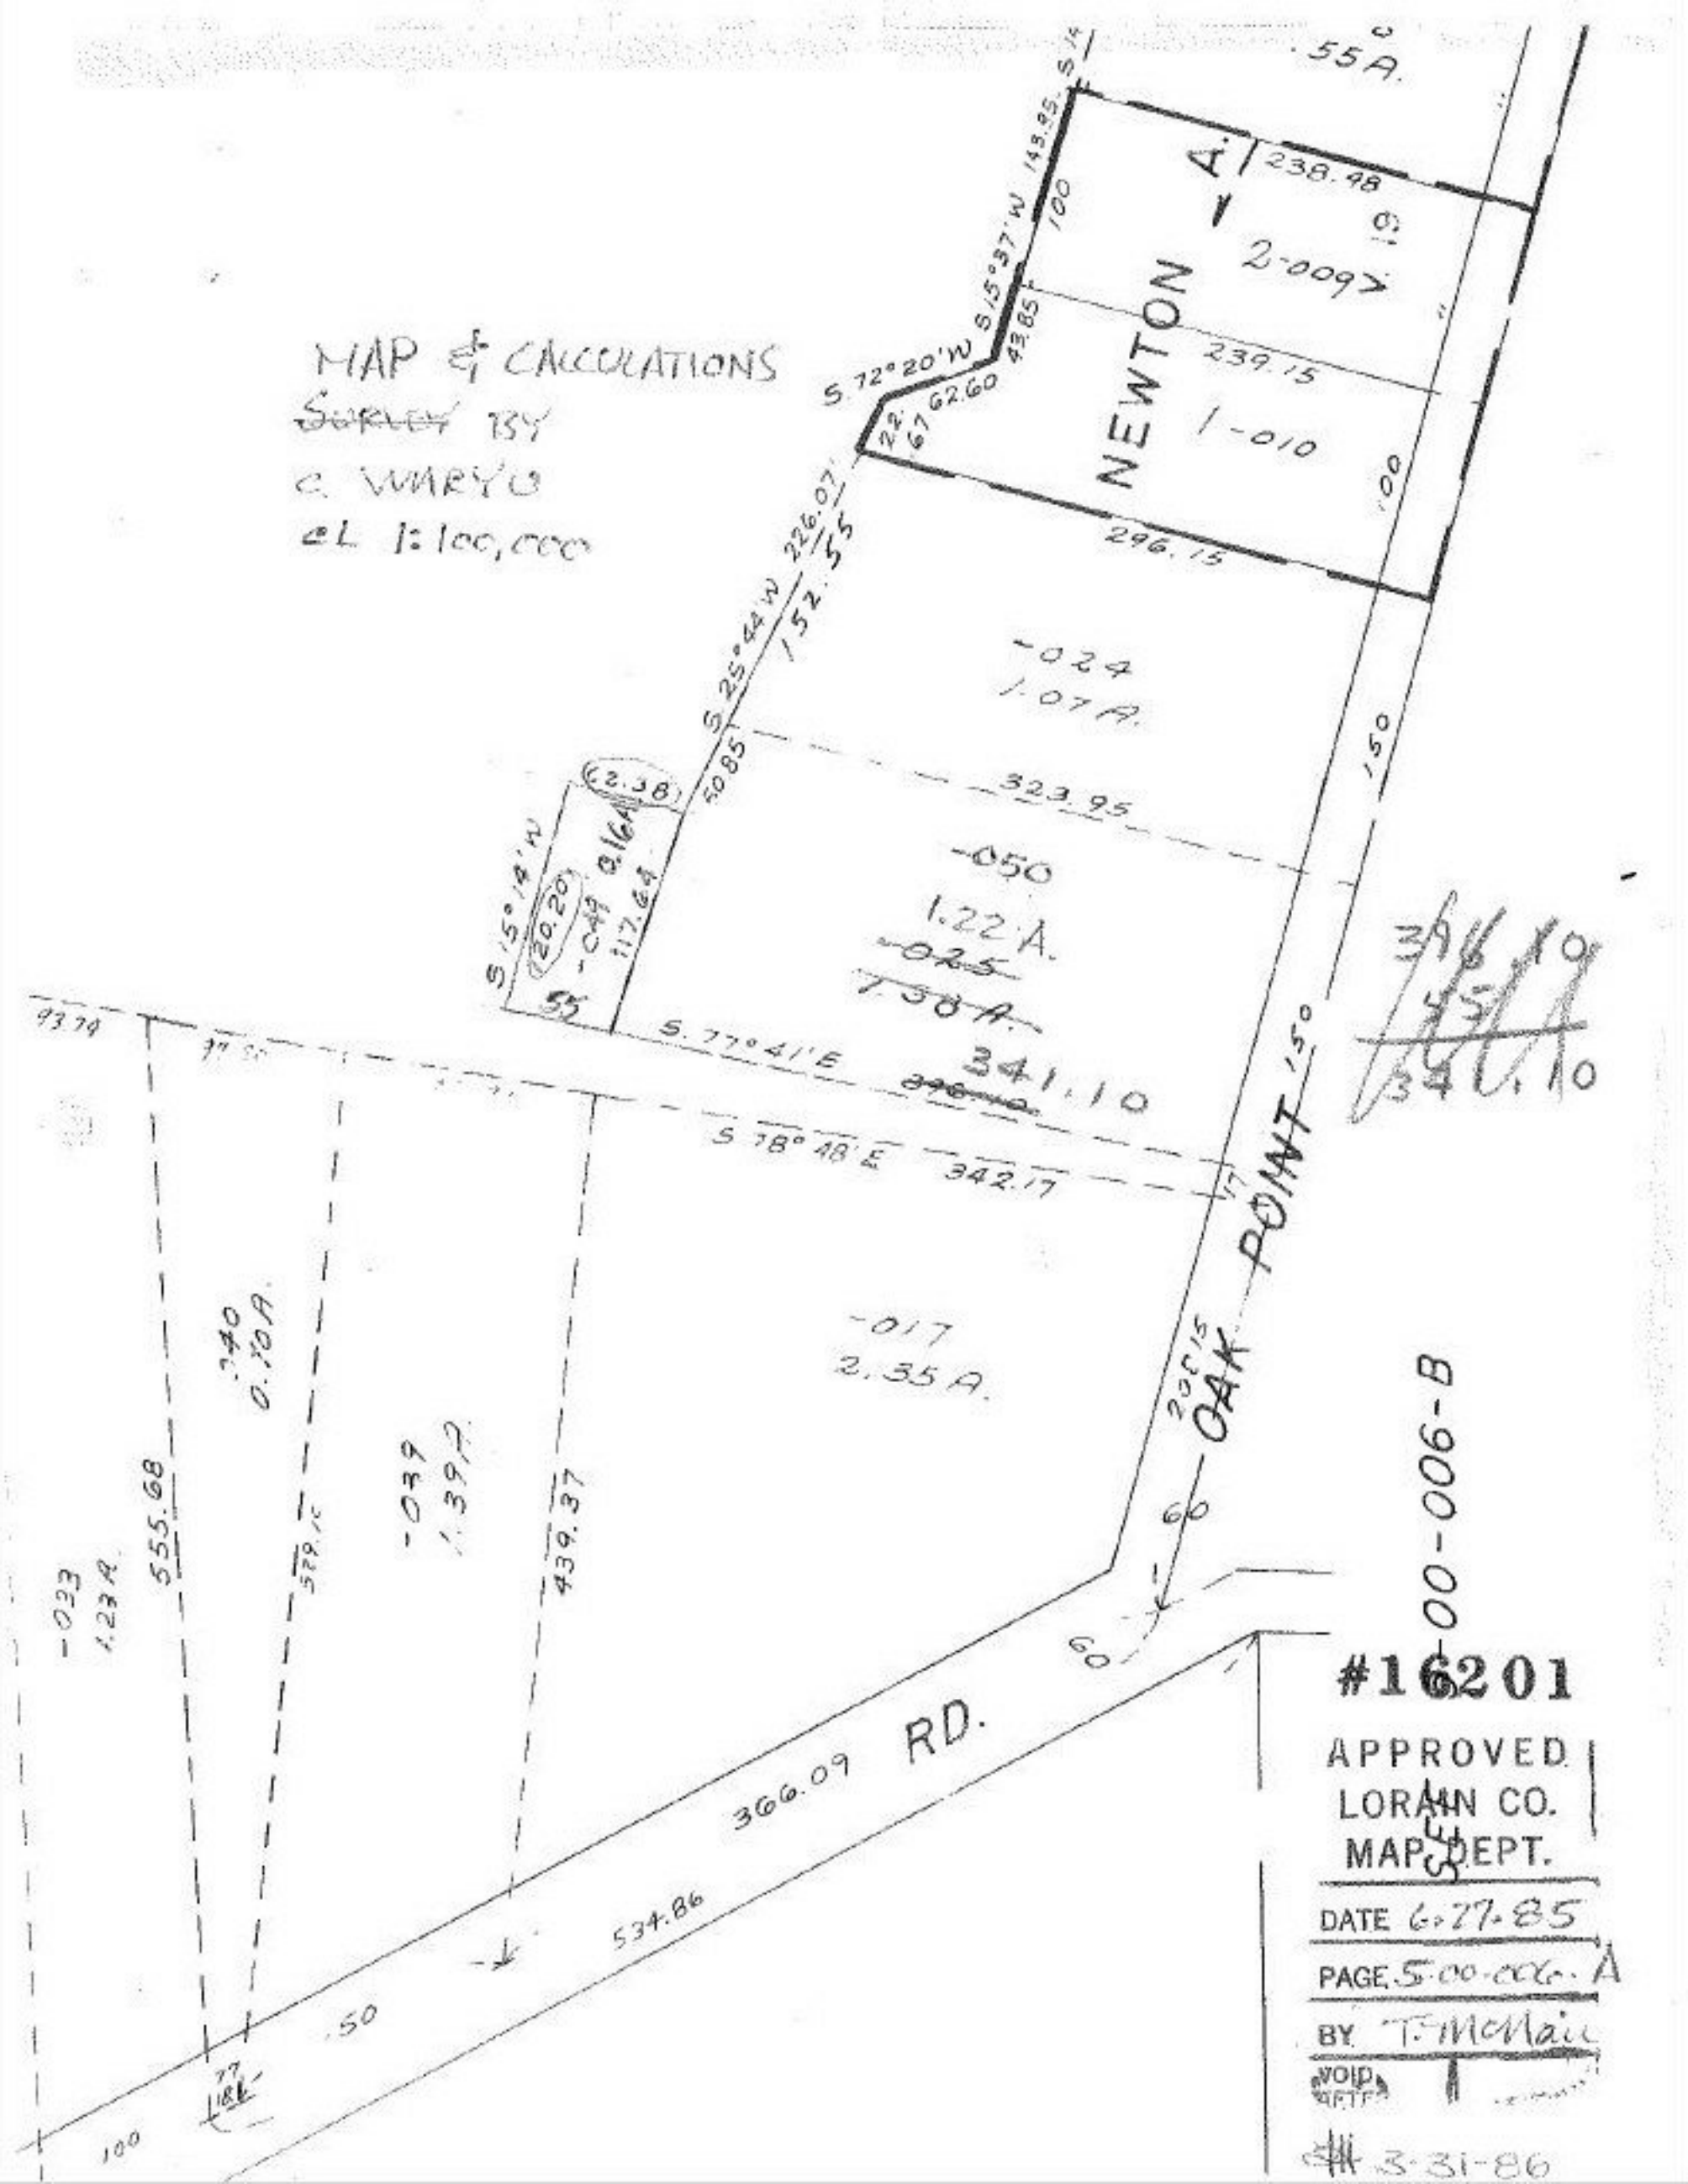
MAP & CALCULATIONS
~~SURVEY~~ BY
C. WARYO
@ 1:100,000
NEWTON
A.
238.48
2-009
239.15
1-010
296.15
S 72°20'W
S 15°37'W
143.95
100
43.85
62.60
226.07
152.55
S 25°44'W
-024
1.07 A.
323.95
-050
1.22 A.
~~-025~~
~~1.38 A.~~
341.10
S 15°14'W
62.38
120.20
-049
0.16 A.
117.64
55
S 77°41'E
S 78°48'E
342.17
-017
2.35 A.
OAK POINT
150
60
-033
1.23 A.
555.68
-040
0.70 A.
-039
1.39 A.
439.37
366.09
RD.
534.86
50
100
SEE 5-00-006-B
#16201
APPROVED
LORAIN CO.
MAP DEPT.
DATE 6-27-85
PAGE 5-00-006-A
BY T. McNair
VOID
3-31-86