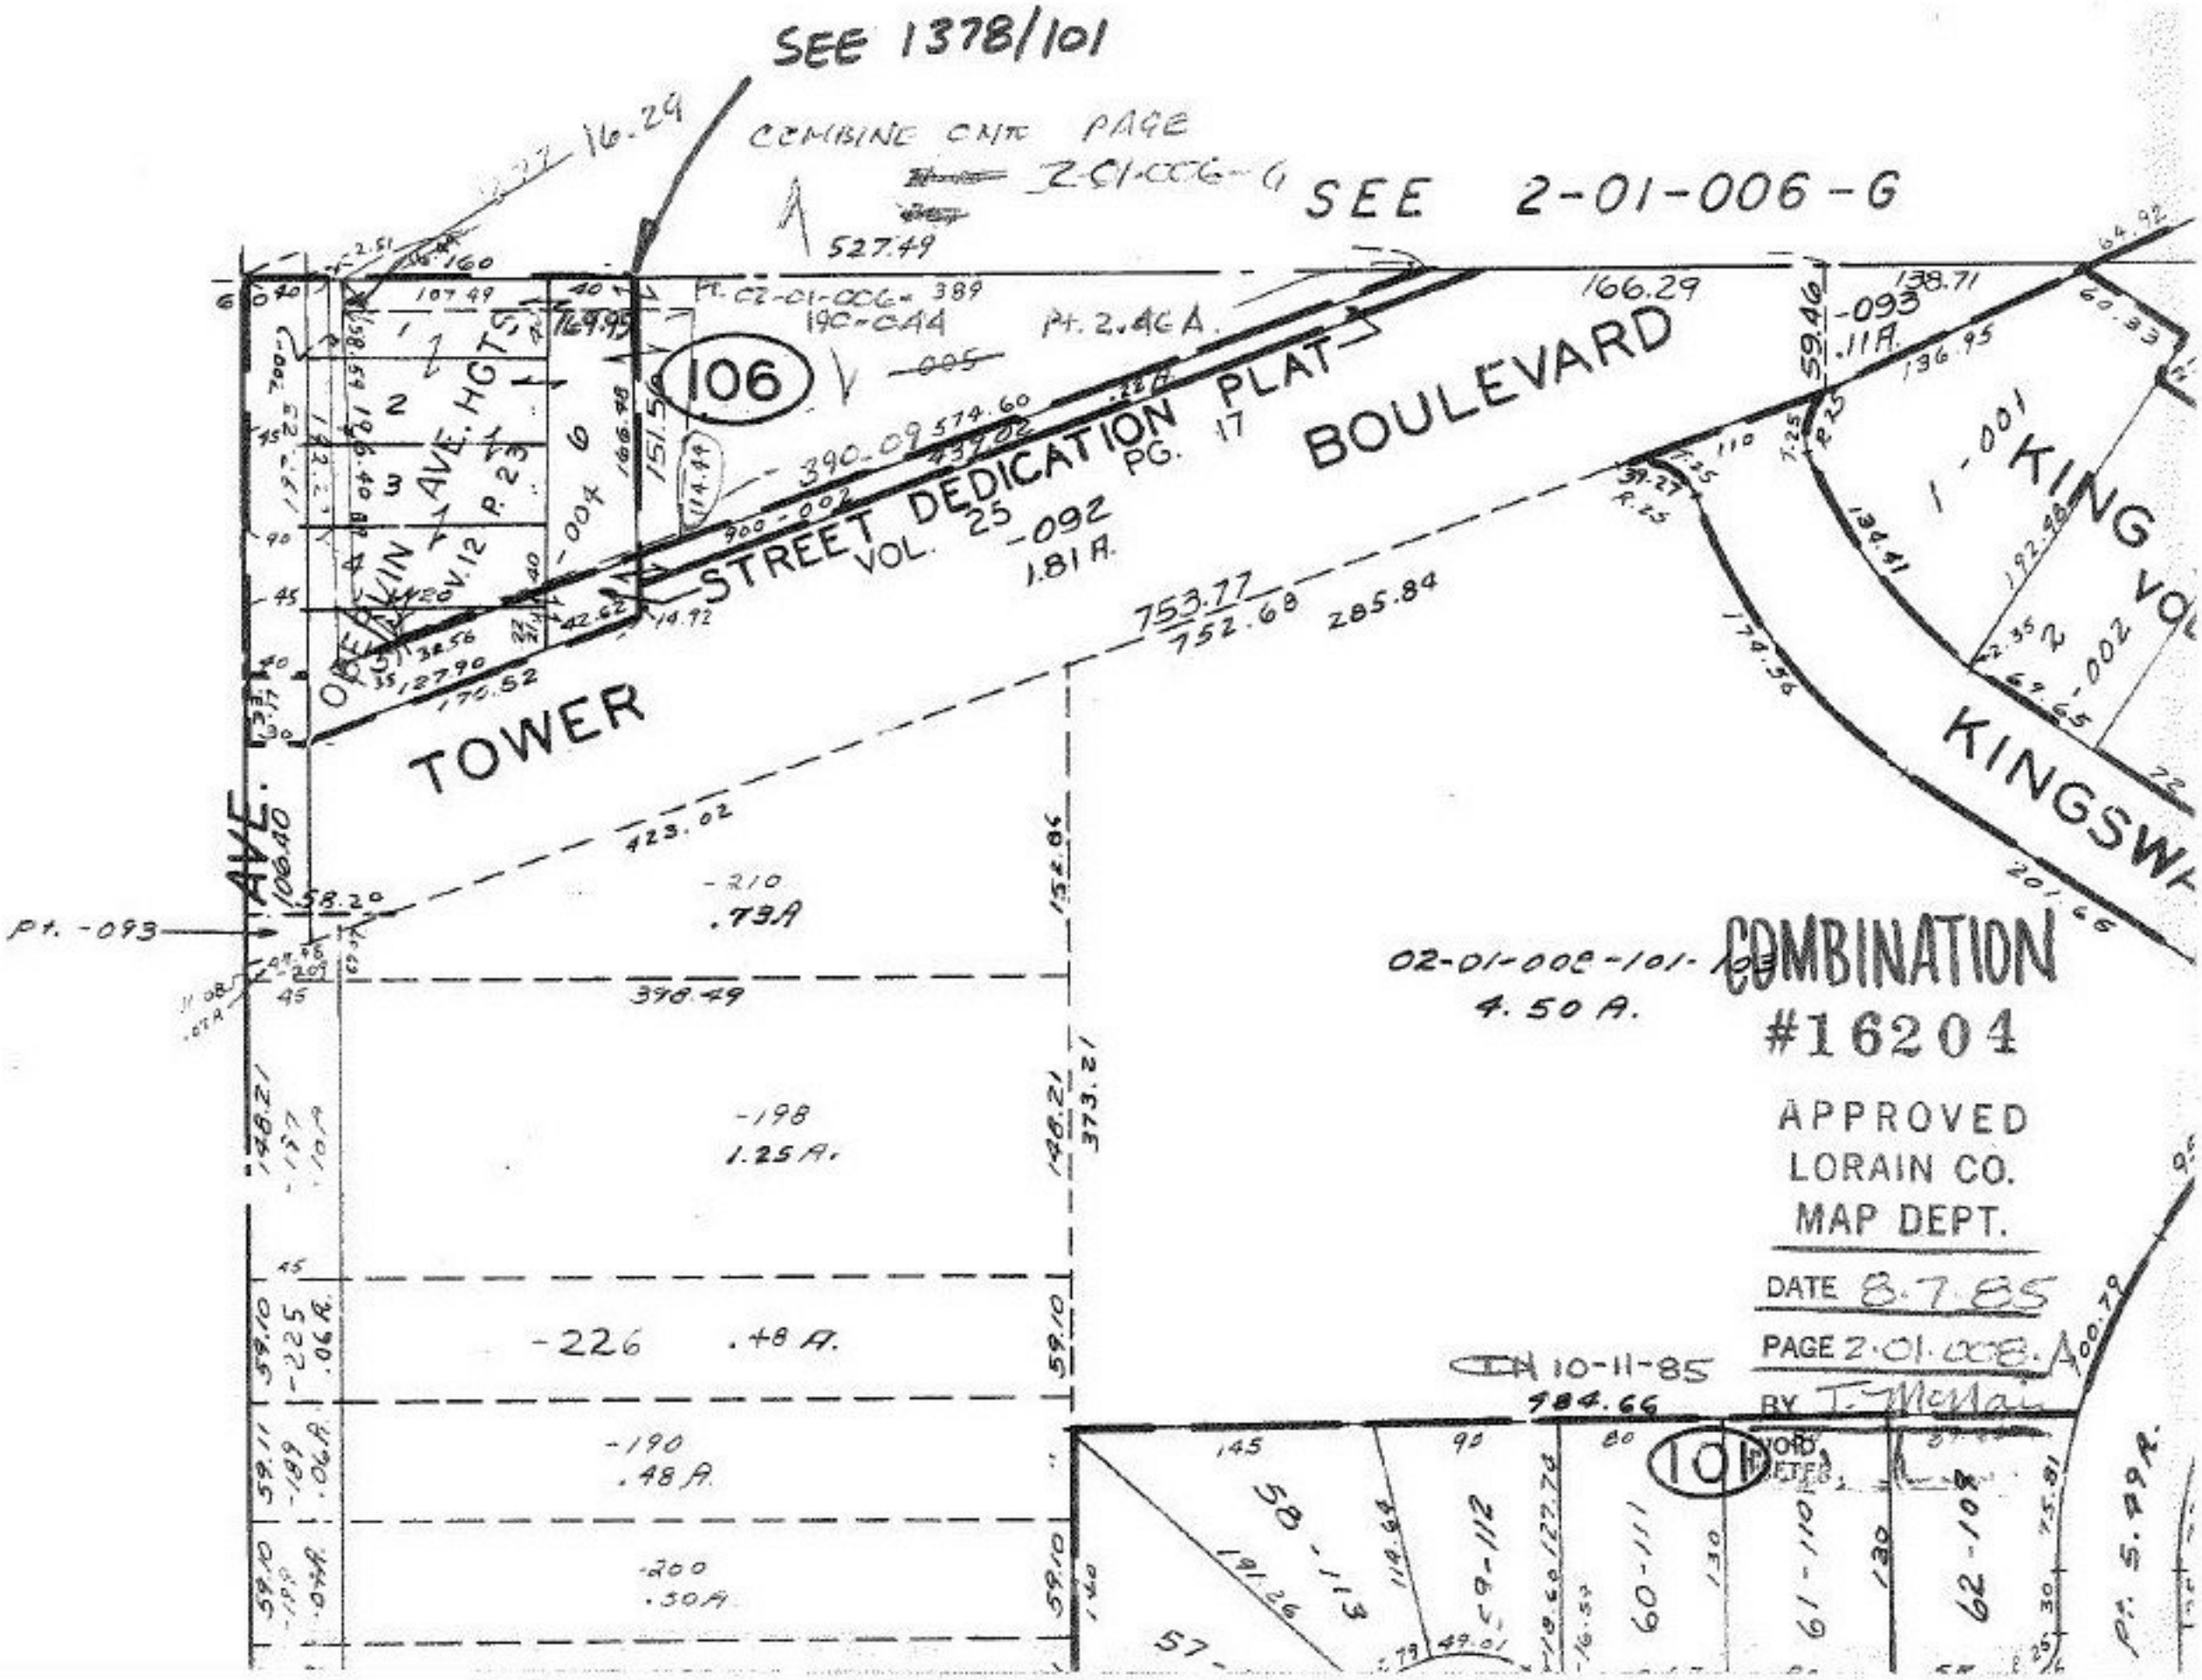
SEE 1378/101
COMBINE ONTO PAGE
2-01-006-G
SEE 2-01-006-G
527.49
16.29
106
Pt. 02-01-006-389
190-044
Pt. 2.46 A.
166.29
138.71
-093
.11 A.
59.46
136.95
BOULEVARD
STREET DEDICATION PLAT
VOL. 25 PG. 17
-092
1.81 A.
390.09
574.60
TOWER
AVE.
OBERLIN AVE. HGTS.
V.12 P.23
KING
KINGSW
753.77
752.68
285.84
423.02
-210
.73 A
398.49
Pt. -093
-198
1.25 A.
148.21
373.21
-226
.48 A.
-190
.48 A.
-200
.50 A
59.10
59.11
-225
.06 A.
-189
.06 A.
-199
.04 A.
152.86
02-01-008-101-103
4.50 A.
COMBINATION
#16204
APPROVED
LORAIN CO.
MAP DEPT.
DATE 8.7.85
PAGE 2-01-008-A
BY T. McNair
VOID
10-11-85
984.66
101
58-113
59-112
60-111
61-110
62-109
Pt. 5.99 A.