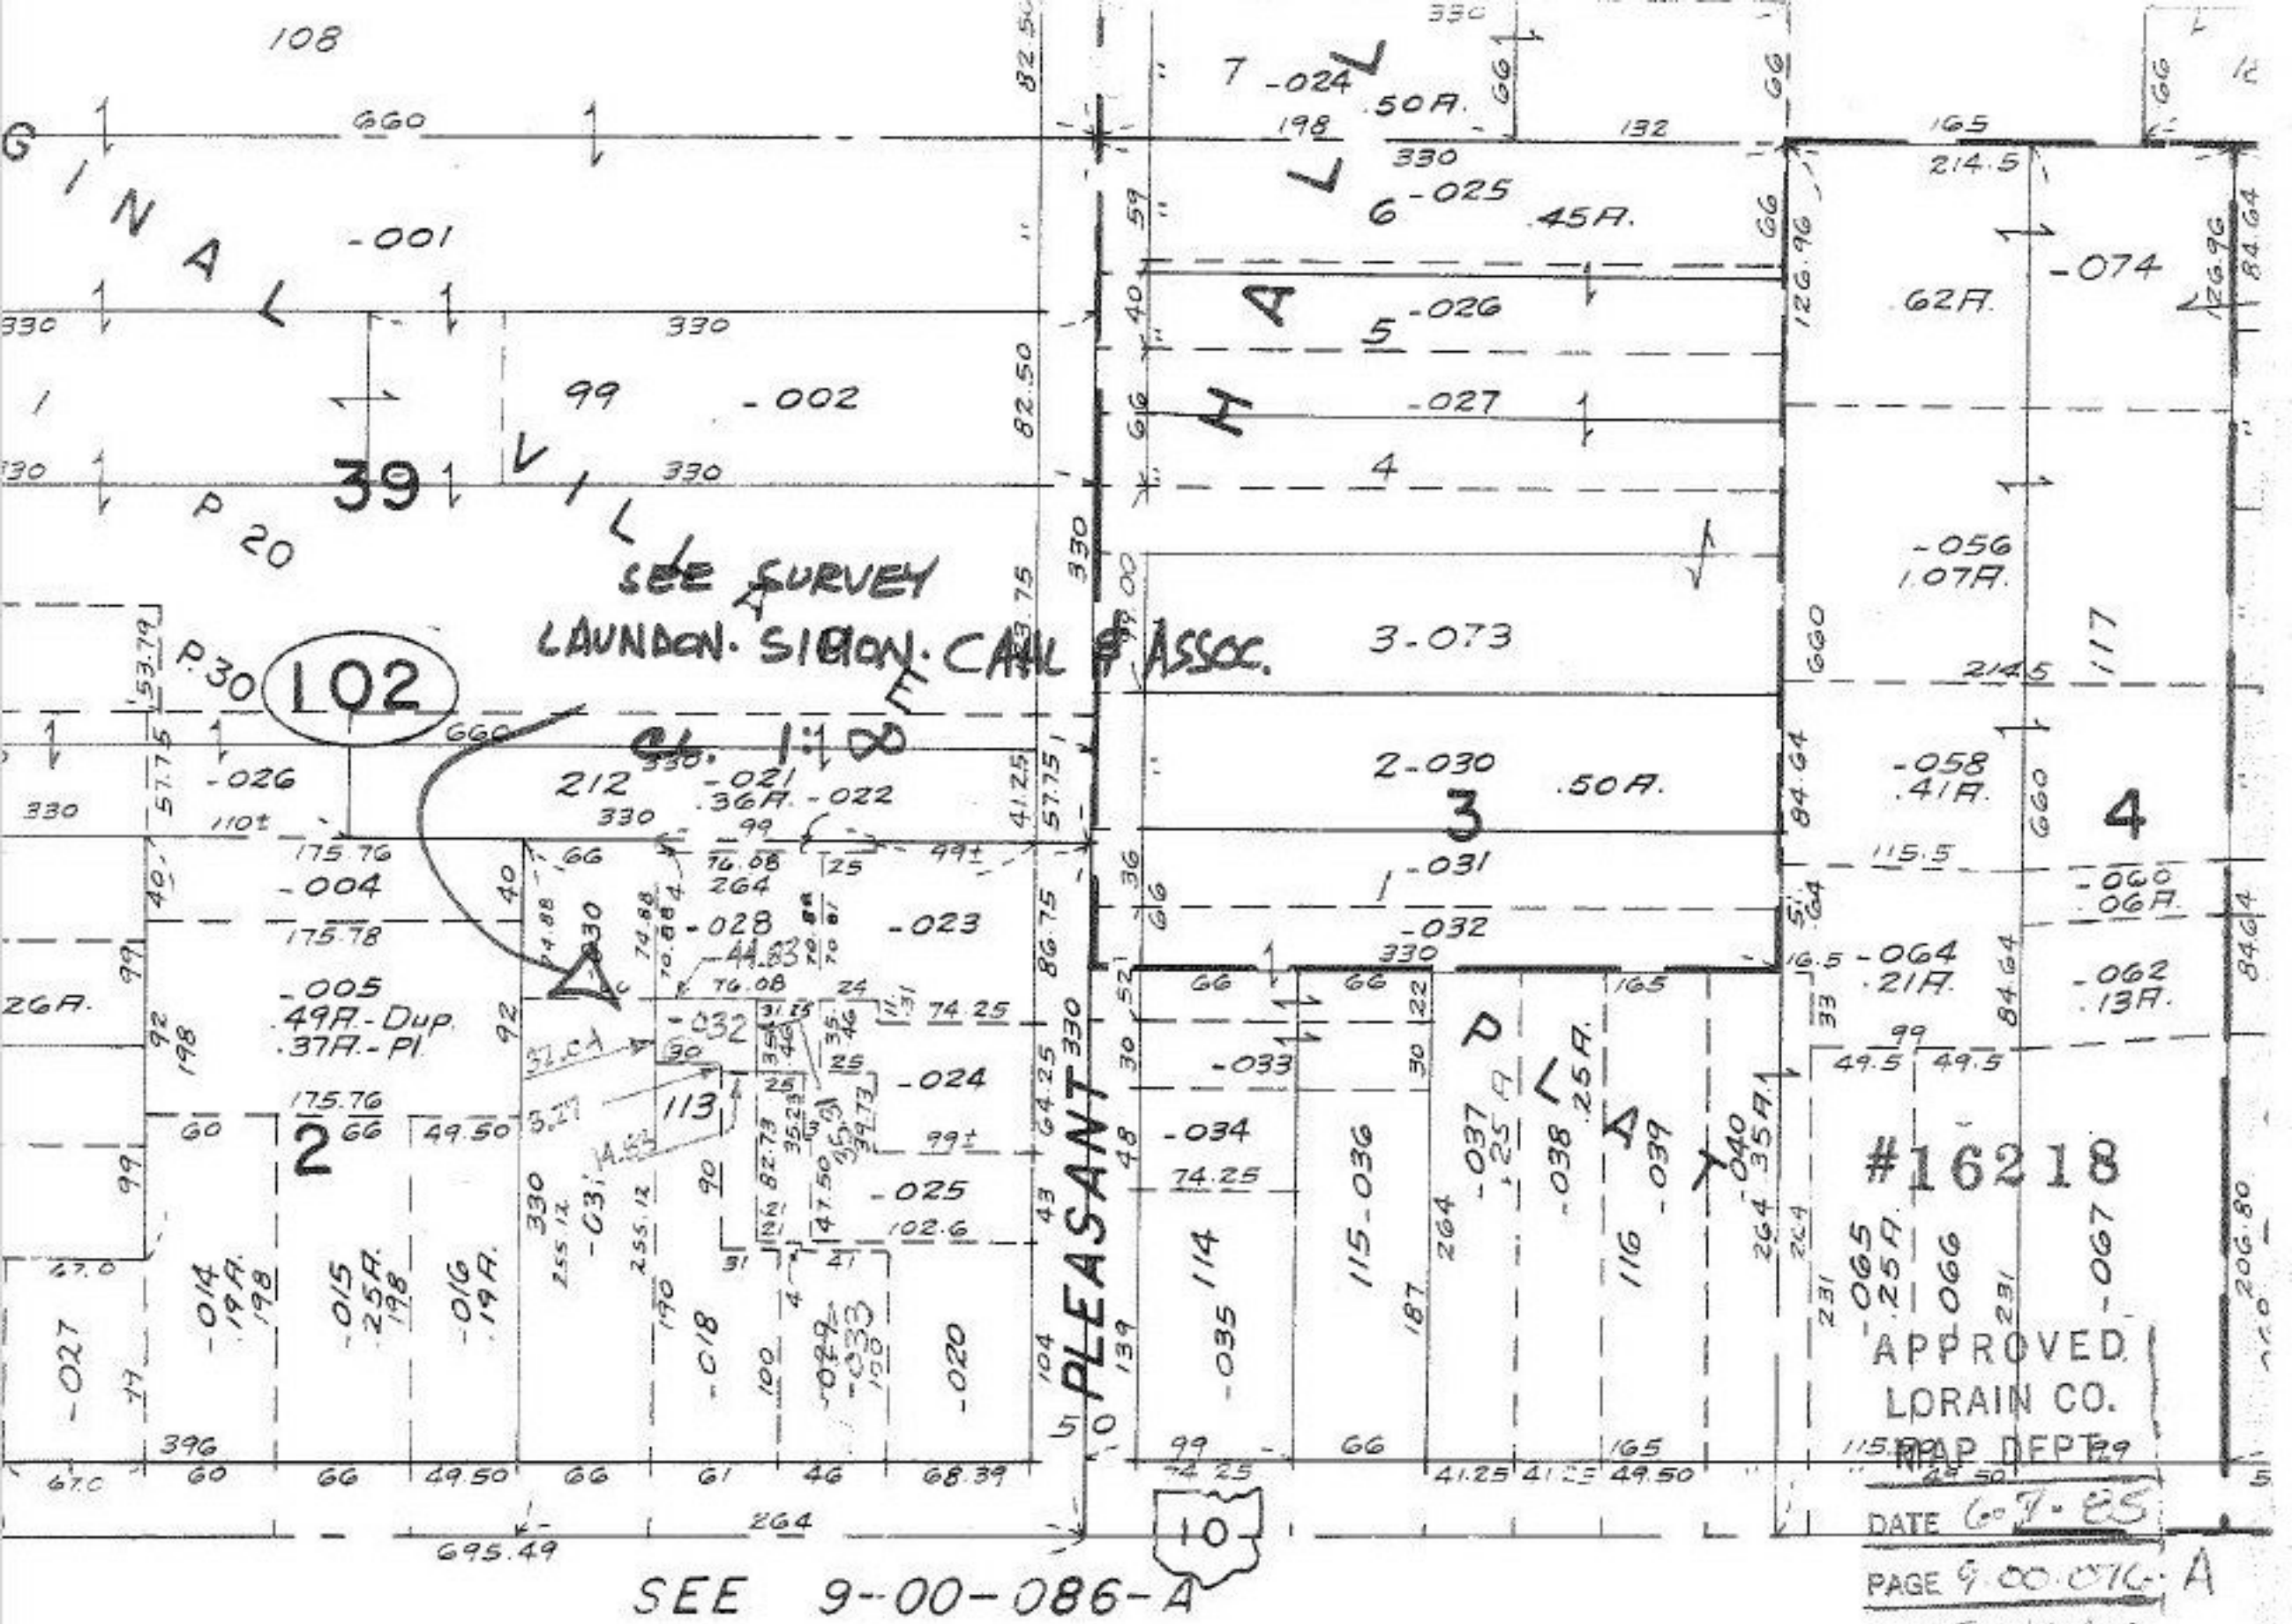

APPROVED
LORAIN CO.
MAP DEPT.

DATE 6-7-85
PAGE 9-00-076-A
BY T. McNair
VOID.
4-9-86