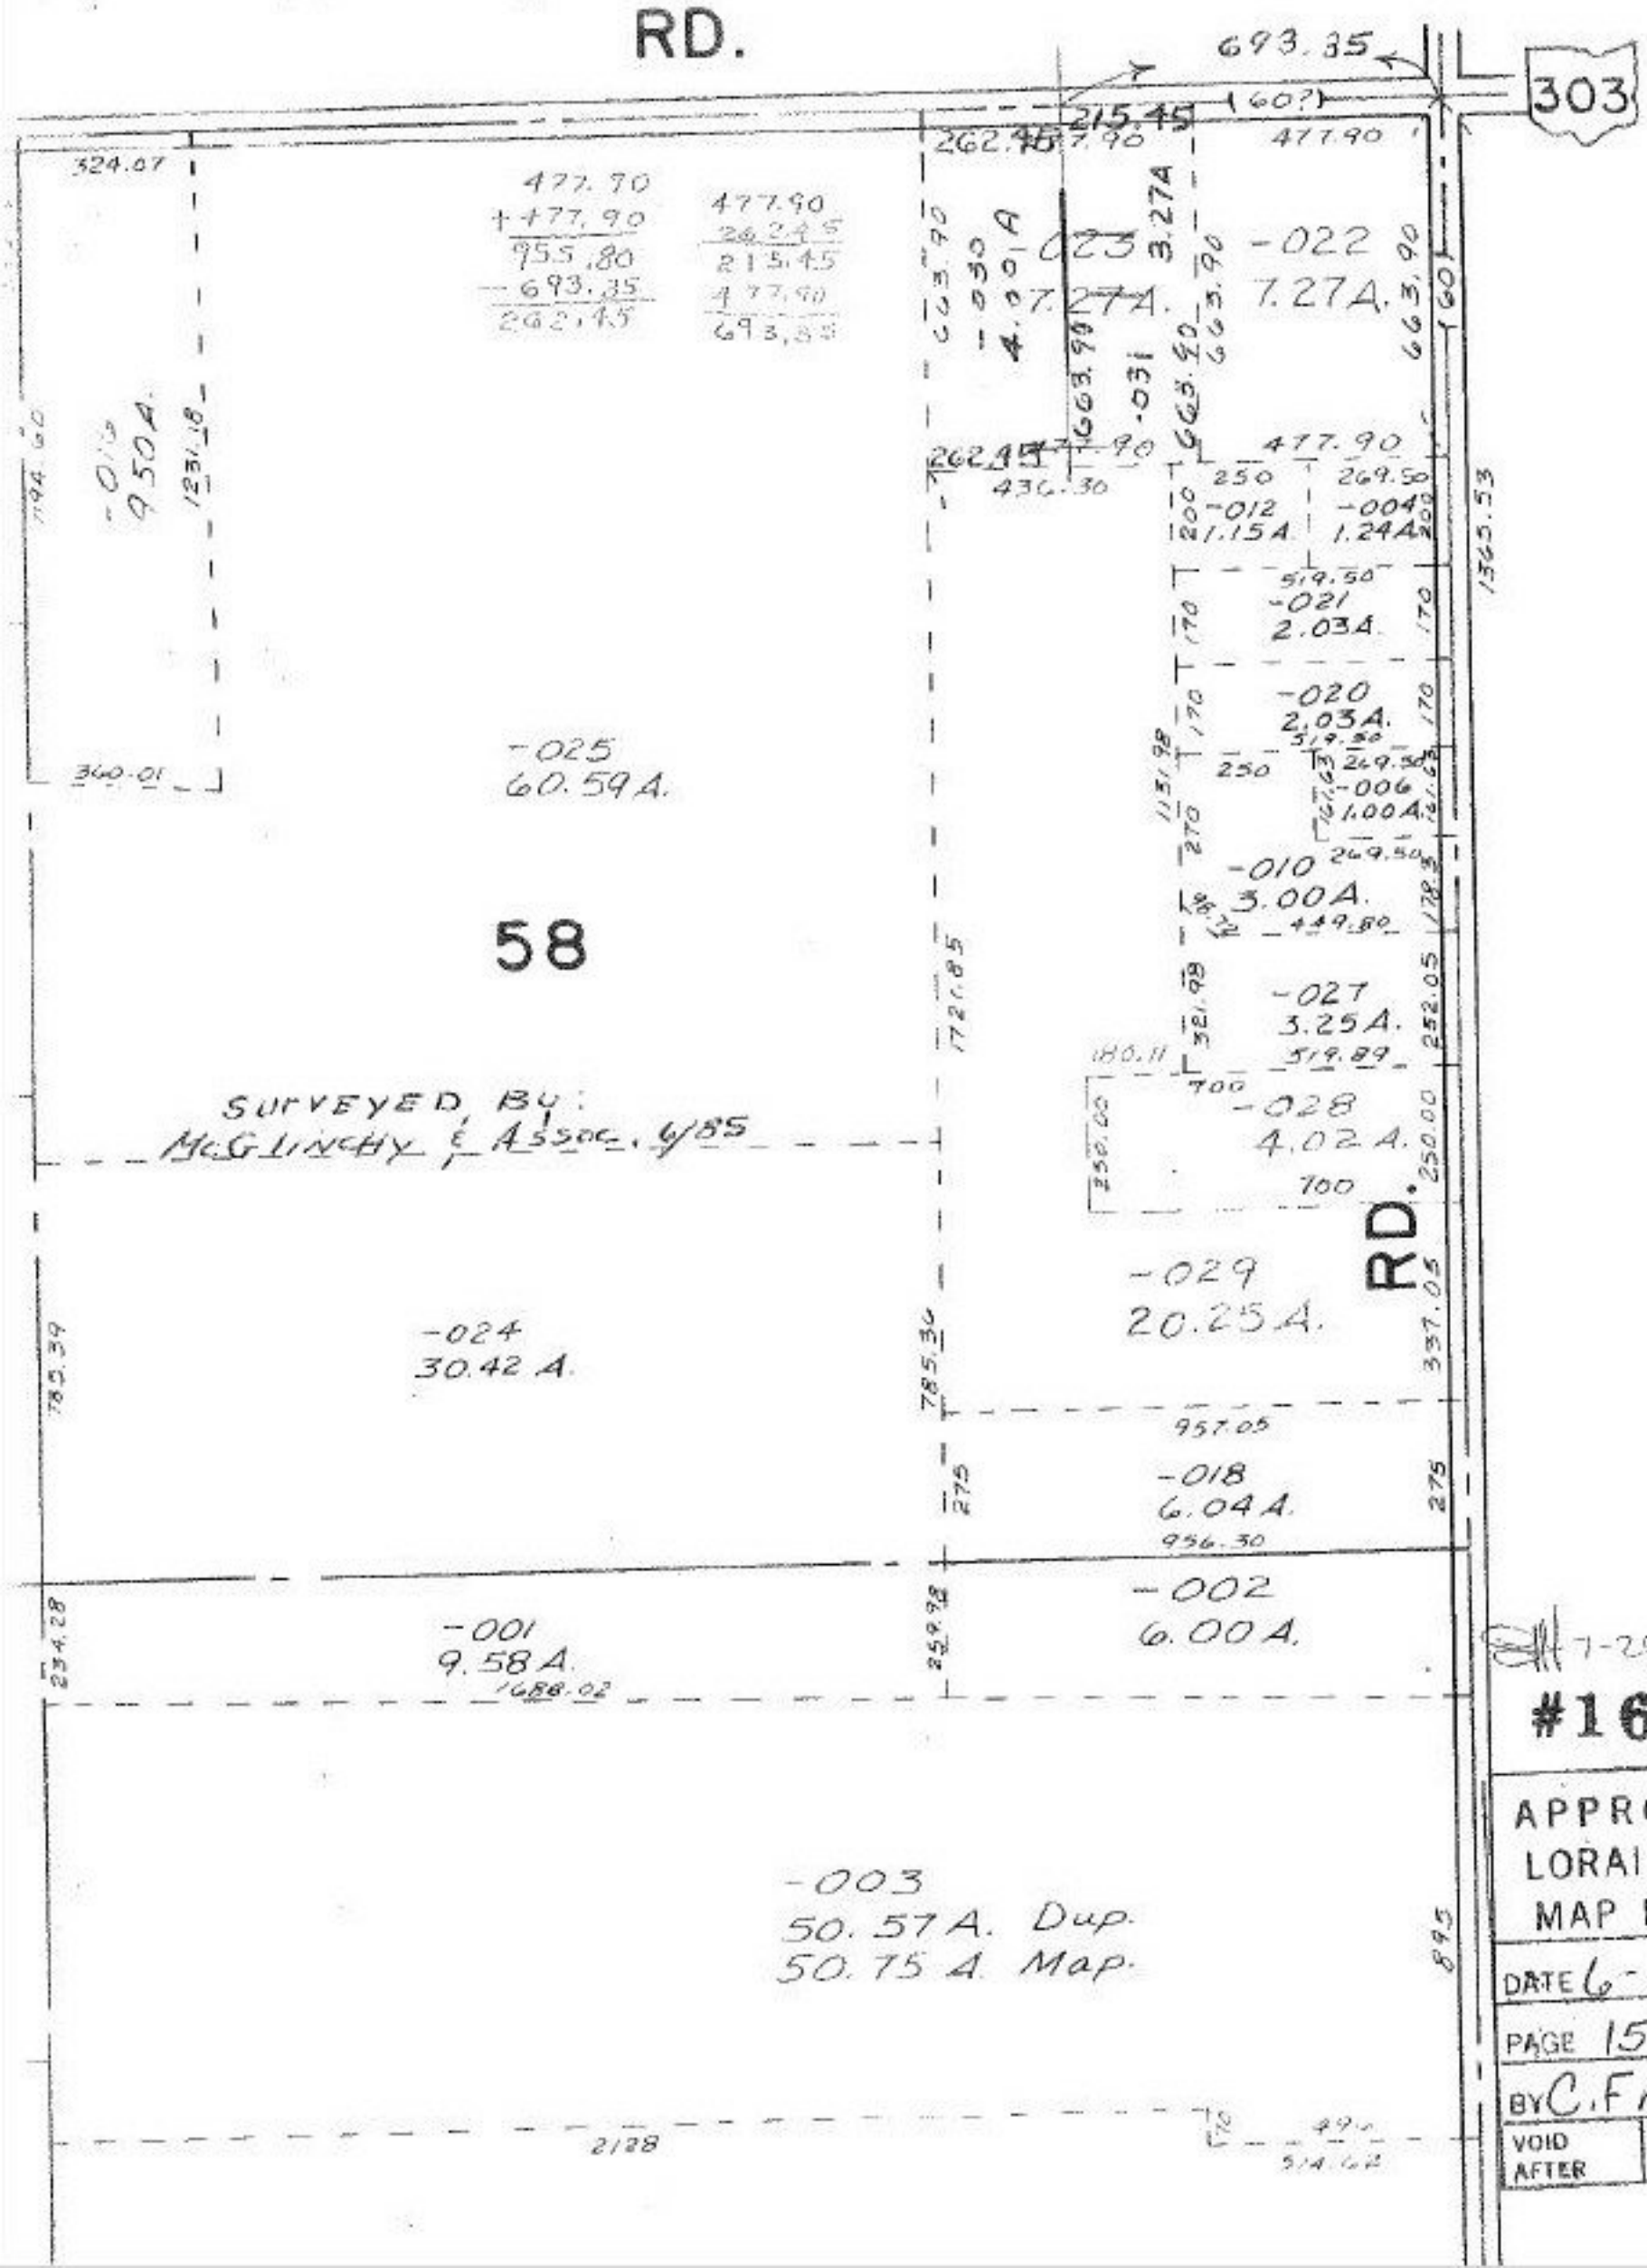


7-25-86

#16227

APPROVED
LORAIN CO.
MAP DEPT.

DATE 6-14-85

PAGE 15-E

BY C. Francis

VOID AFTER