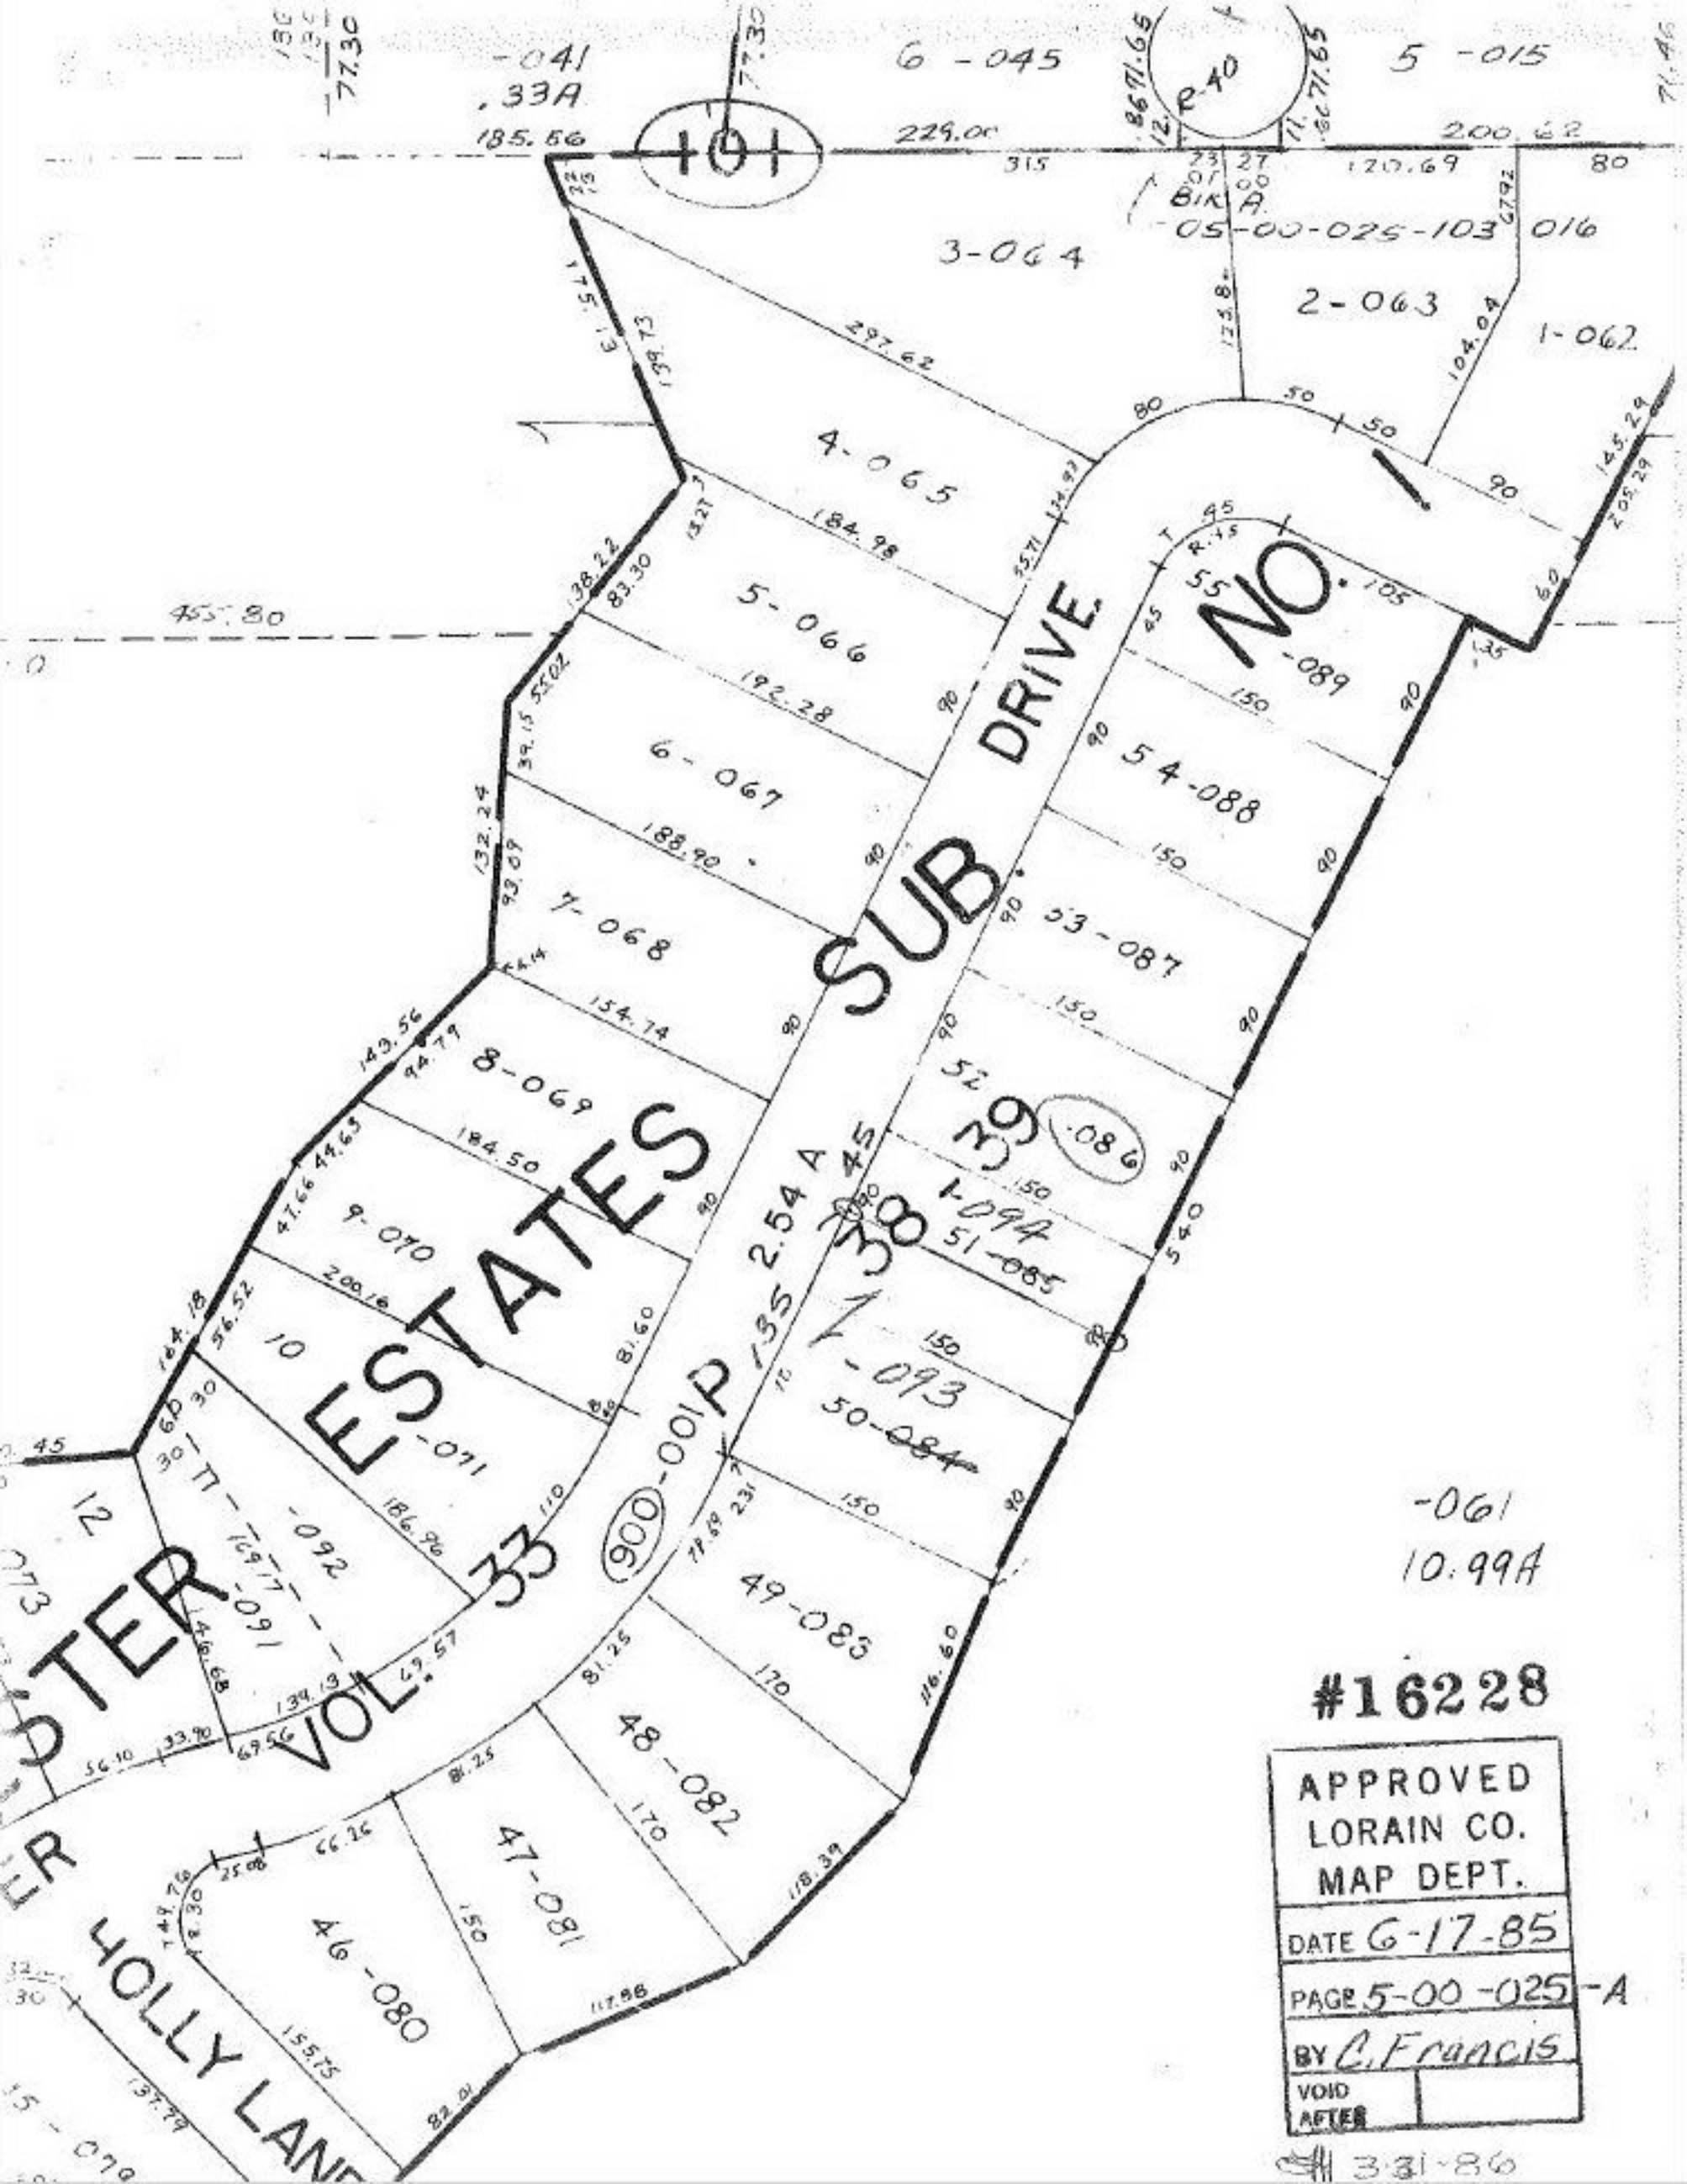
-041
.33A
6 -045
5 -015
101
229.00
200.62
120.69
BK A
05-00-025-103
016
3-064
2-063
1-062
4-065
5-066
6-067
7-068
8-069
9-070
10
-071
-092
-091
12
33
900
-001P
135
2.54 A
38
39
-086
-094
51-085
-093
50-084
49-083
48-082
47-081
46-080
SUB DRIVE
NO.
55
-089
54-088
53-087
52
HOLLY LANE
-061
10.99A
#16228
APPROVED
LORAIN CO.
MAP DEPT.
DATE 6-17-85
PAGE 5-00-025-A
BY C. Francis
VOID AFTER
3-31-86