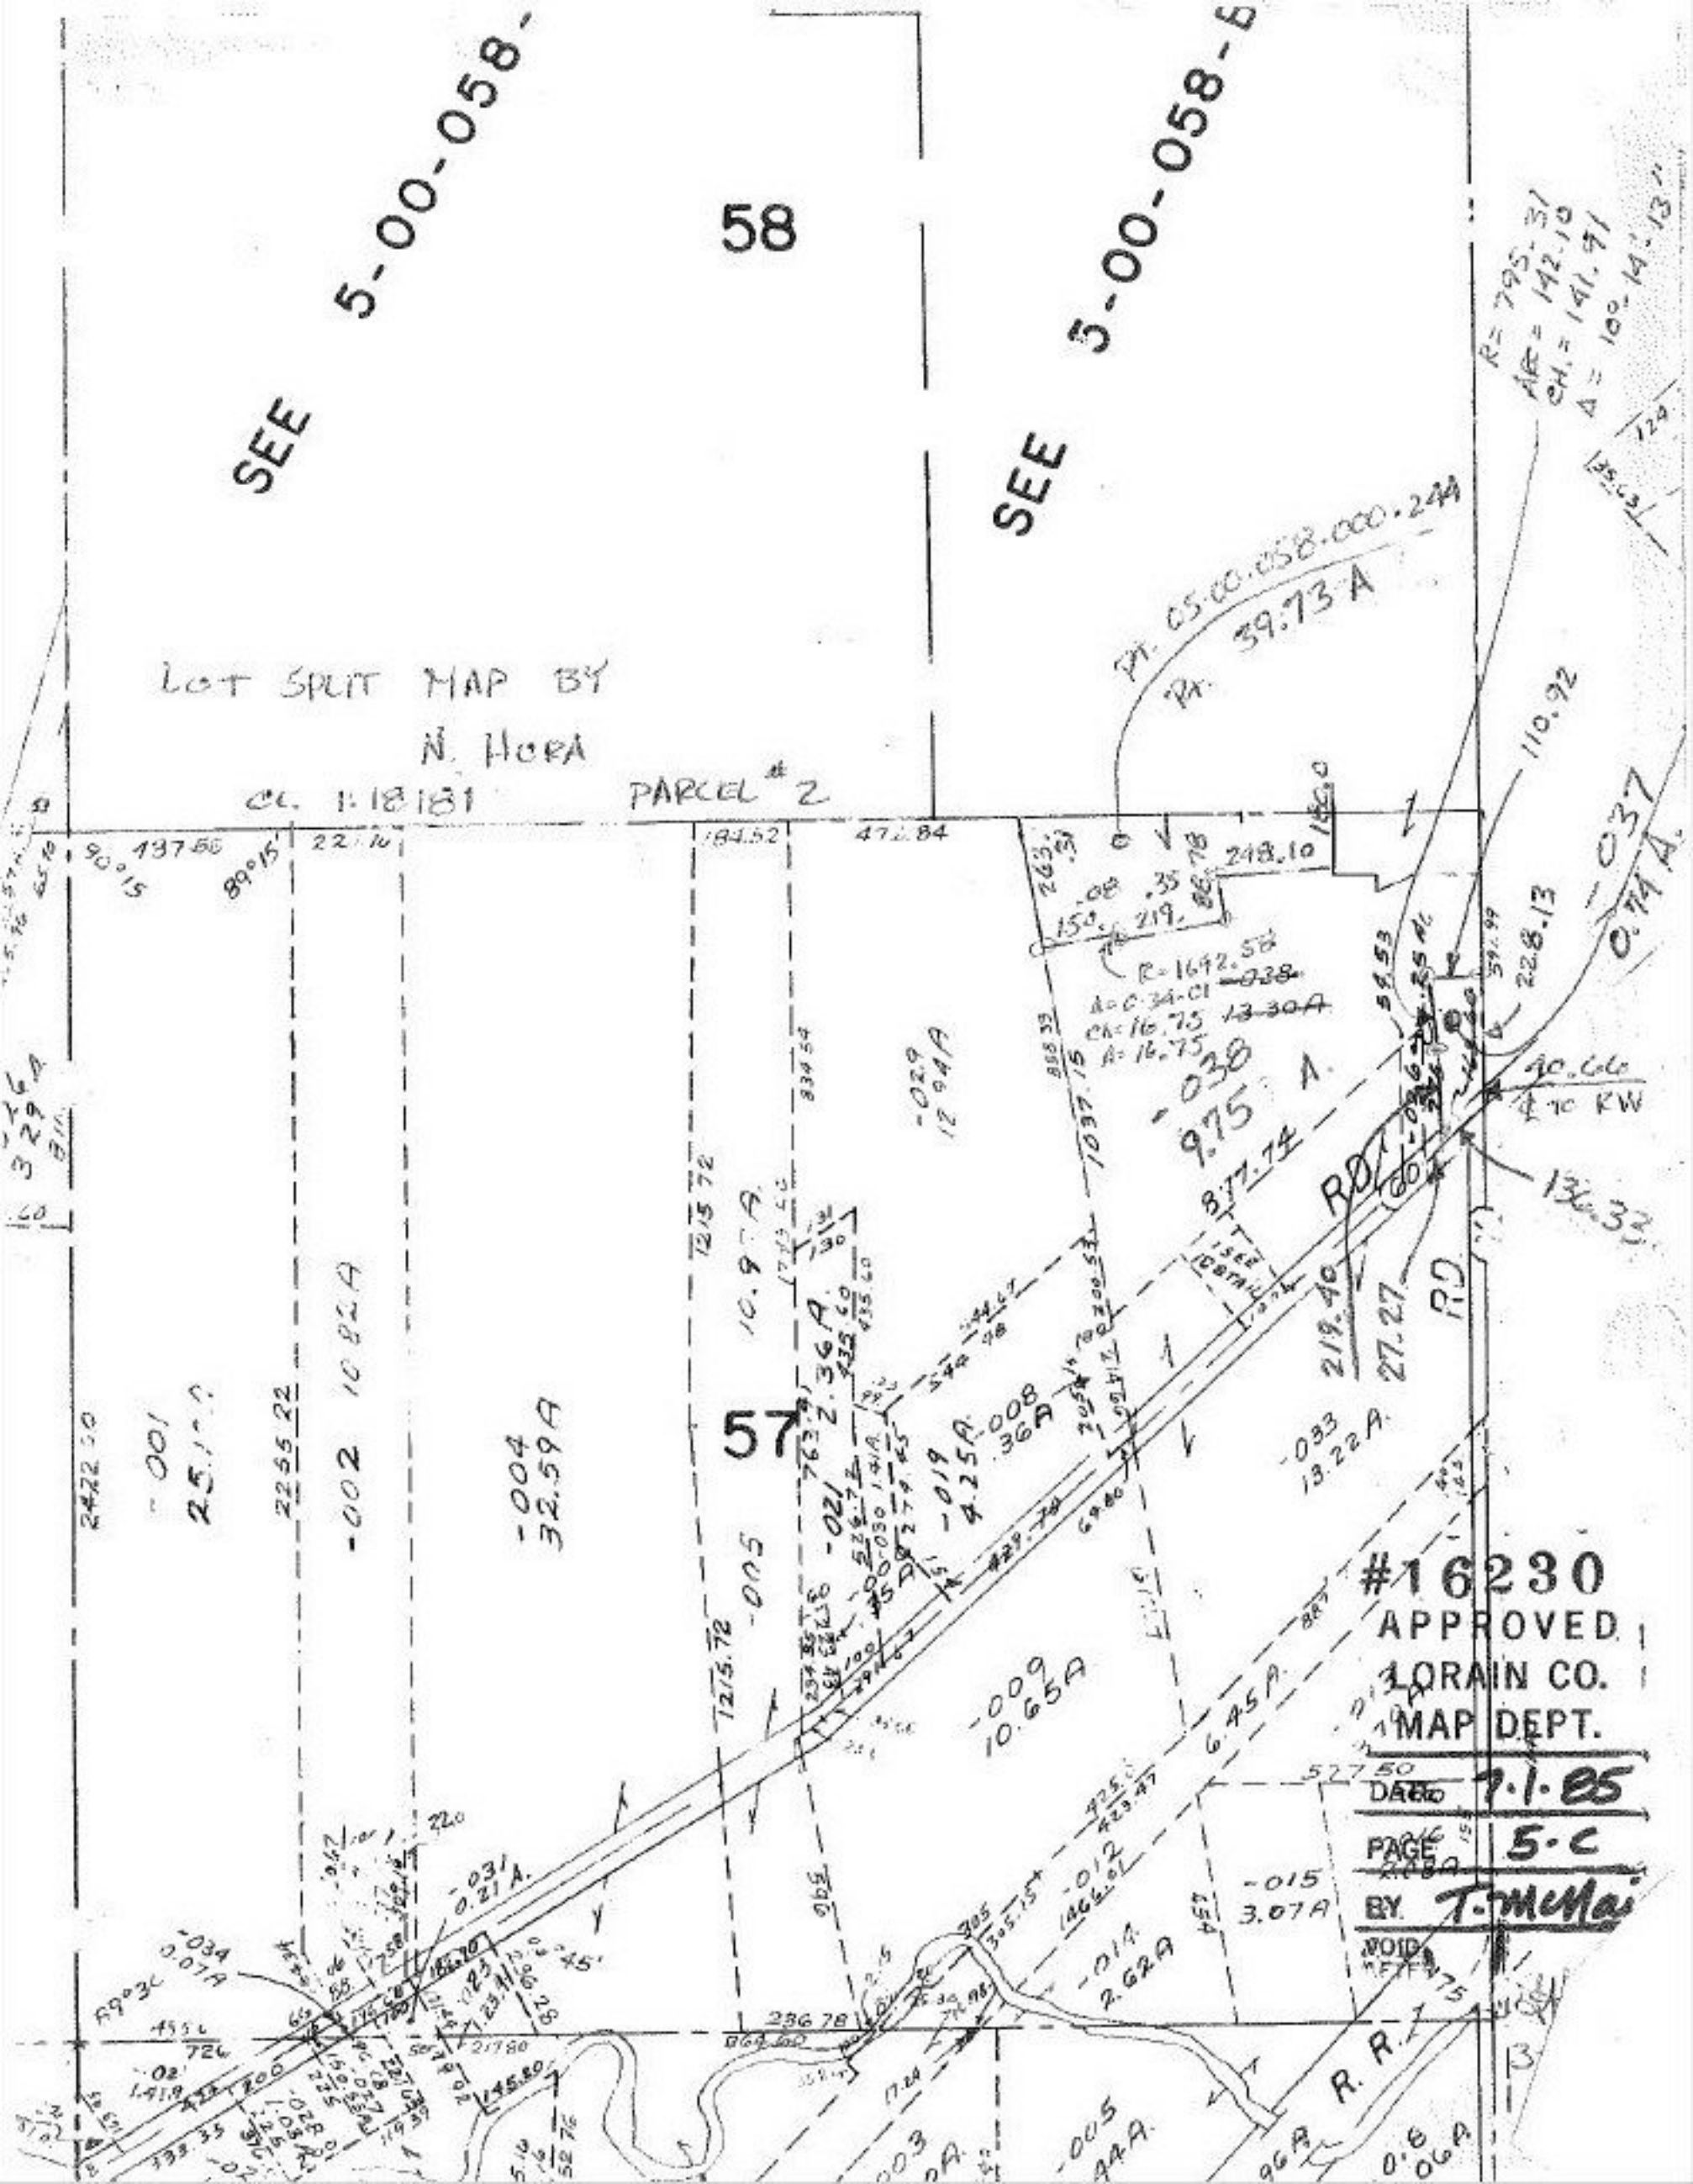

SEE 5-00-058-
58
SEE 5-00-058-B
LOT SPLIT MAP BY
N. HORA
CL. 1:18181
PARCEL # 2
Pt. 05-00-058-000-244
Pt. 39.73 A
R= 795.31
Arc = 142.10
CH. = 141.91
Δ = 10°-14'-13"
110.92
248.10
228.13
-037
0.74 A.
R=1642.58
Δ=0-34-01
CH=16.75
A=16.75
-038
9.75 A.
40.66
℄ TO RW
136.33
RD
219.40
27.27
57
-001
25.1
-002
10.82 A
-004
32.59 A
-005
10.97 A
-021
2.36 A
-019
4.25 A
-008
.36 A
-033
13.22 A
-009
10.65 A
6.45 A
-031
0.21 A.
-034
0.07 A
-012
-015
3.07 A
-014
2.62 A
R. R.
-005
44 A.
0.8
06 A
#16230
APPROVED
LORAIN CO.
MAP DEPT.
DATE 7-1-85
PAGE 5-C
BY T. McMai
VOID