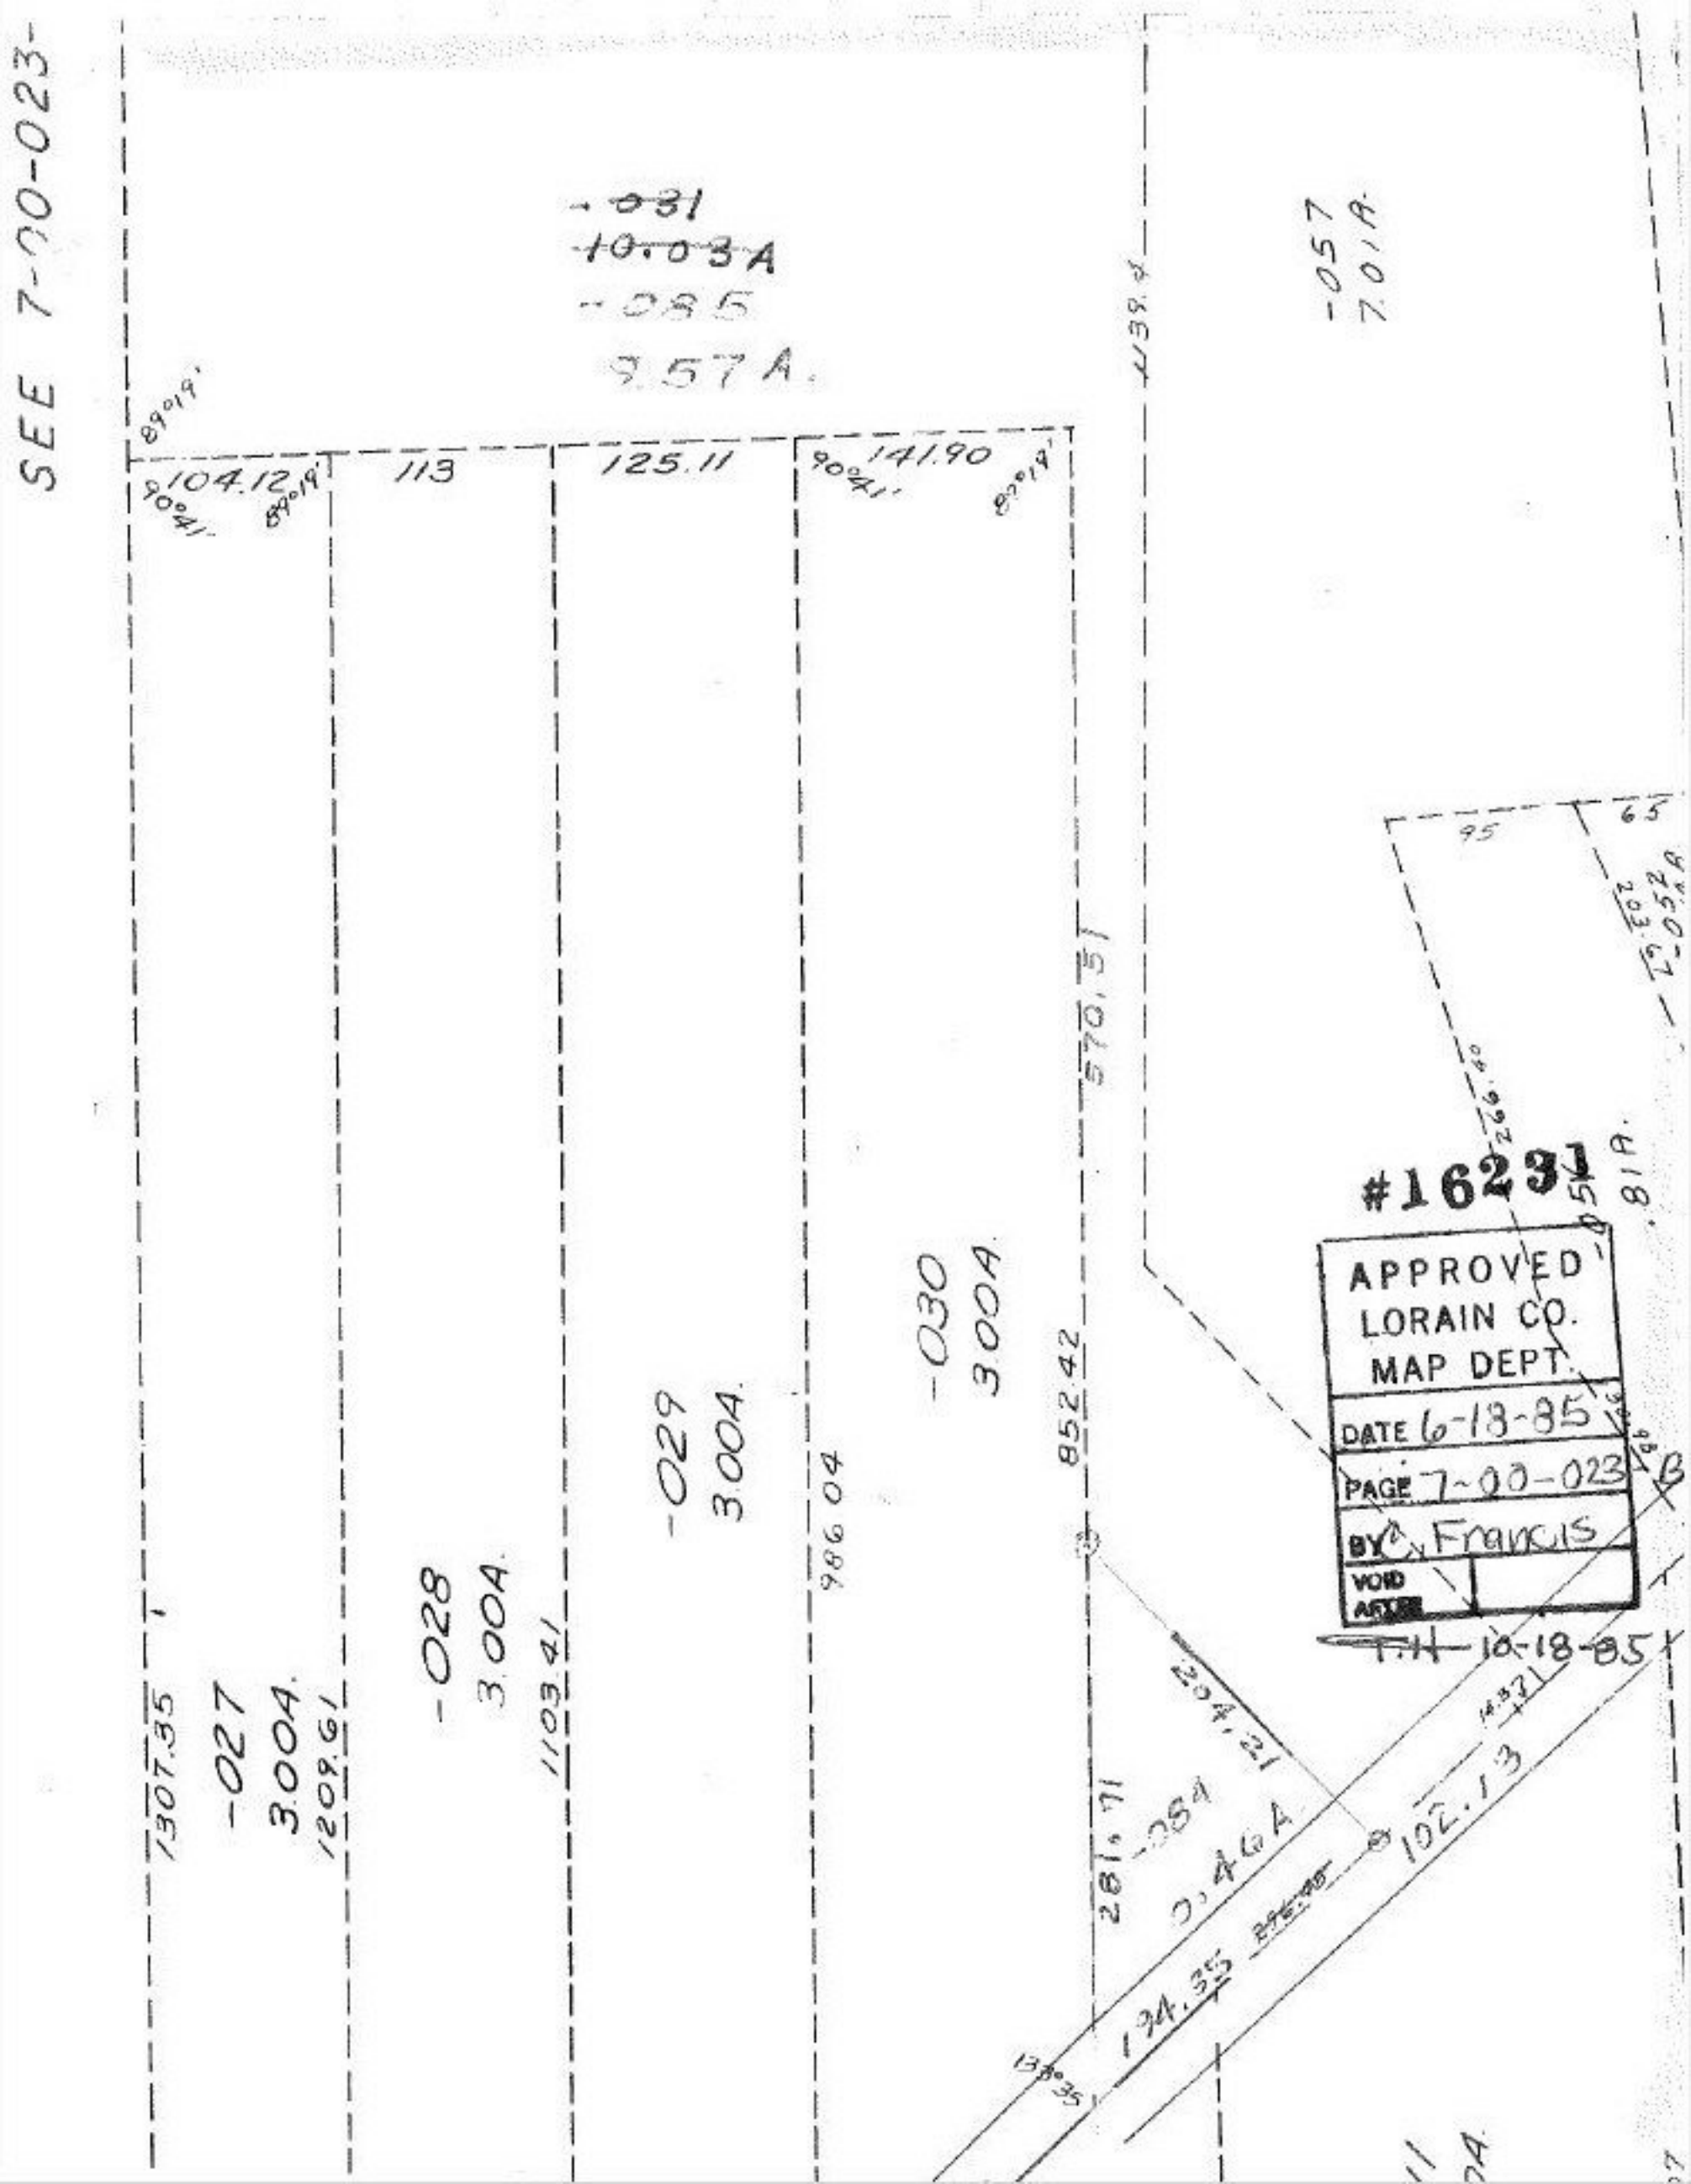
SEE 7-00-023-
-031
10.03 A
-085
9.57 A.
-057
7.01 A.
104.12
113
125.11
141.90
-030
3.00A
-029
3.00A
-028
3.00A
-027
3.00A
1307.35
1209.61
1103.41
986.04
852.42
570.51
281.71
204.21
102.13
194.35
-084
0.46A
#16231
APPROVED
LORAIN CO.
MAP DEPT.
DATE 6-18-85
PAGE 7-00-023
BY C. Francis
VOID
AFTER
T.H. 10-18-85