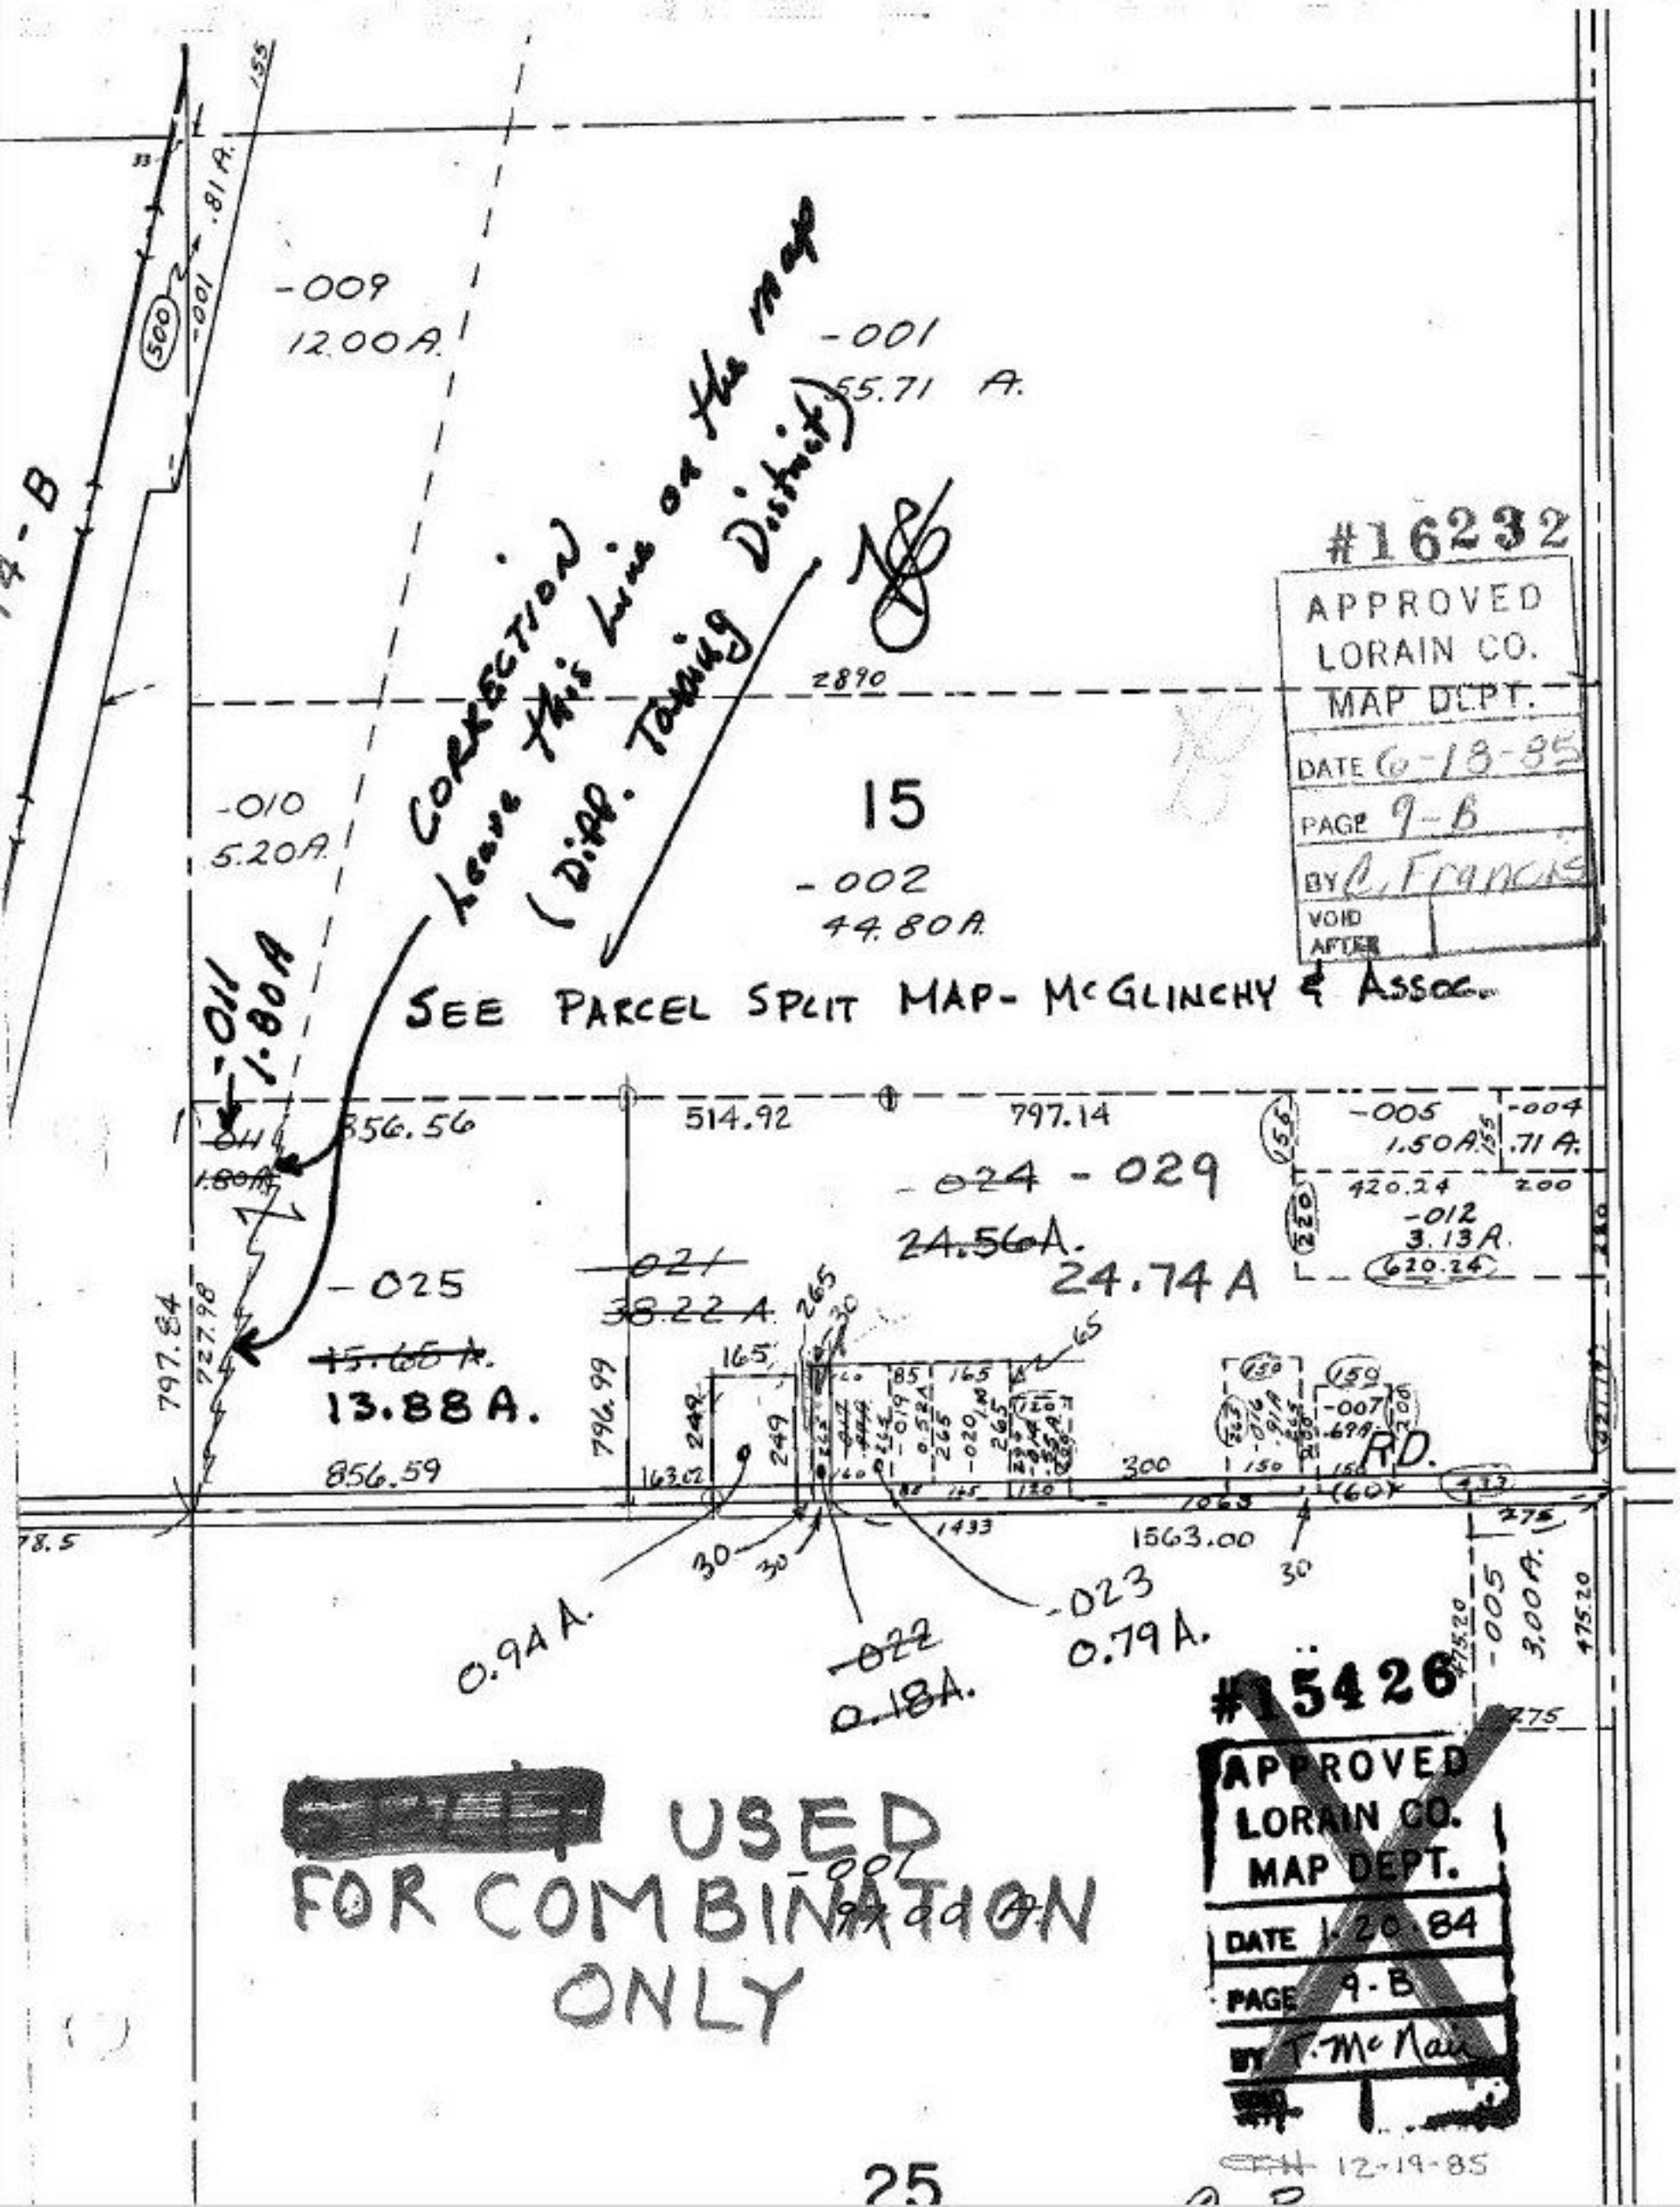

-009
12.00 A.
-001
55.71 A.
CORRECTION
Leave this Line on the map
(Diff. Taxing District)
#16232
APPROVED
LORAIN CO.
MAP DEPT.
DATE 6-18-85
PAGE 9-B
BY C. Francis
VOID AFTER
2890
15
-010
5.20 A.
-002
44.80 A.
SEE PARCEL SPLIT MAP- McGLINCHY & ASSOC.
-011
1.80 A
856.56
514.92
797.14
-005
1.50 A.
-004
.71 A.
-024 - 029
24.56 A.
24.74 A
420.24
200
-012
3.13 A.
620.24
-025
-021
38.22 A.
15.65 A.
13.88 A.
797.84
727.98
796.99
856.59
RD.
1563.00
0.94 A.
-022
0.18 A.
-023
0.79 A.
-005
3.00 A.
475.20
#15426
APPROVED
LORAIN CO.
MAP DEPT.
DATE 1-20-84
PAGE 9-B
BY T. McNair
[redacted] USED
FOR COMBINATION
ONLY
-001
12-19-85
25