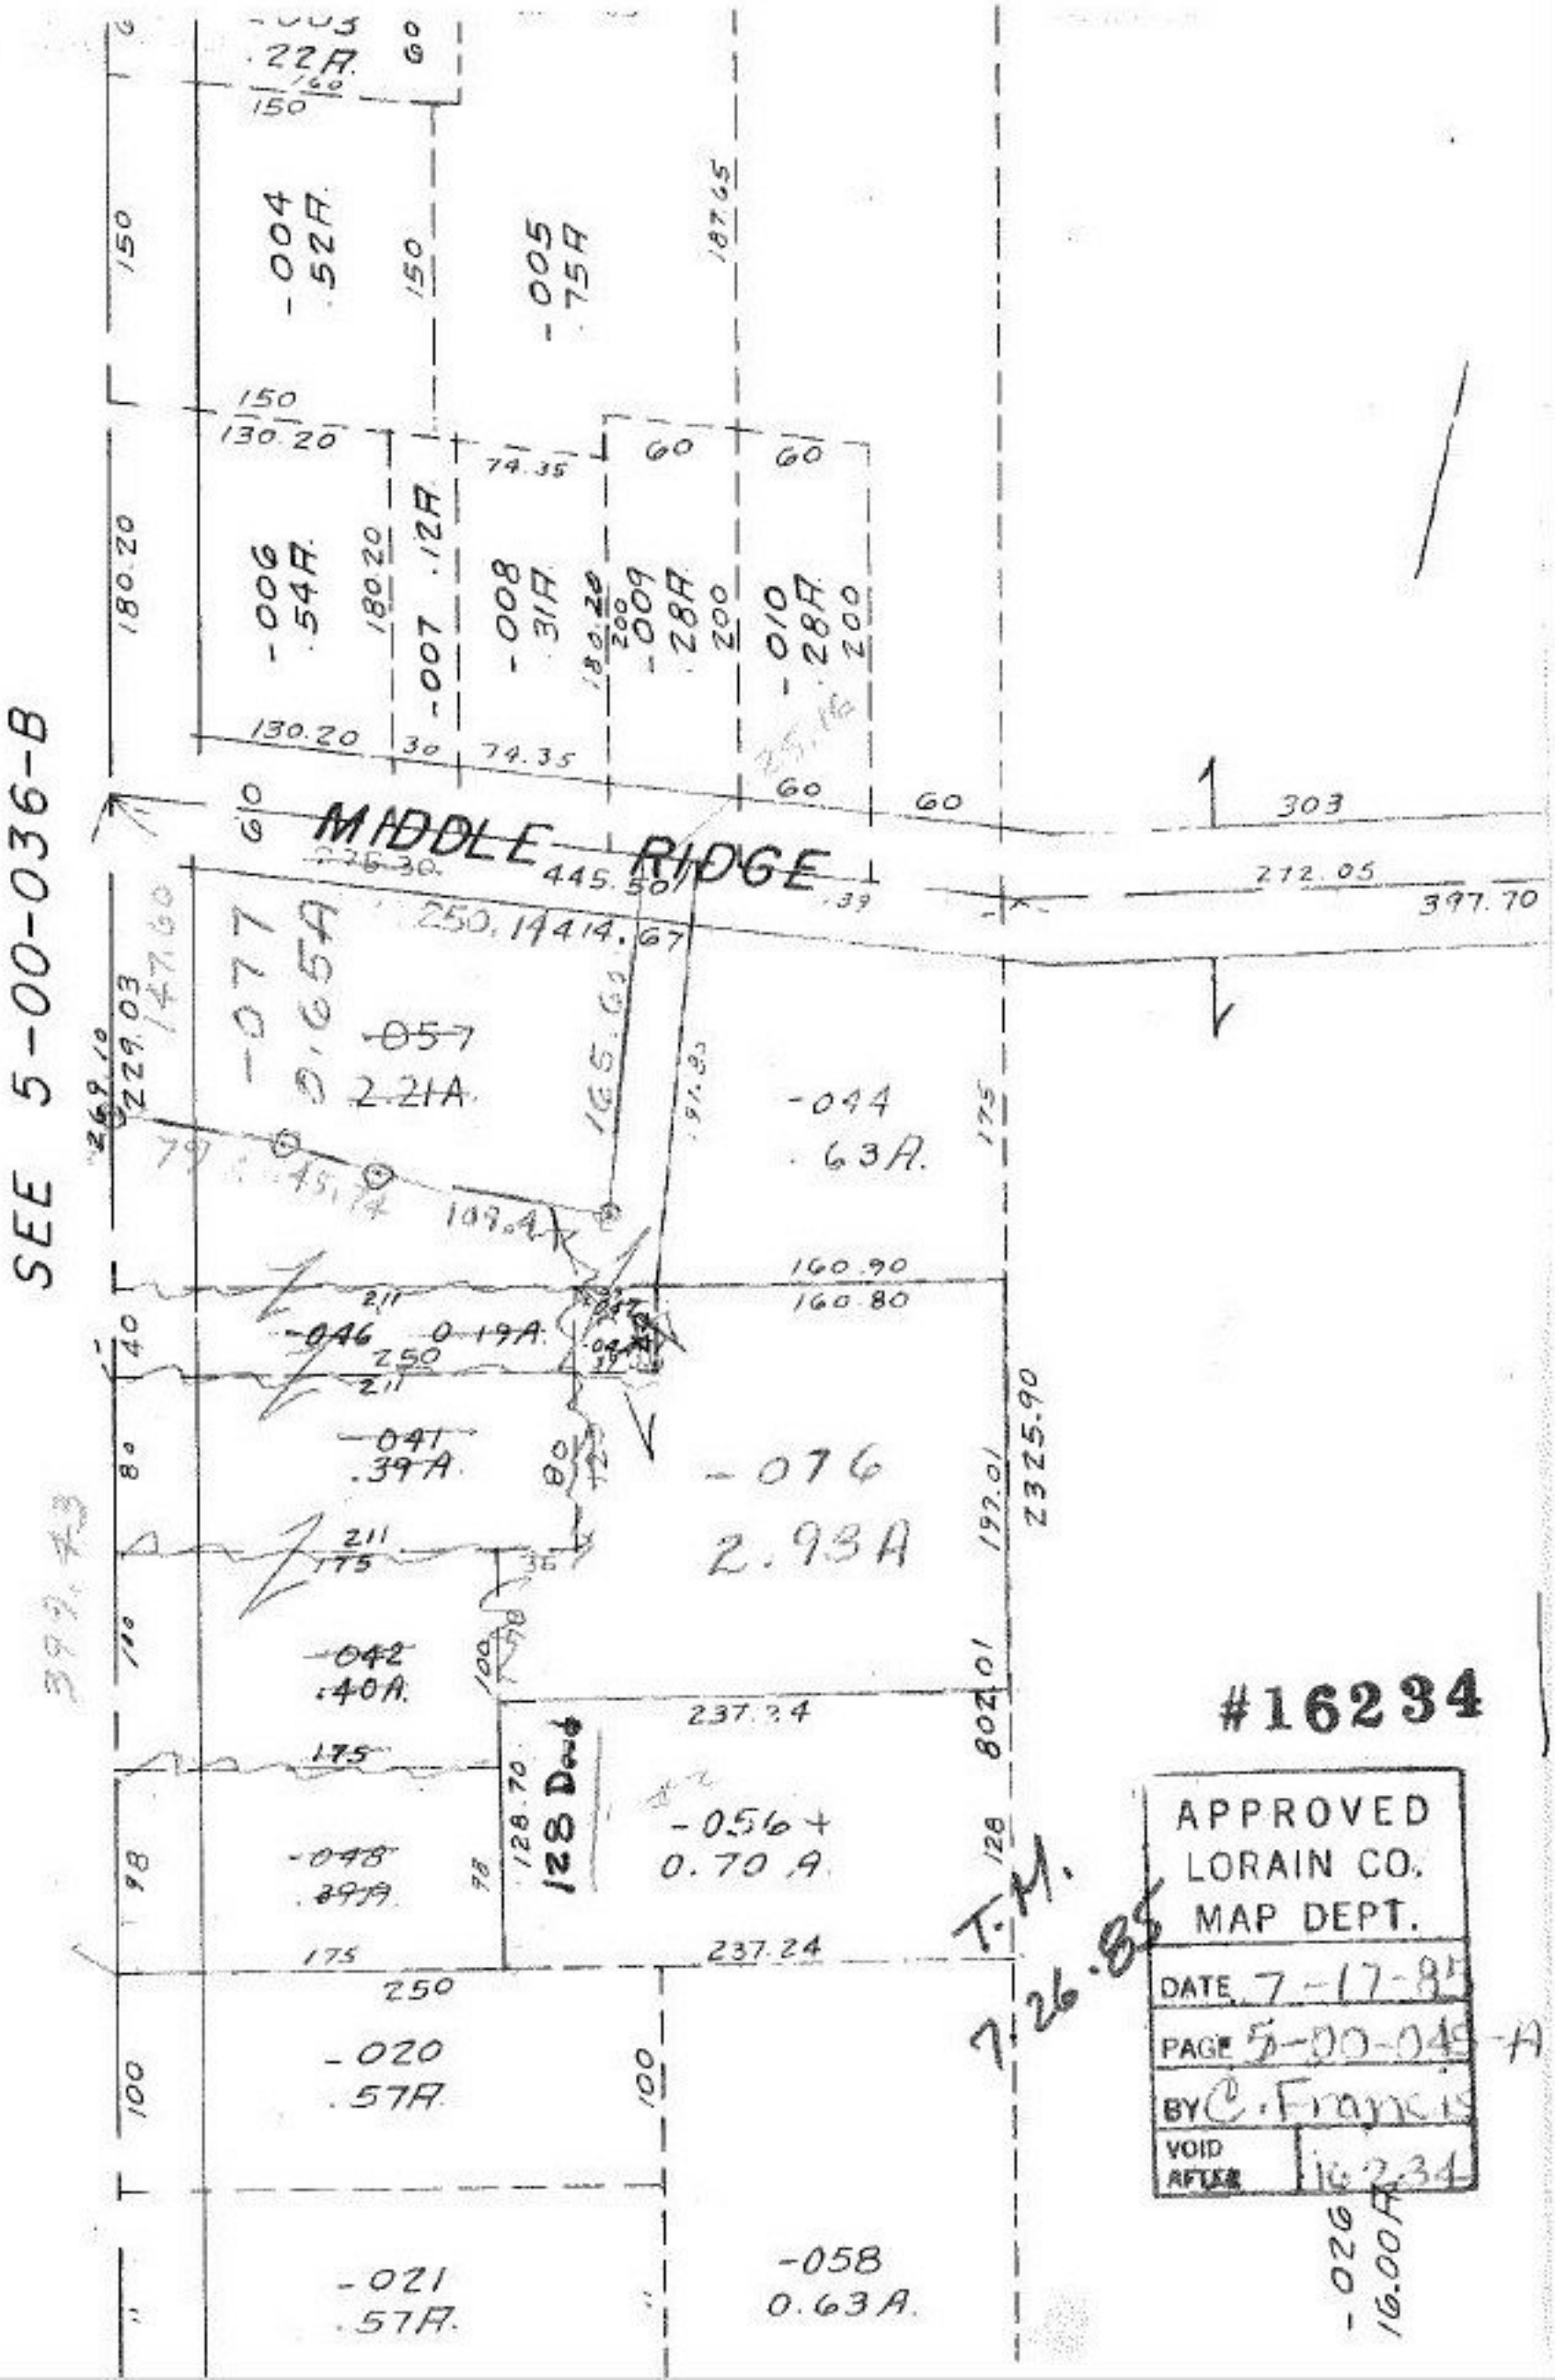

SEE 5-00-036-B
MIDDLE RIDGE
-003 .22A.
-004 .52A.
-005 .75A
-006 .54A.
-007 .12A.
-008 .31A.
-009 .28A.
-010 .28A.
-077 0.65A
-057 2.21A.
-044 .63A.
-046 0.19A.
-041 .39A.
-076 2.93A
-042 .40A.
-048 .39A.
-056 + 0.70 A.
-020 .57A.
-021 .57A.
-058 0.63A.
128 Deed
T.M. 7.26.85
-026 16.00A
#16234
APPROVED
LORAIN CO.
MAP DEPT.
DATE 7-17-85
PAGE 5-00-049-A
BY C. Francis
VOID AFTER 16234