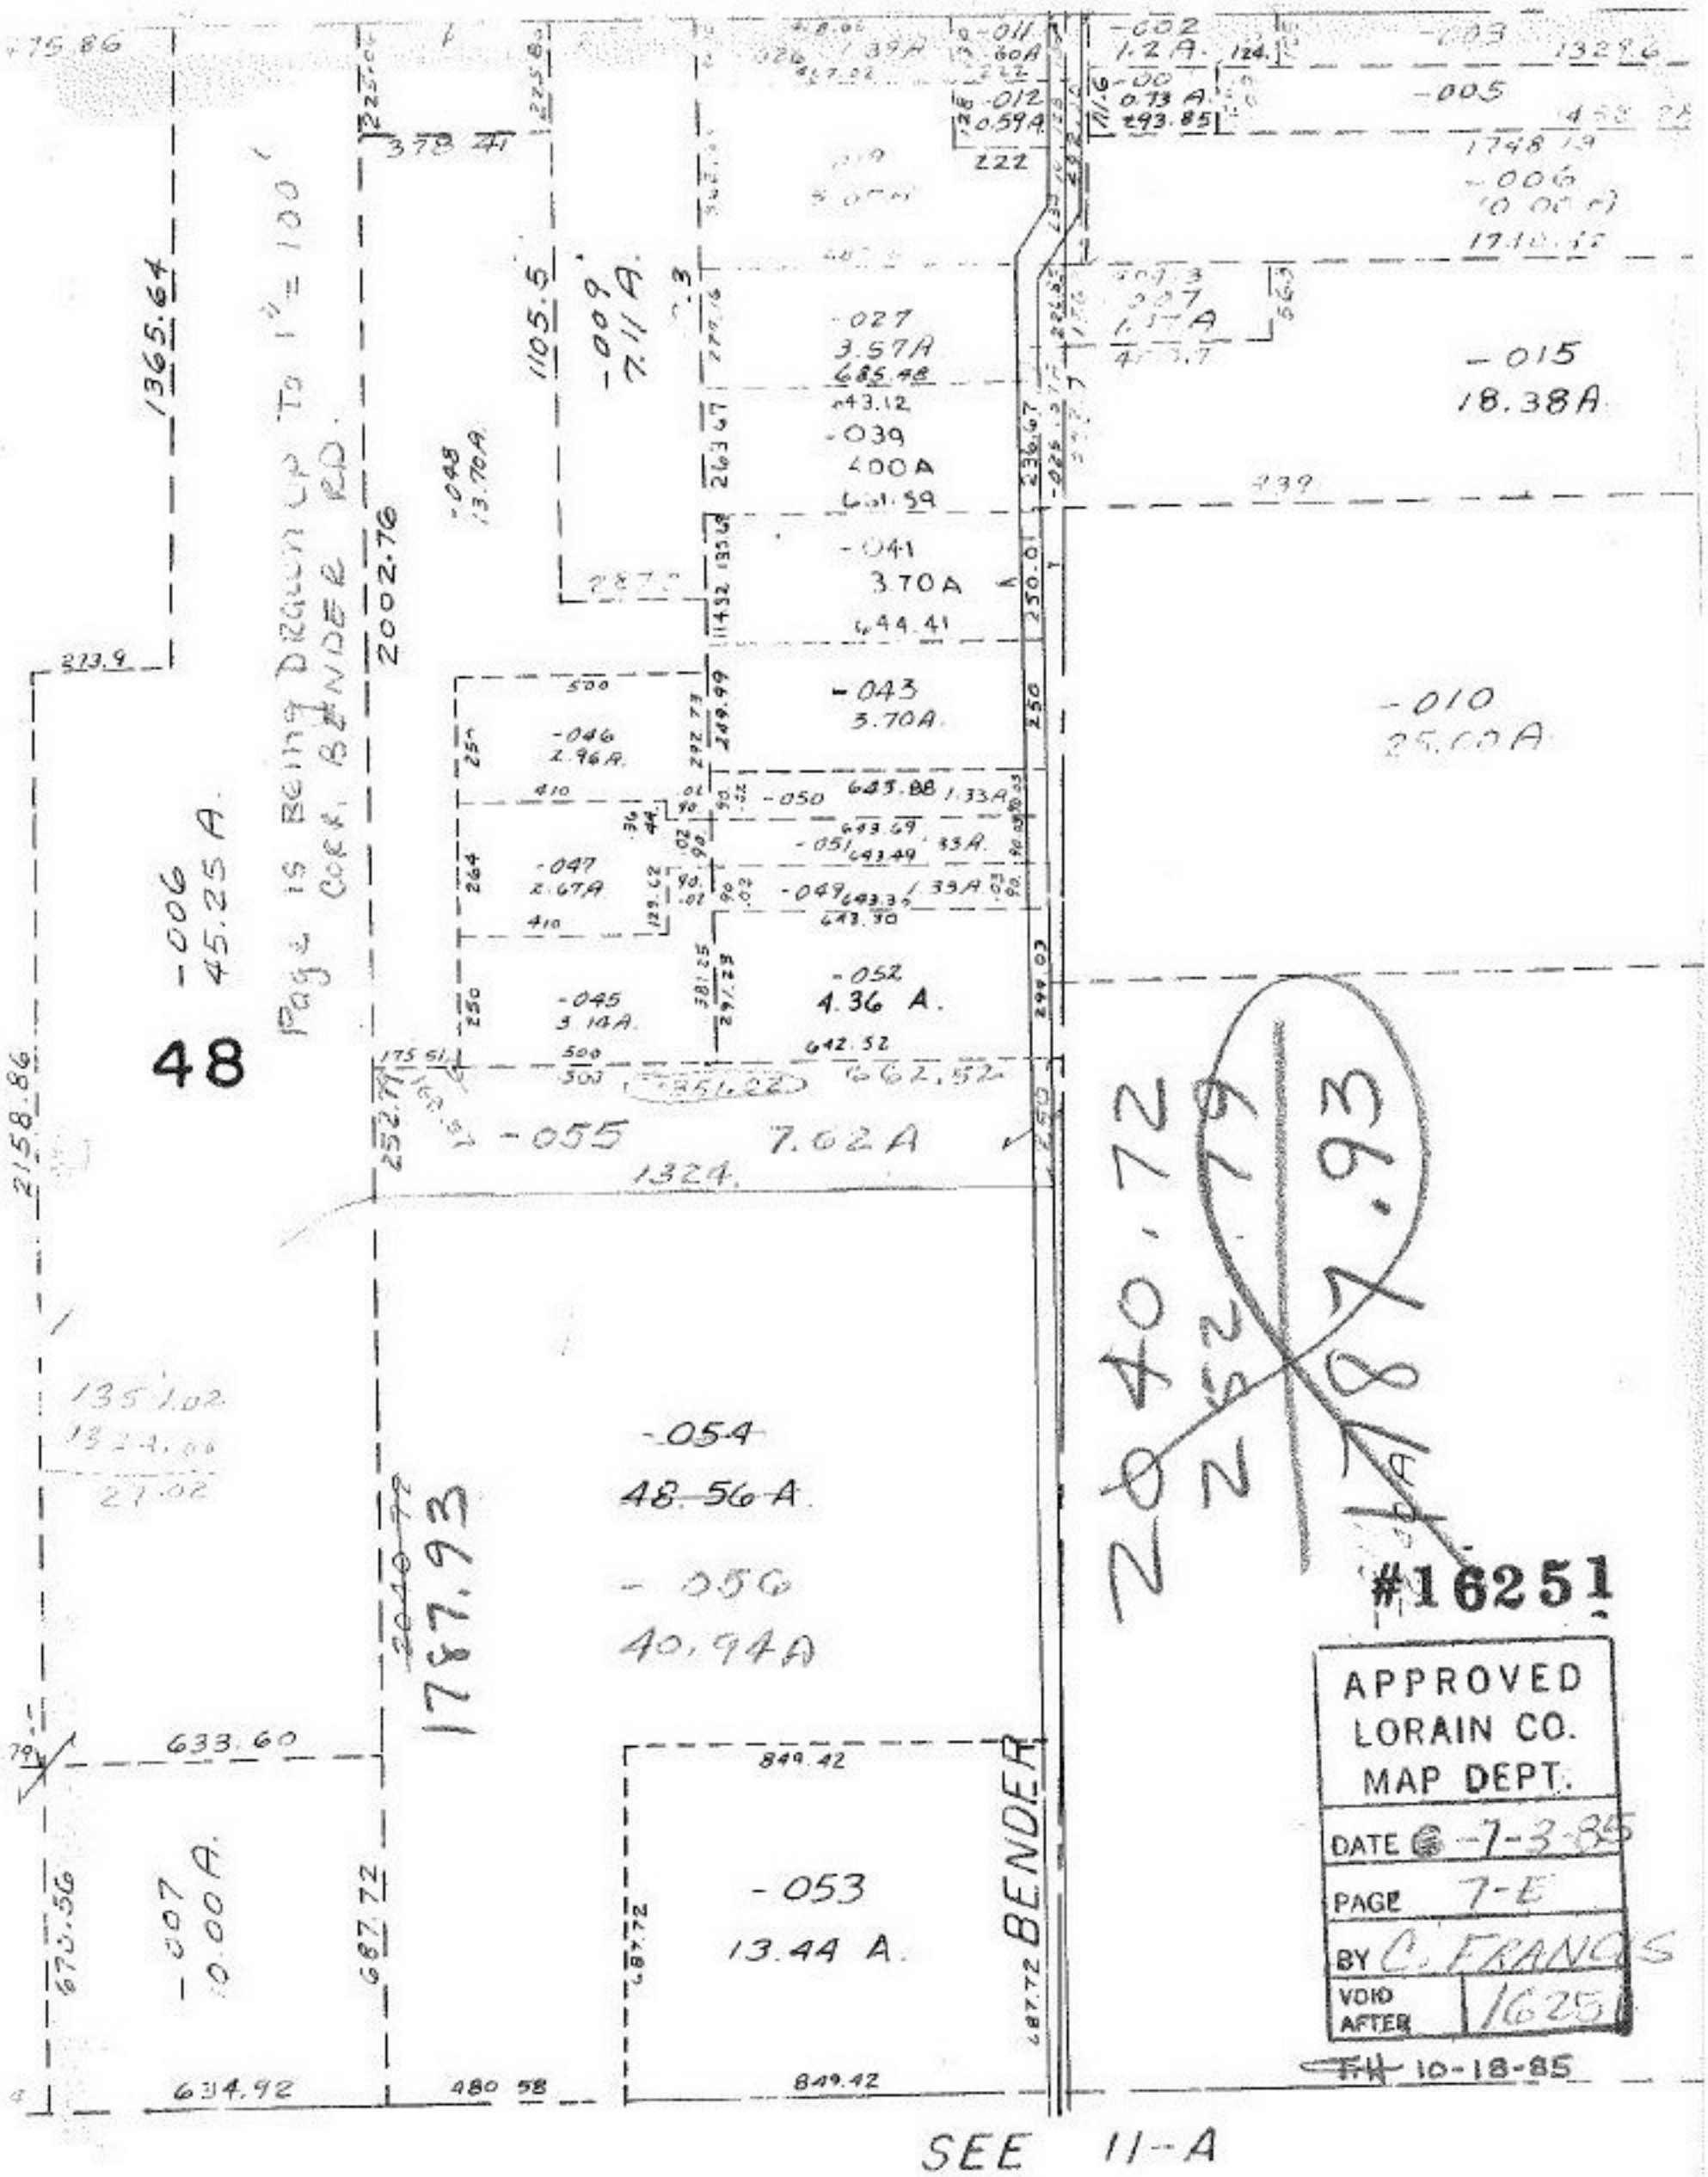

Page is Being Drawn Up To 1" = 100'
Corr. BENDER RD.
48
-006
45.25 A.
1365.64
2002.76
1105.5
-009
7.11 A.
-027
3.57A
-039
400A
-041
3.70A
-043
3.70A.
-046
2.96A.
-047
2.67A
-045
3.14A.
-052
4.36 A.
-055
7.62A
1324.
-015
18.38A
-010
25.00A
-054
48.56 A.
-056
40.94A
-053
13.44 A.
-007
0.00 A.
BENDER
2040.72
2052.79
1787.93
#16251
APPROVED
LORAIN CO.
MAP DEPT.
DATE 6-7-3-85
PAGE 7-E
BY C. FRANCIS
VOID AFTER 16251
10-18-85
SEE 11-A