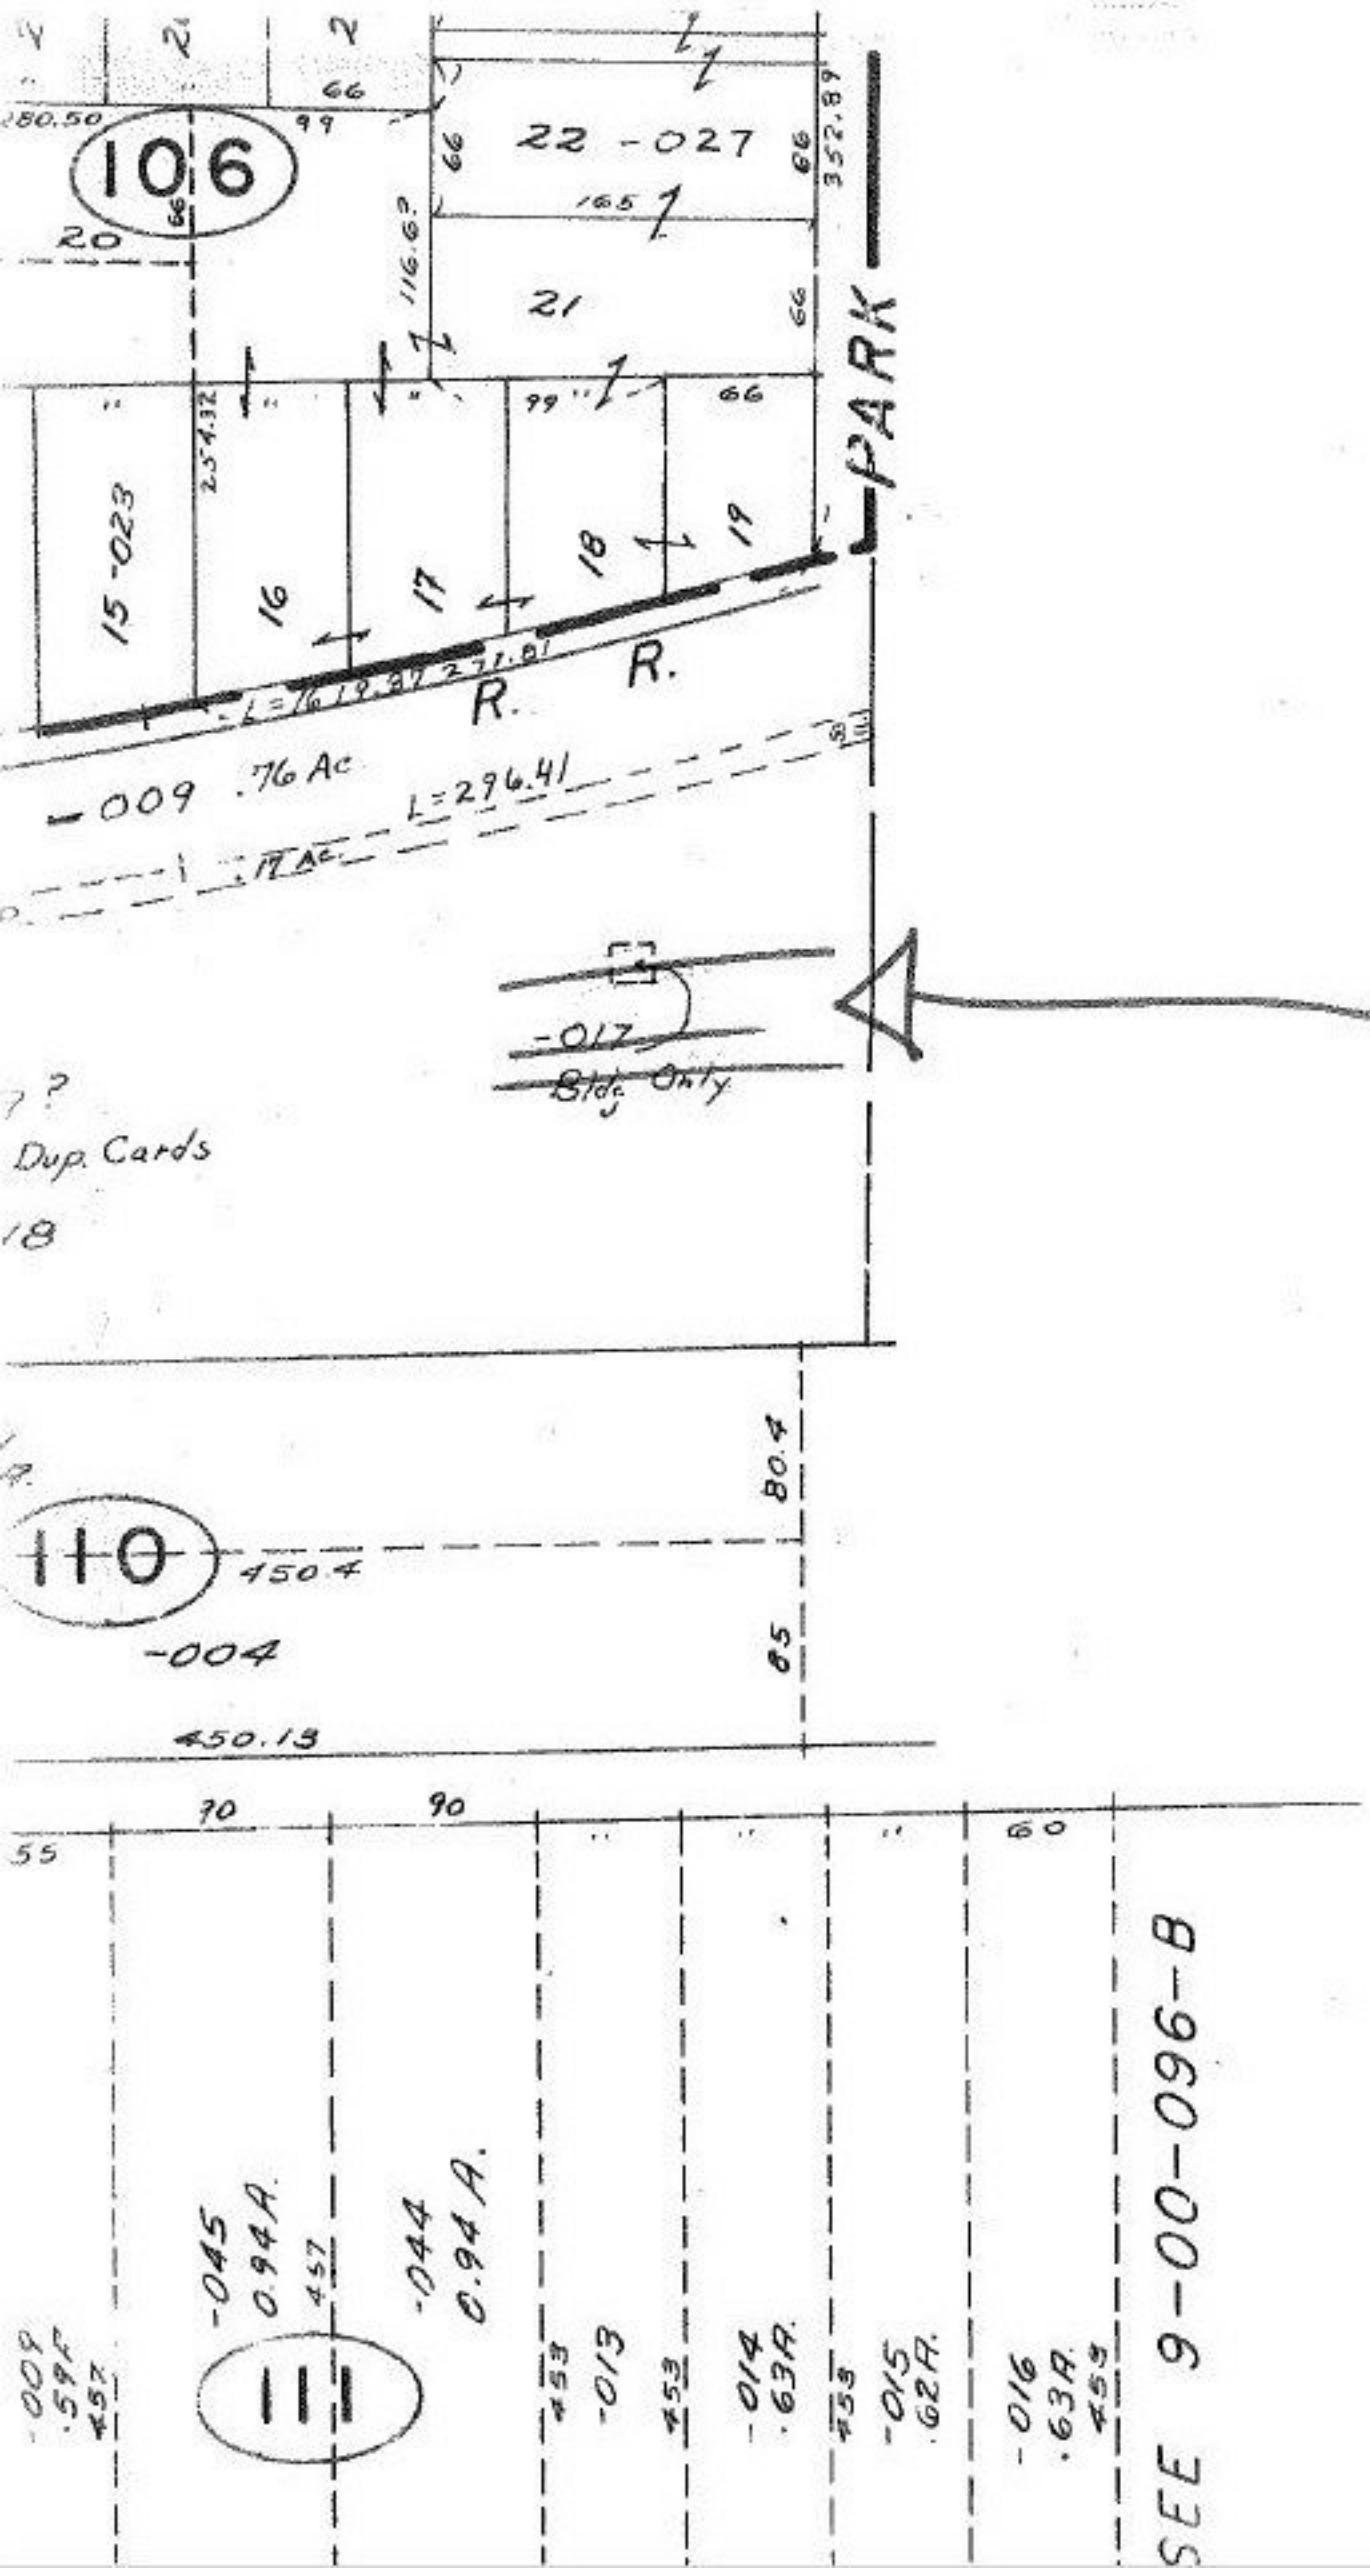

DROP FROM DUPLICATE

#16252
APPROVED
LORAIN CO.
MAP DEPT.
DATE 7.10.85
PAGE 9.00.096-A
BY T. McNair
VOID
SH 4-7-86