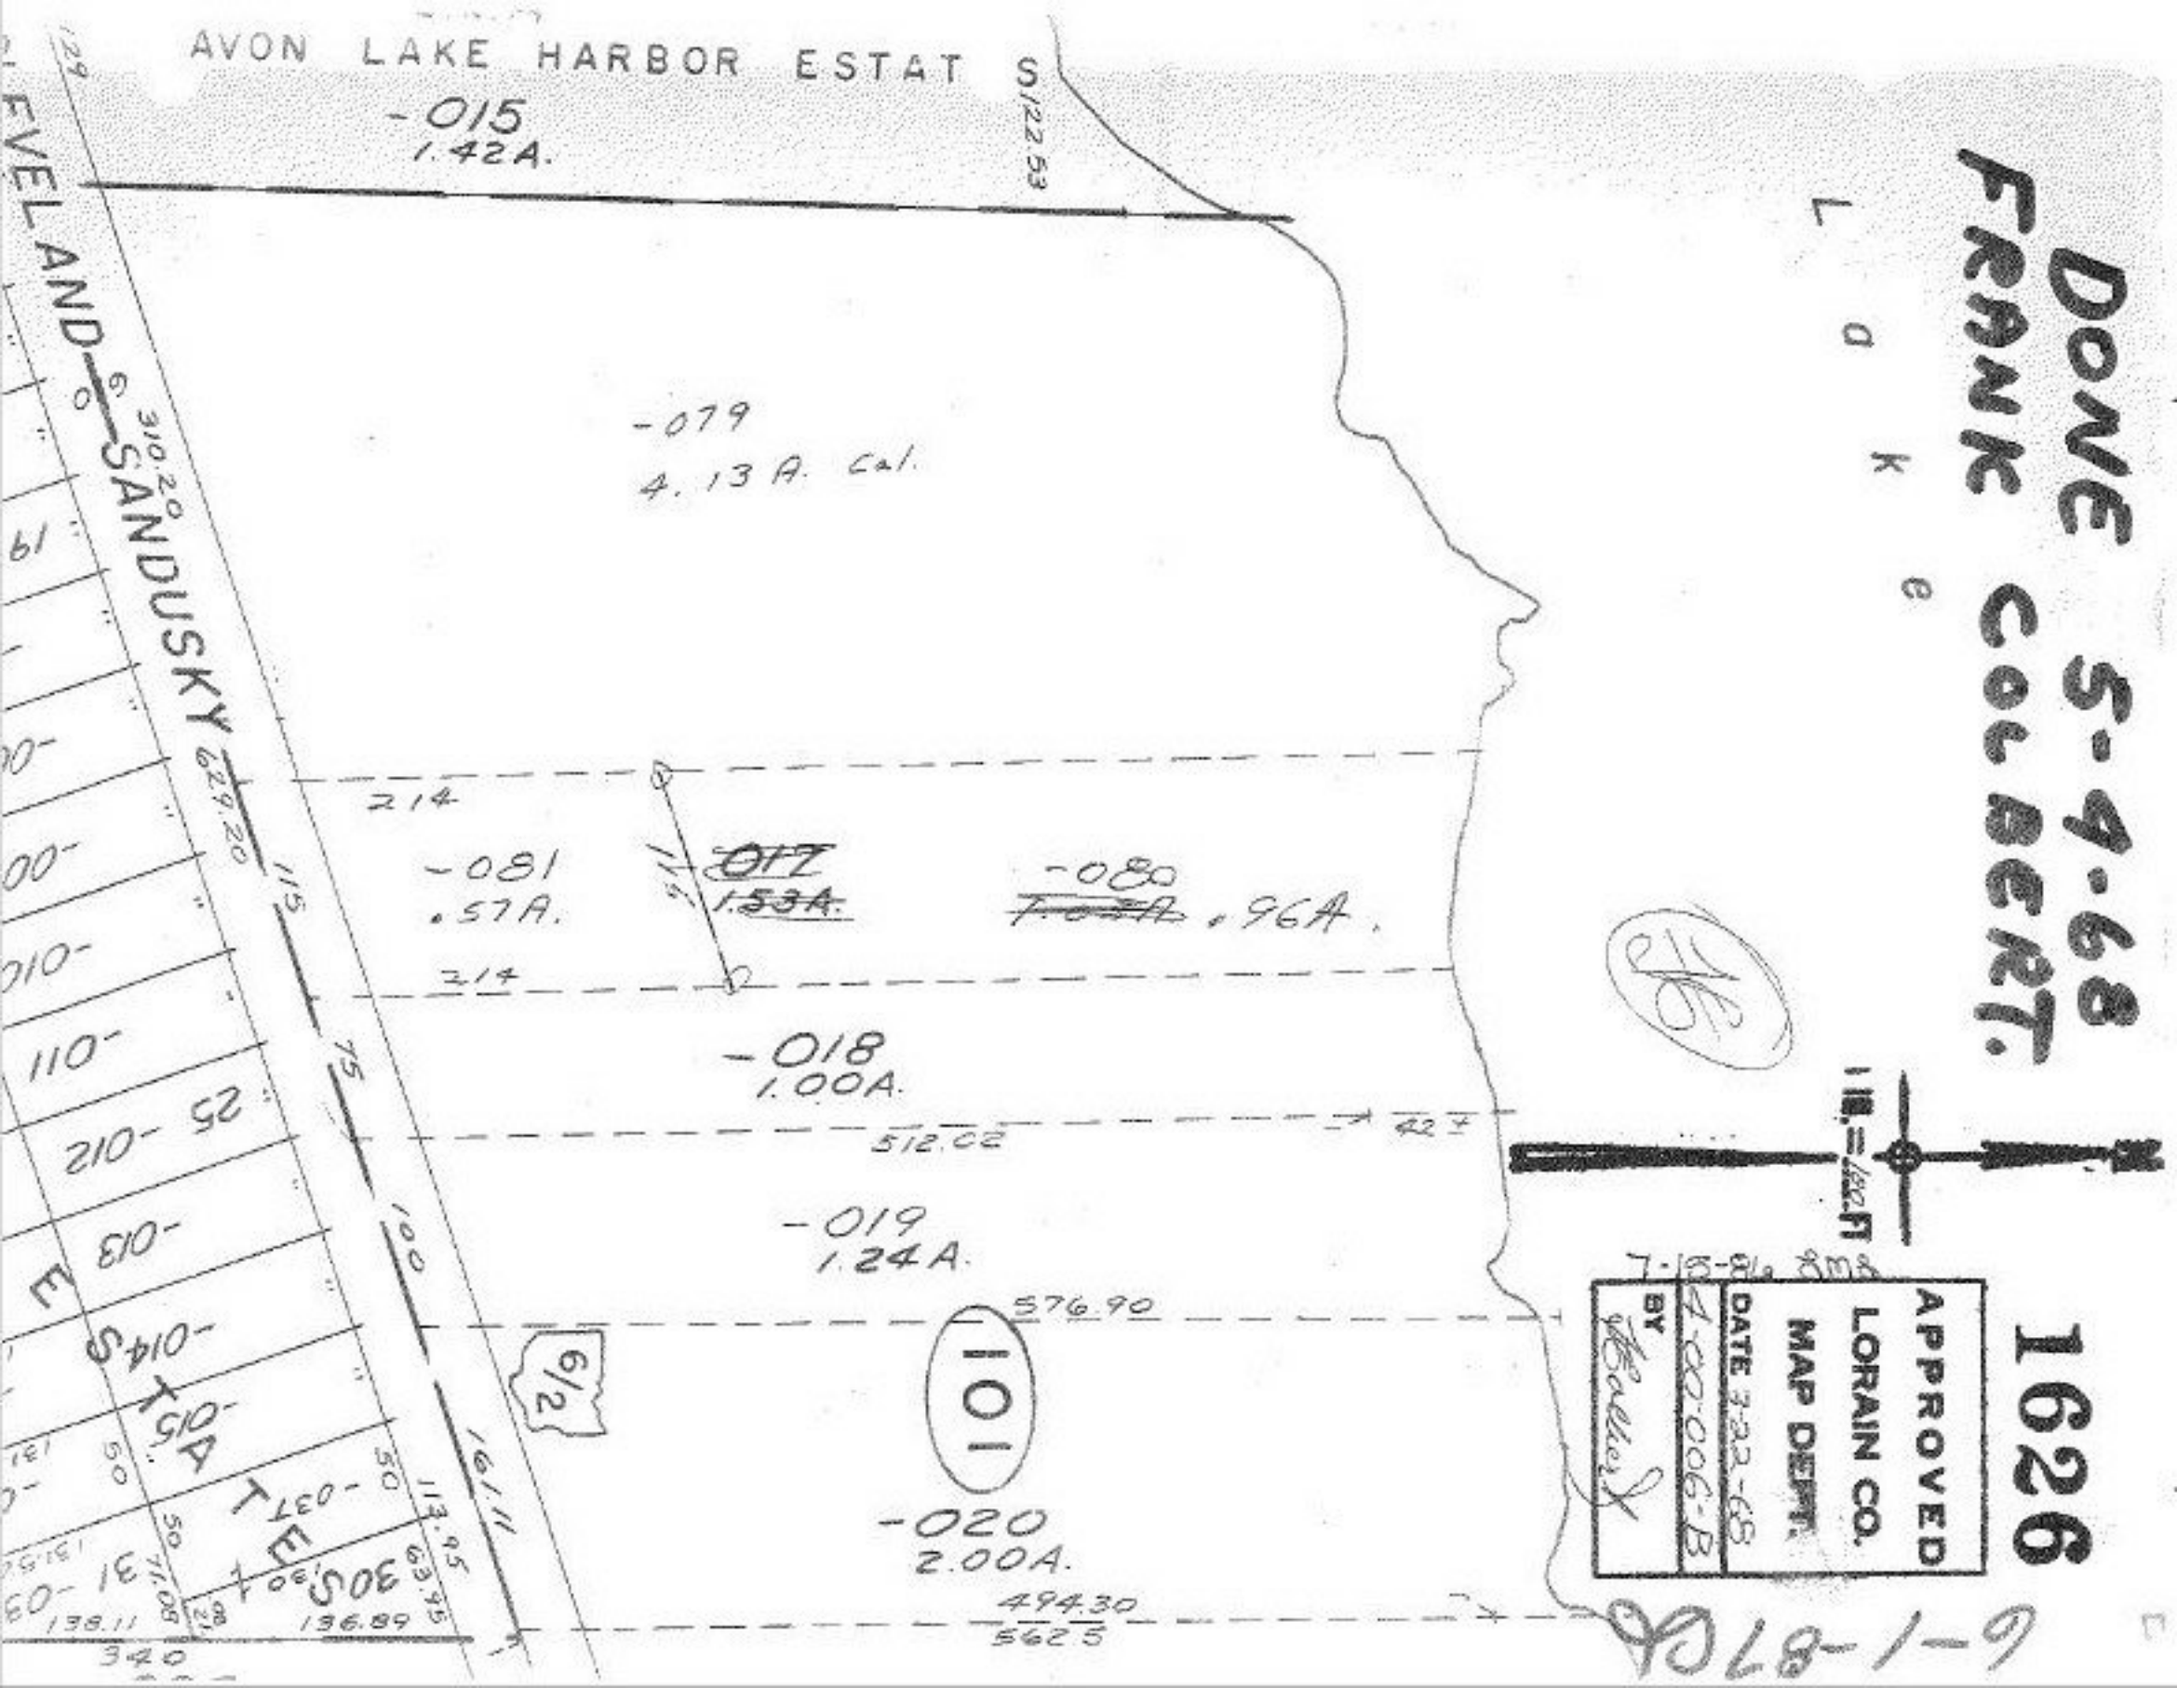
AVON LAKE HARBOR ESTAT S
-015
1.42A.
122.53
-079
4.13 A. Cal.
214
-081
.57A.
-017
1.53A.
-080
.96A.
214
-018
1.00A.
512.02
42.7
-019
1.24A.
576.90
101
-020
2.00A.
494.30
562.5
6/2
EVELAND
SANDUSKY
229.20
310.20
115
75
100
161.11
113.95
63.95
196.89
138.11
340
61
00-
00-
010-
110-
210-
52
810-
014-
S10-
A
T10-
037-
T
E
30S
E
1626
DOVE S-4-68
FRANK COLBERT.
Lake
1 IN. = 100 FT.
APPROVED
LORAIN CO.
MAP DEPT.
DATE 3-22-68
BY
4-30-006-B
9-18-1-9