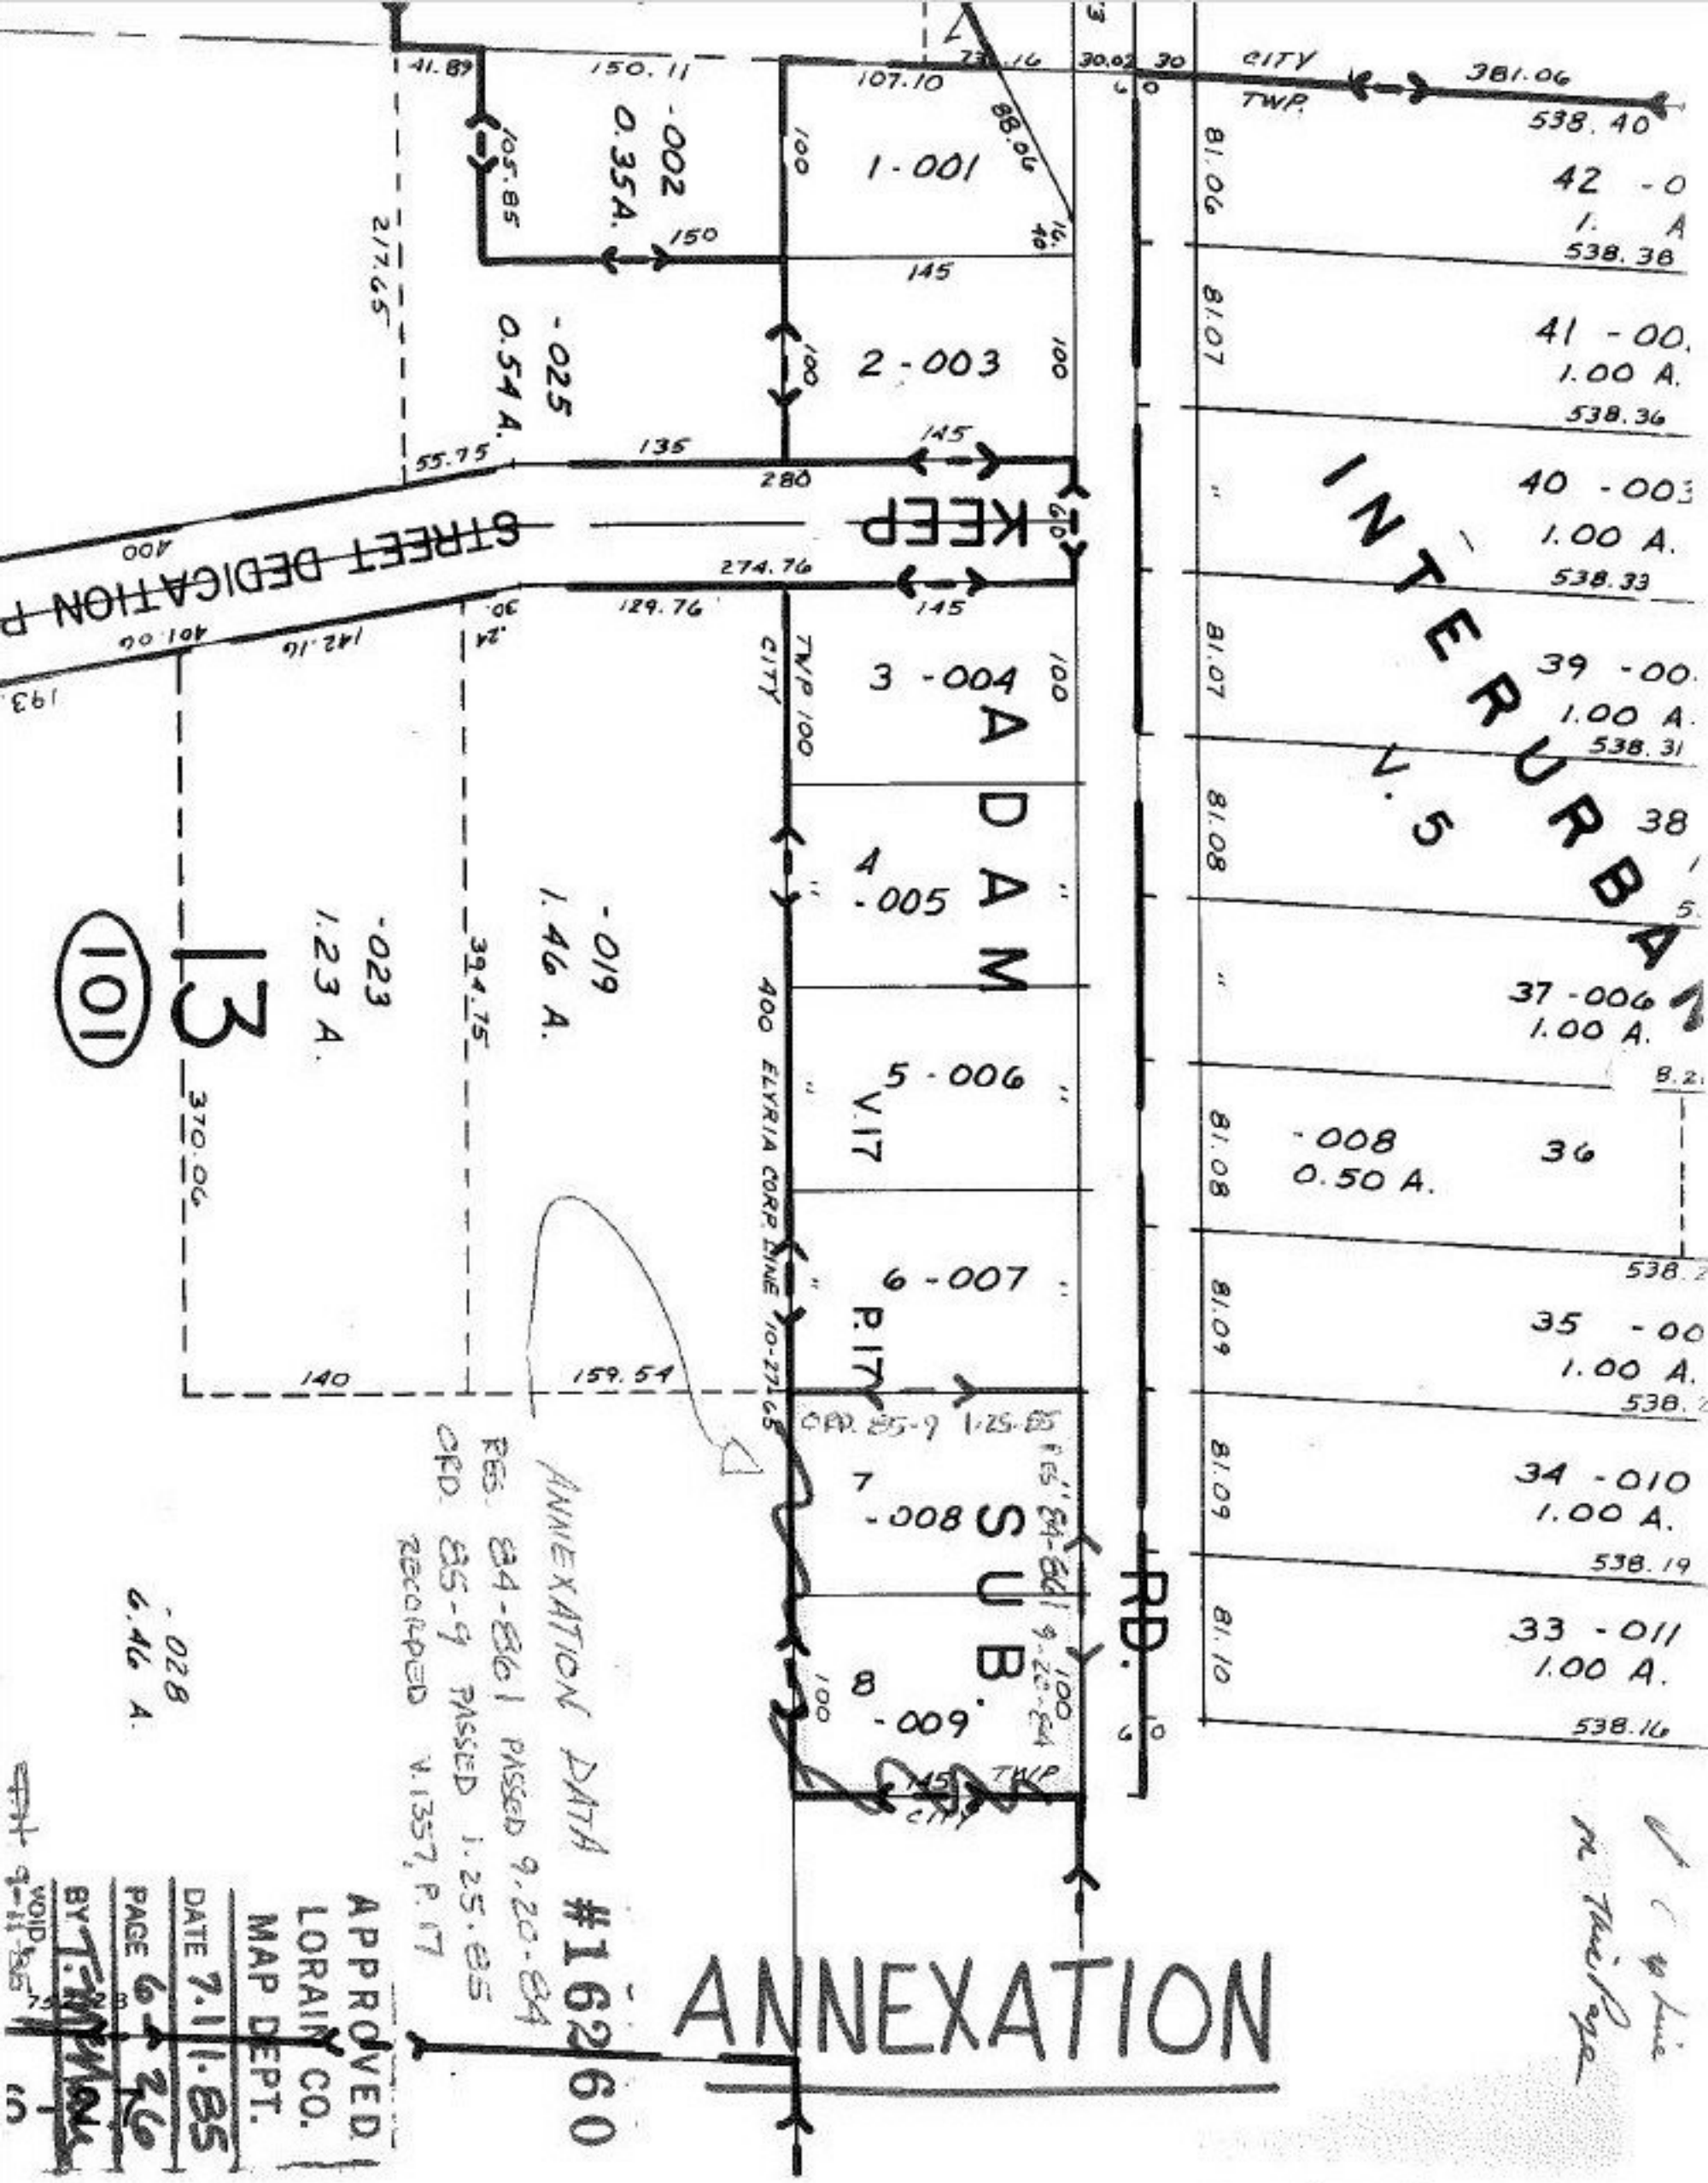

ANNEXATION
INTERURBAN
V.5
ADAM
SUB.
RD.
KEEP
STREET DEDICATION P
CITY
TWP.
ELYRIA CORP. LINE
1-001
2-003
3-004
4-005
5-006
6-007
7-008
8-009
-002
0.35A.
-025
0.54 A.
-019
1.46 A.
-023
1.23 A.
-008
0.50 A.
-028
6.46 A.
13
101
ANNEXATION DATA #16260
RES. 84-861 PASSED 9.20.84
ORD. 85-9 PASSED 1.25.85
RECORDED V.1357, P.17
APPROVED
LORAIN CO.
MAP DEPT.
DATE 7.11.85
PAGE 6-26
BY T.M.
VOID