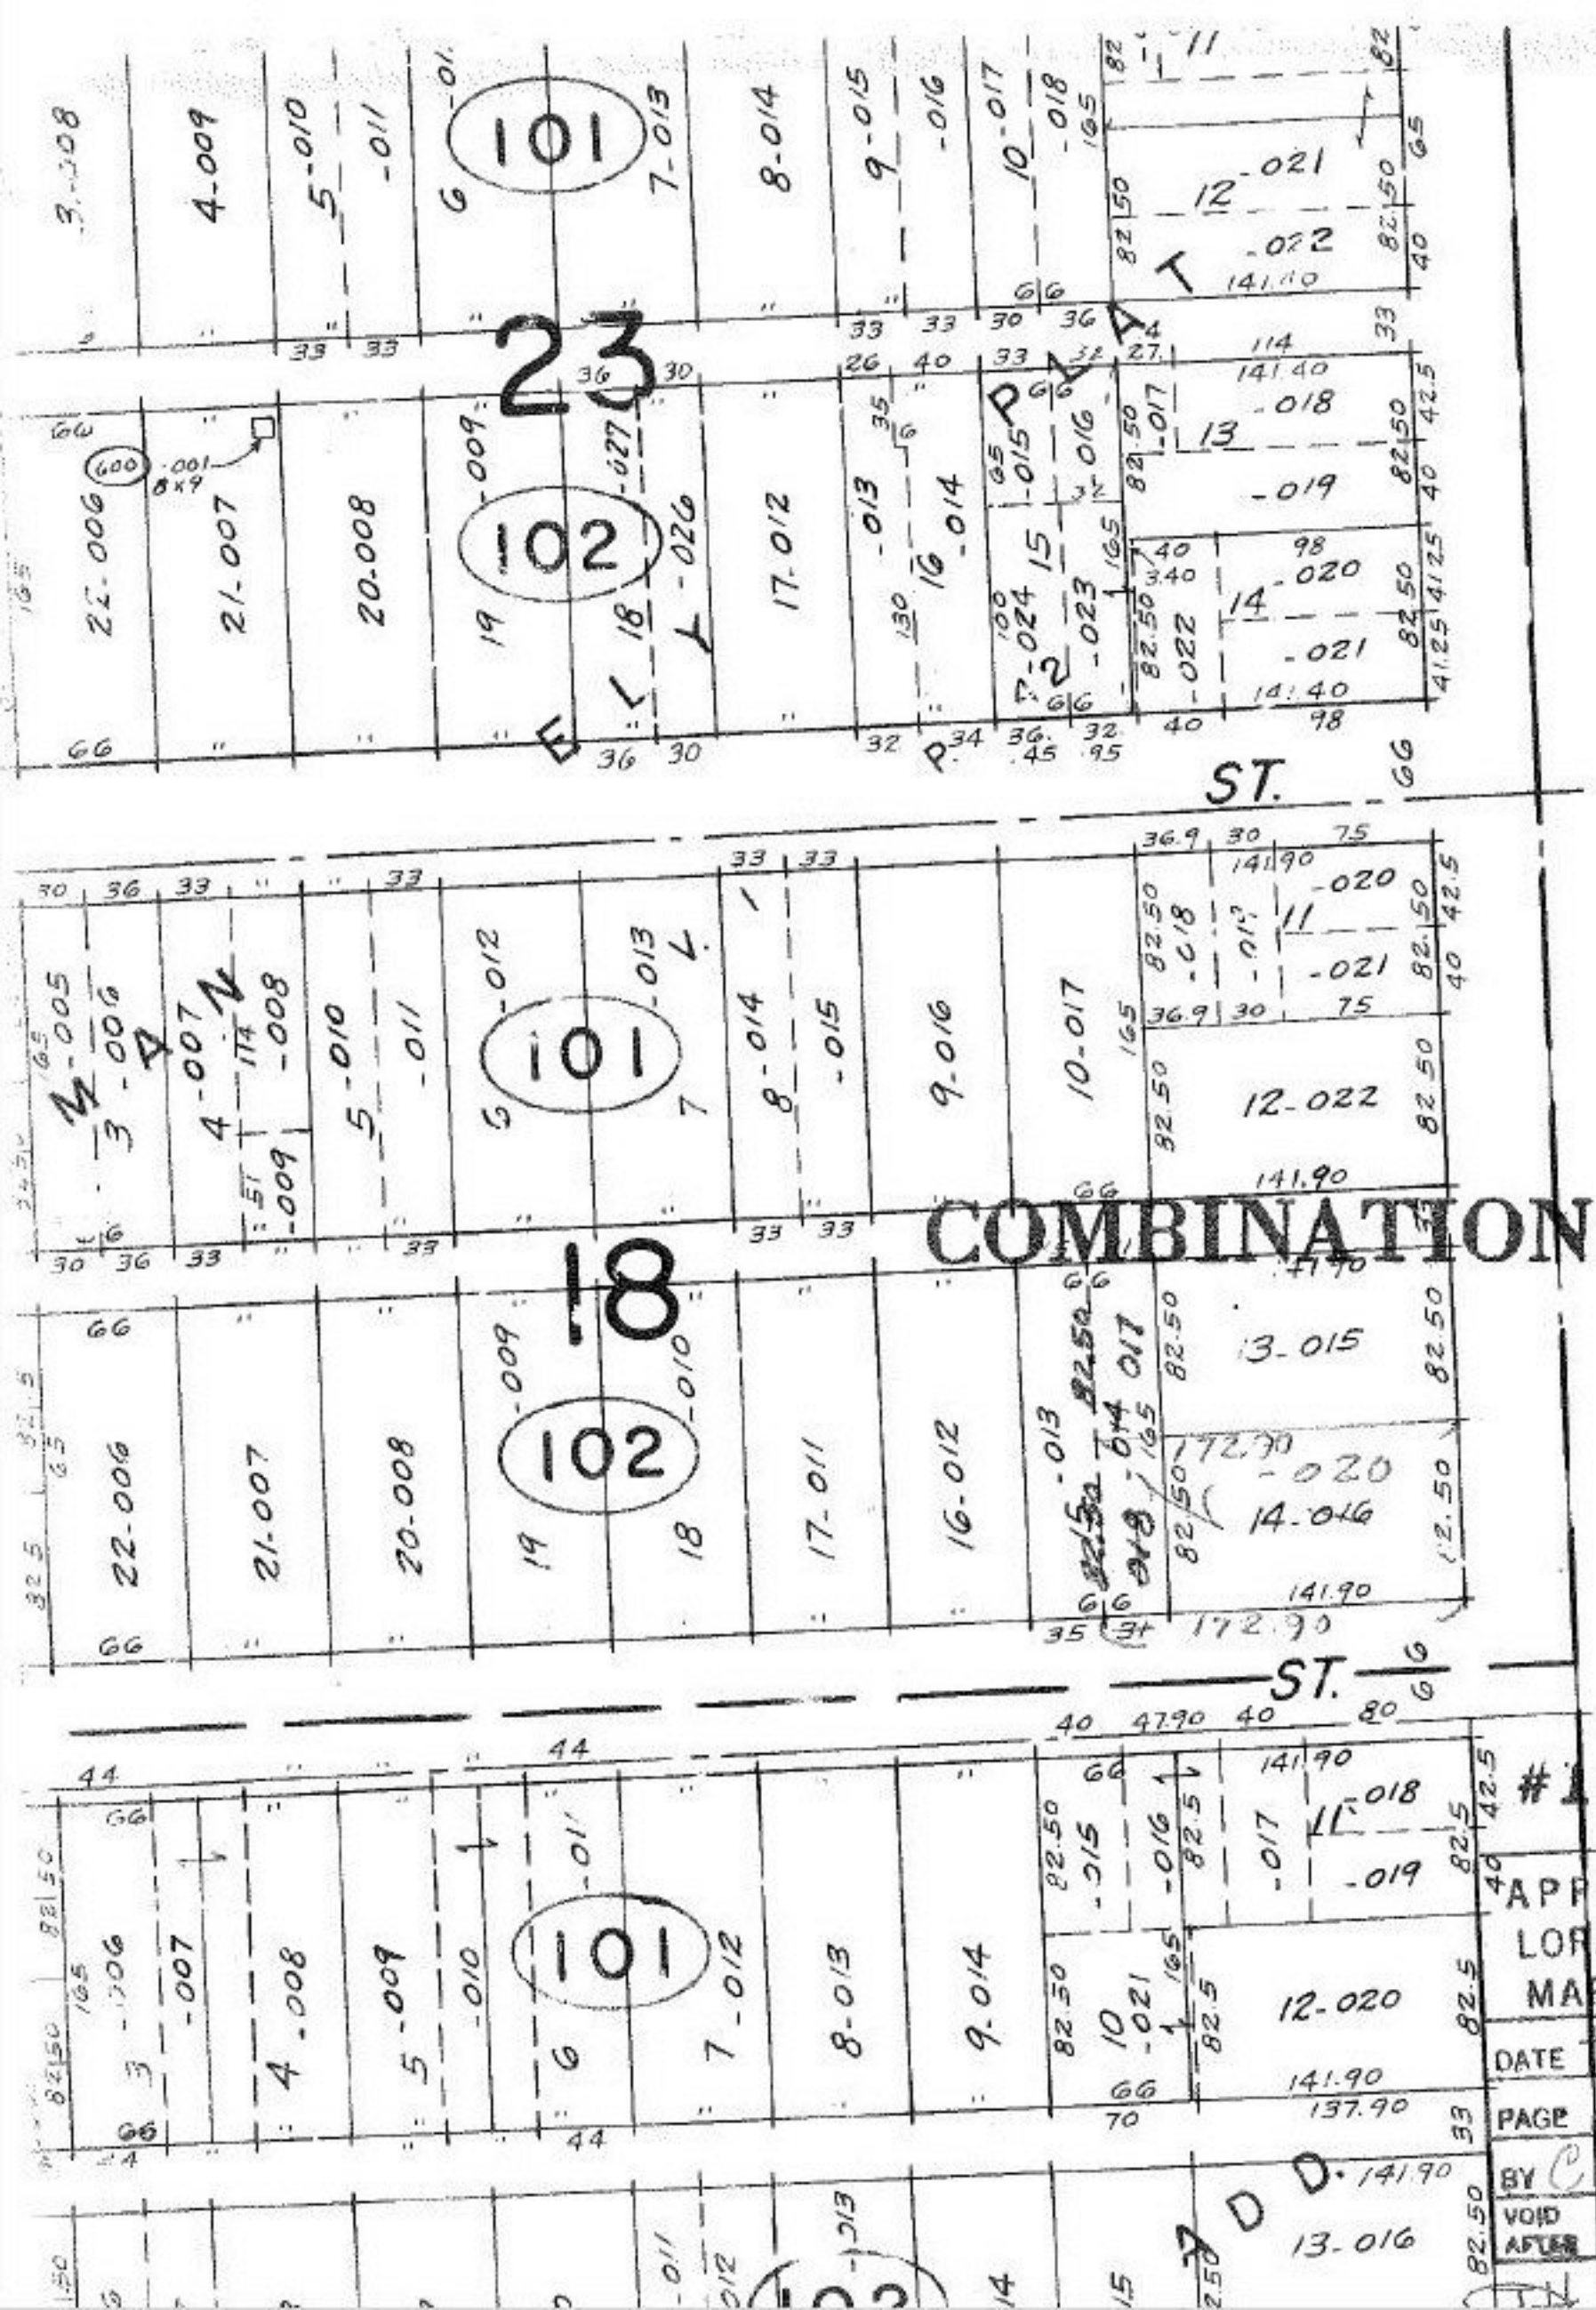
23
102
101
ST.
18
COMBINATION
102
101
ST.
#16263
APPROVED
LORAIN CO.
MAP DEPT.
DATE 7-11-85
PAGE 6-137
BY C Francis
VOID AFTER