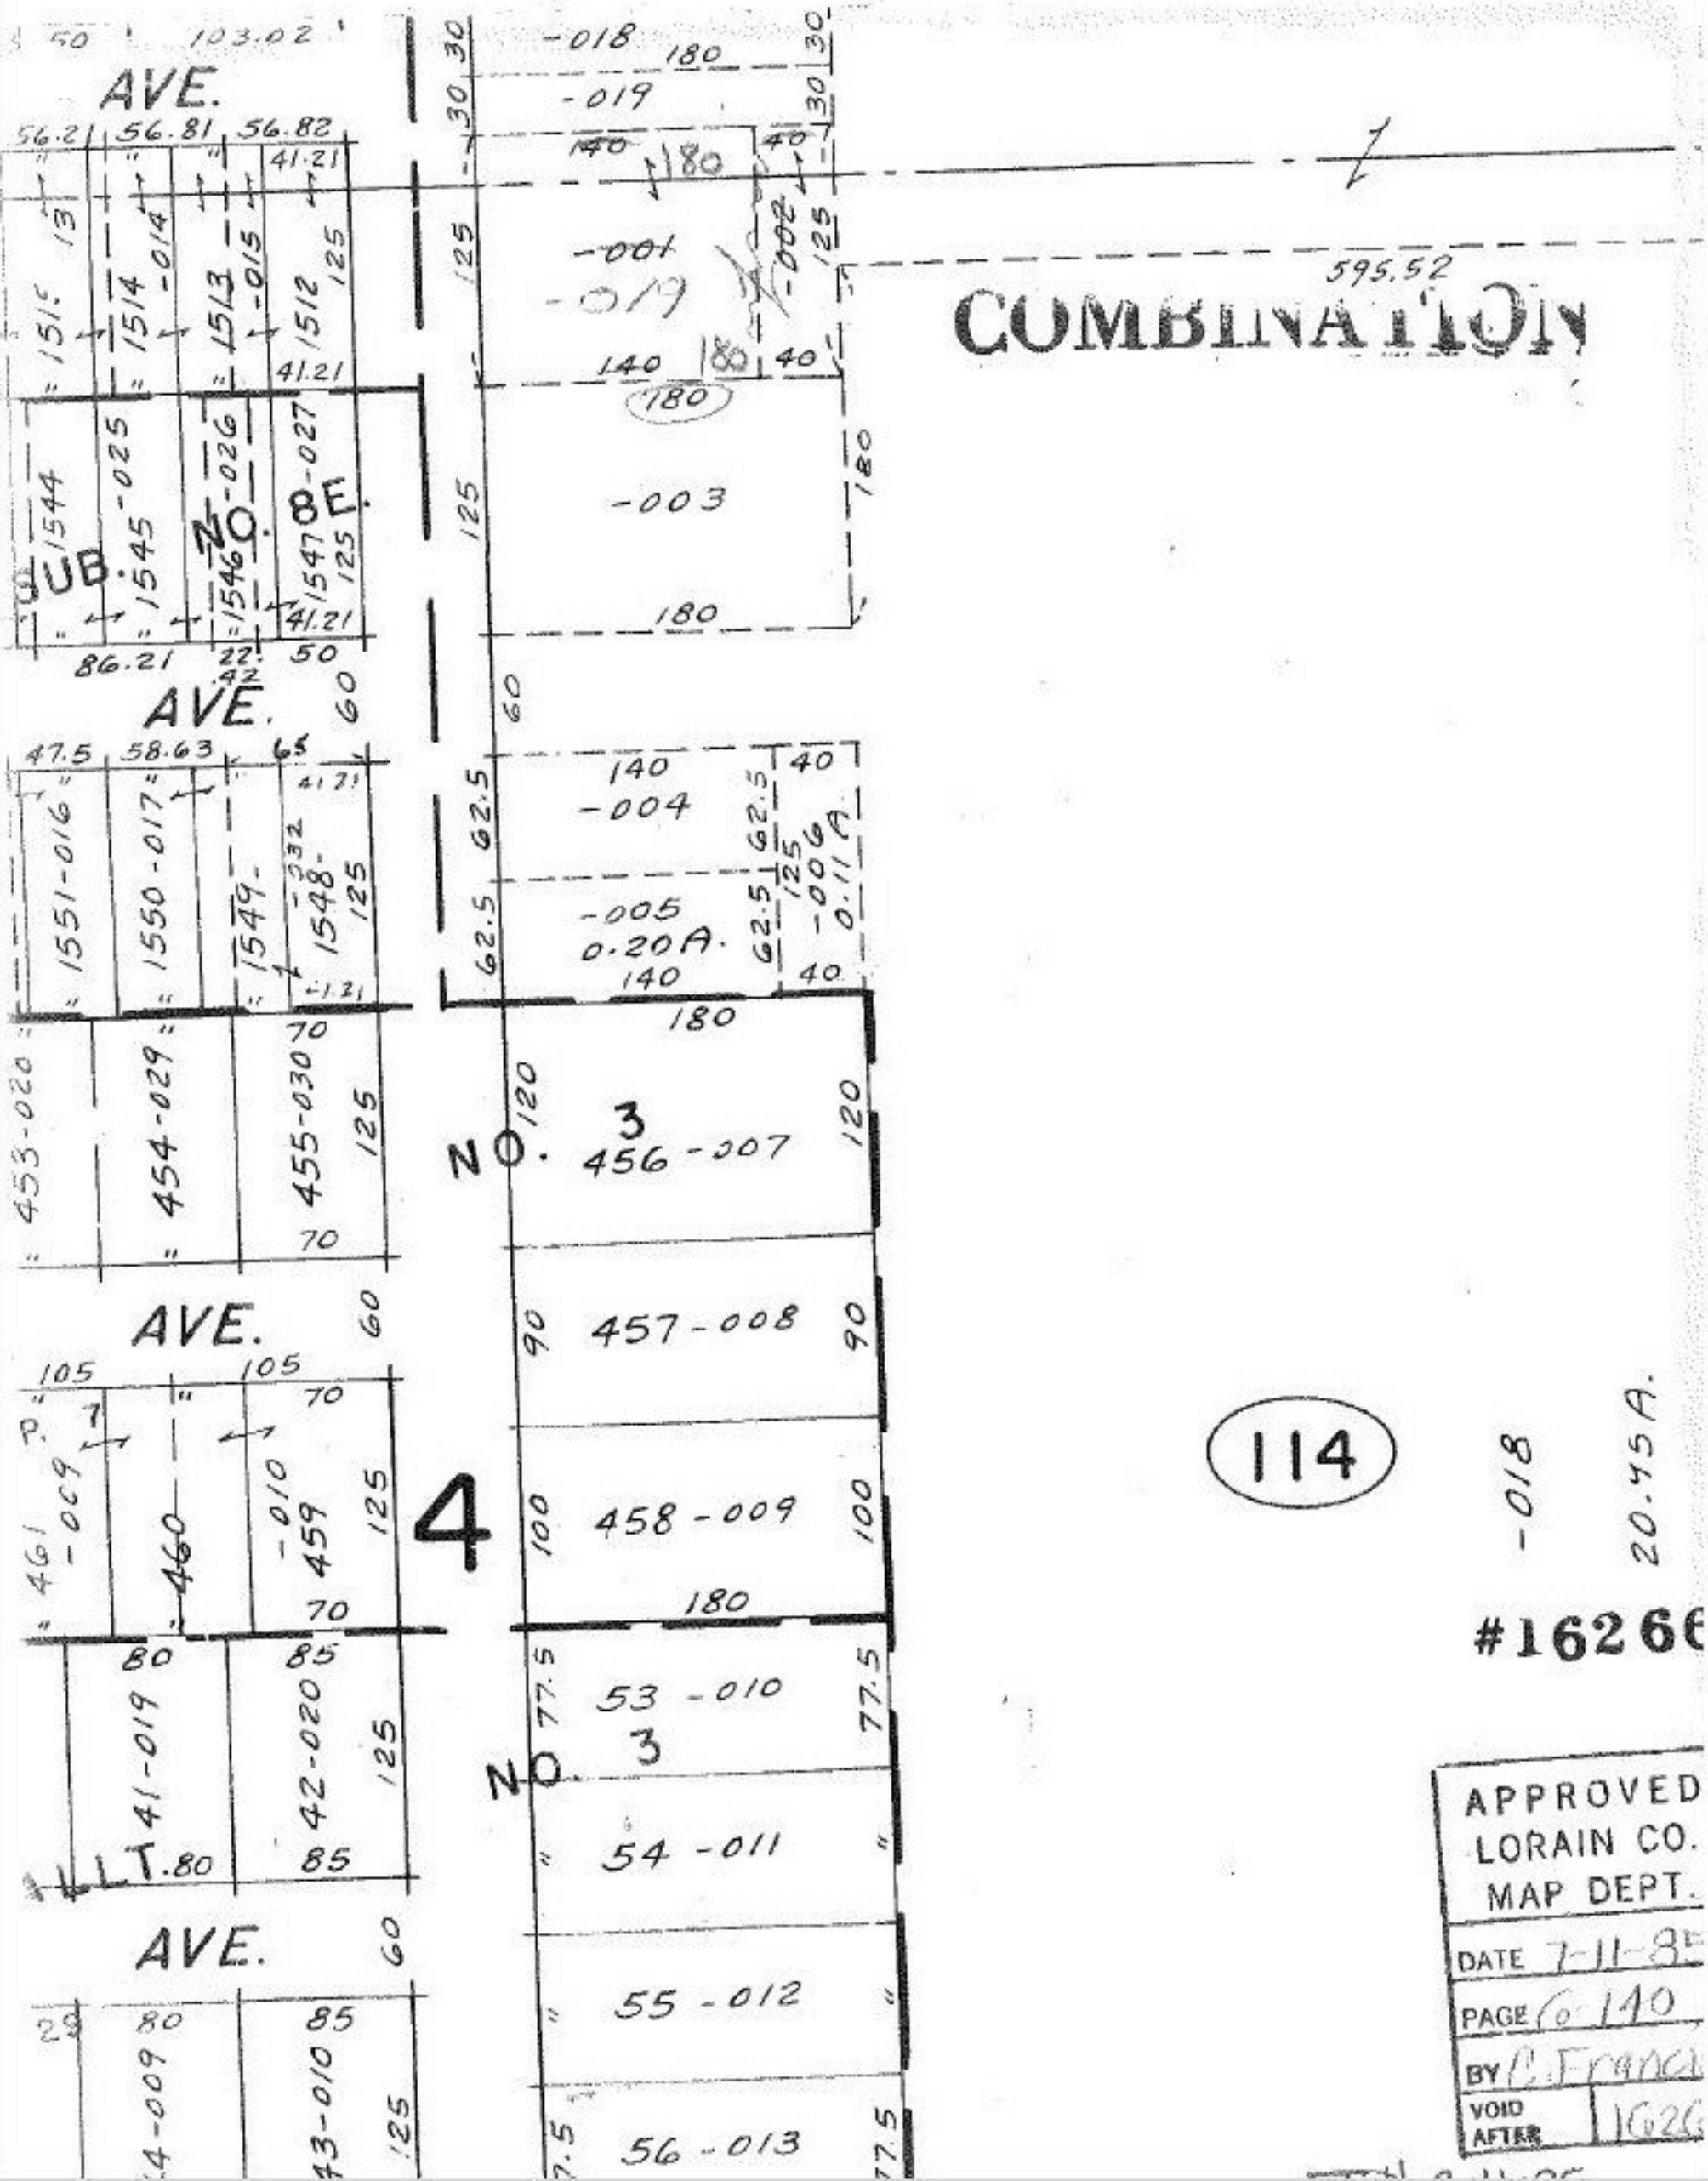

AVE.
SUB. NO. 8E.
AVE.
AVE.
AVE.
NO. 3
NO. 3
4
COMBINATION
595.52
114
#16266
APPROVED
LORAIN CO.
MAP DEPT.
DATE 7-11-85
PAGE 6 140
BY C. Franci
VOID AFTER 1626