16271

SEE 6-100
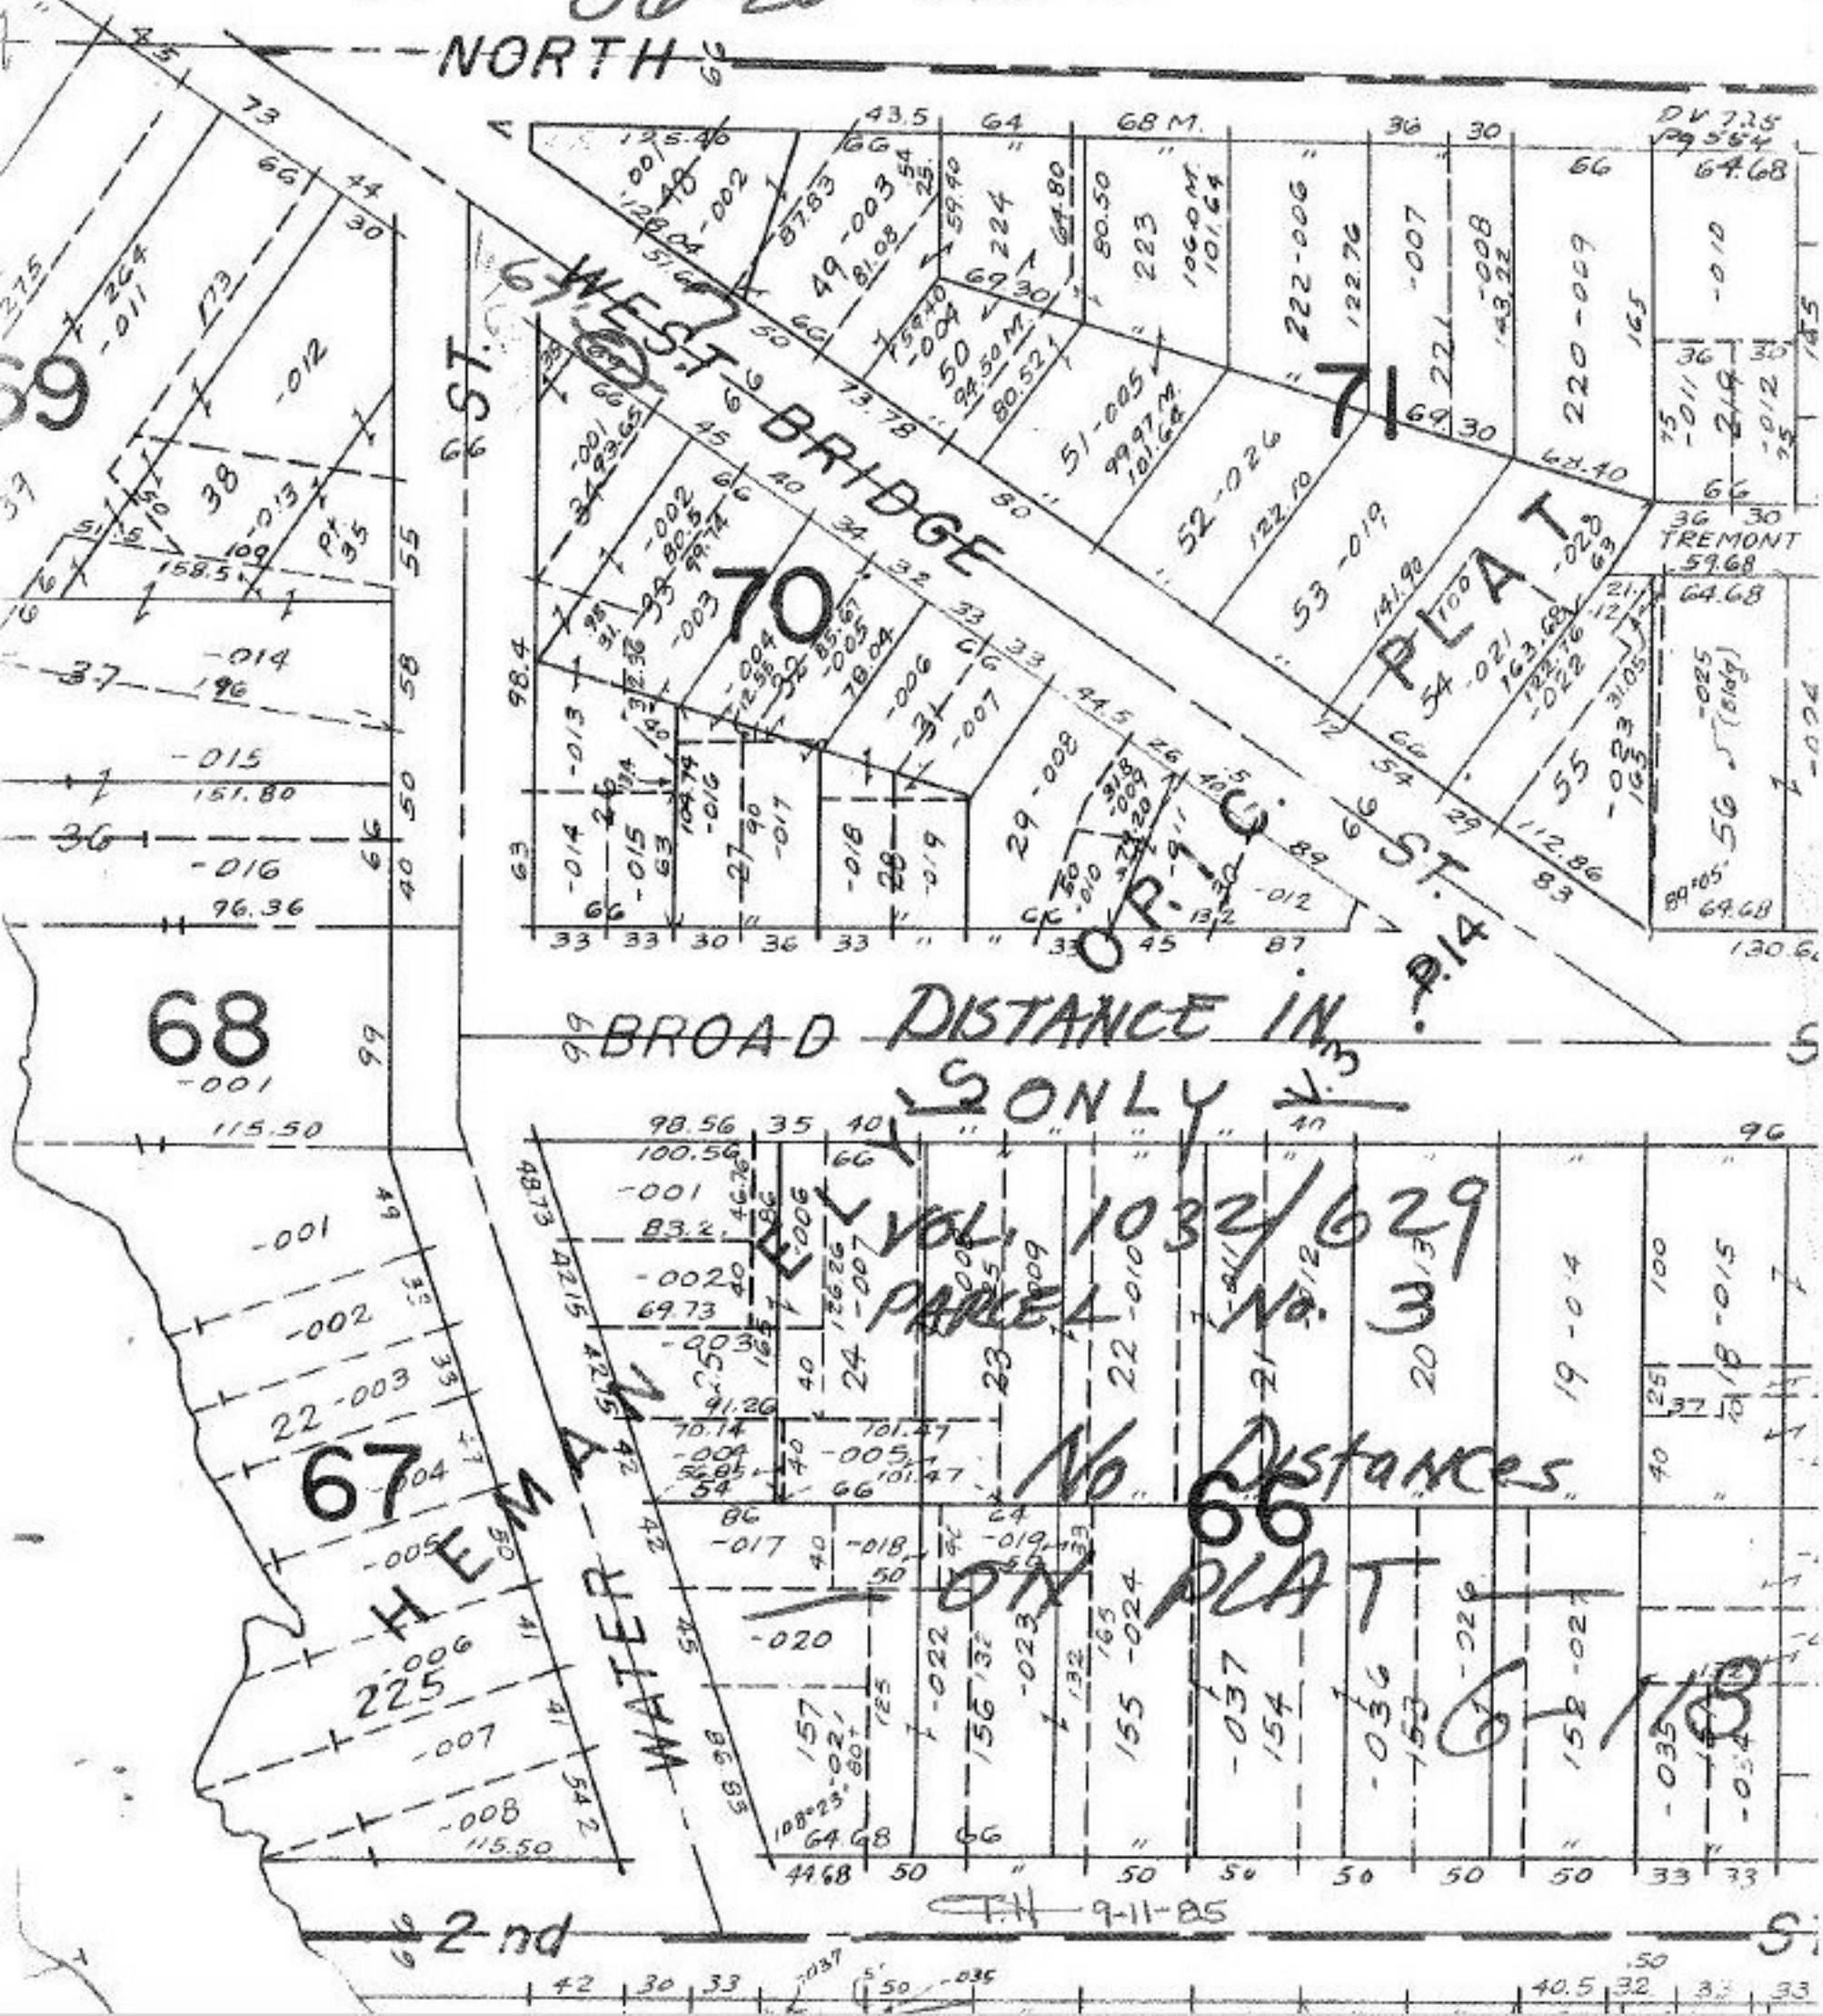
06-26-070-000-001