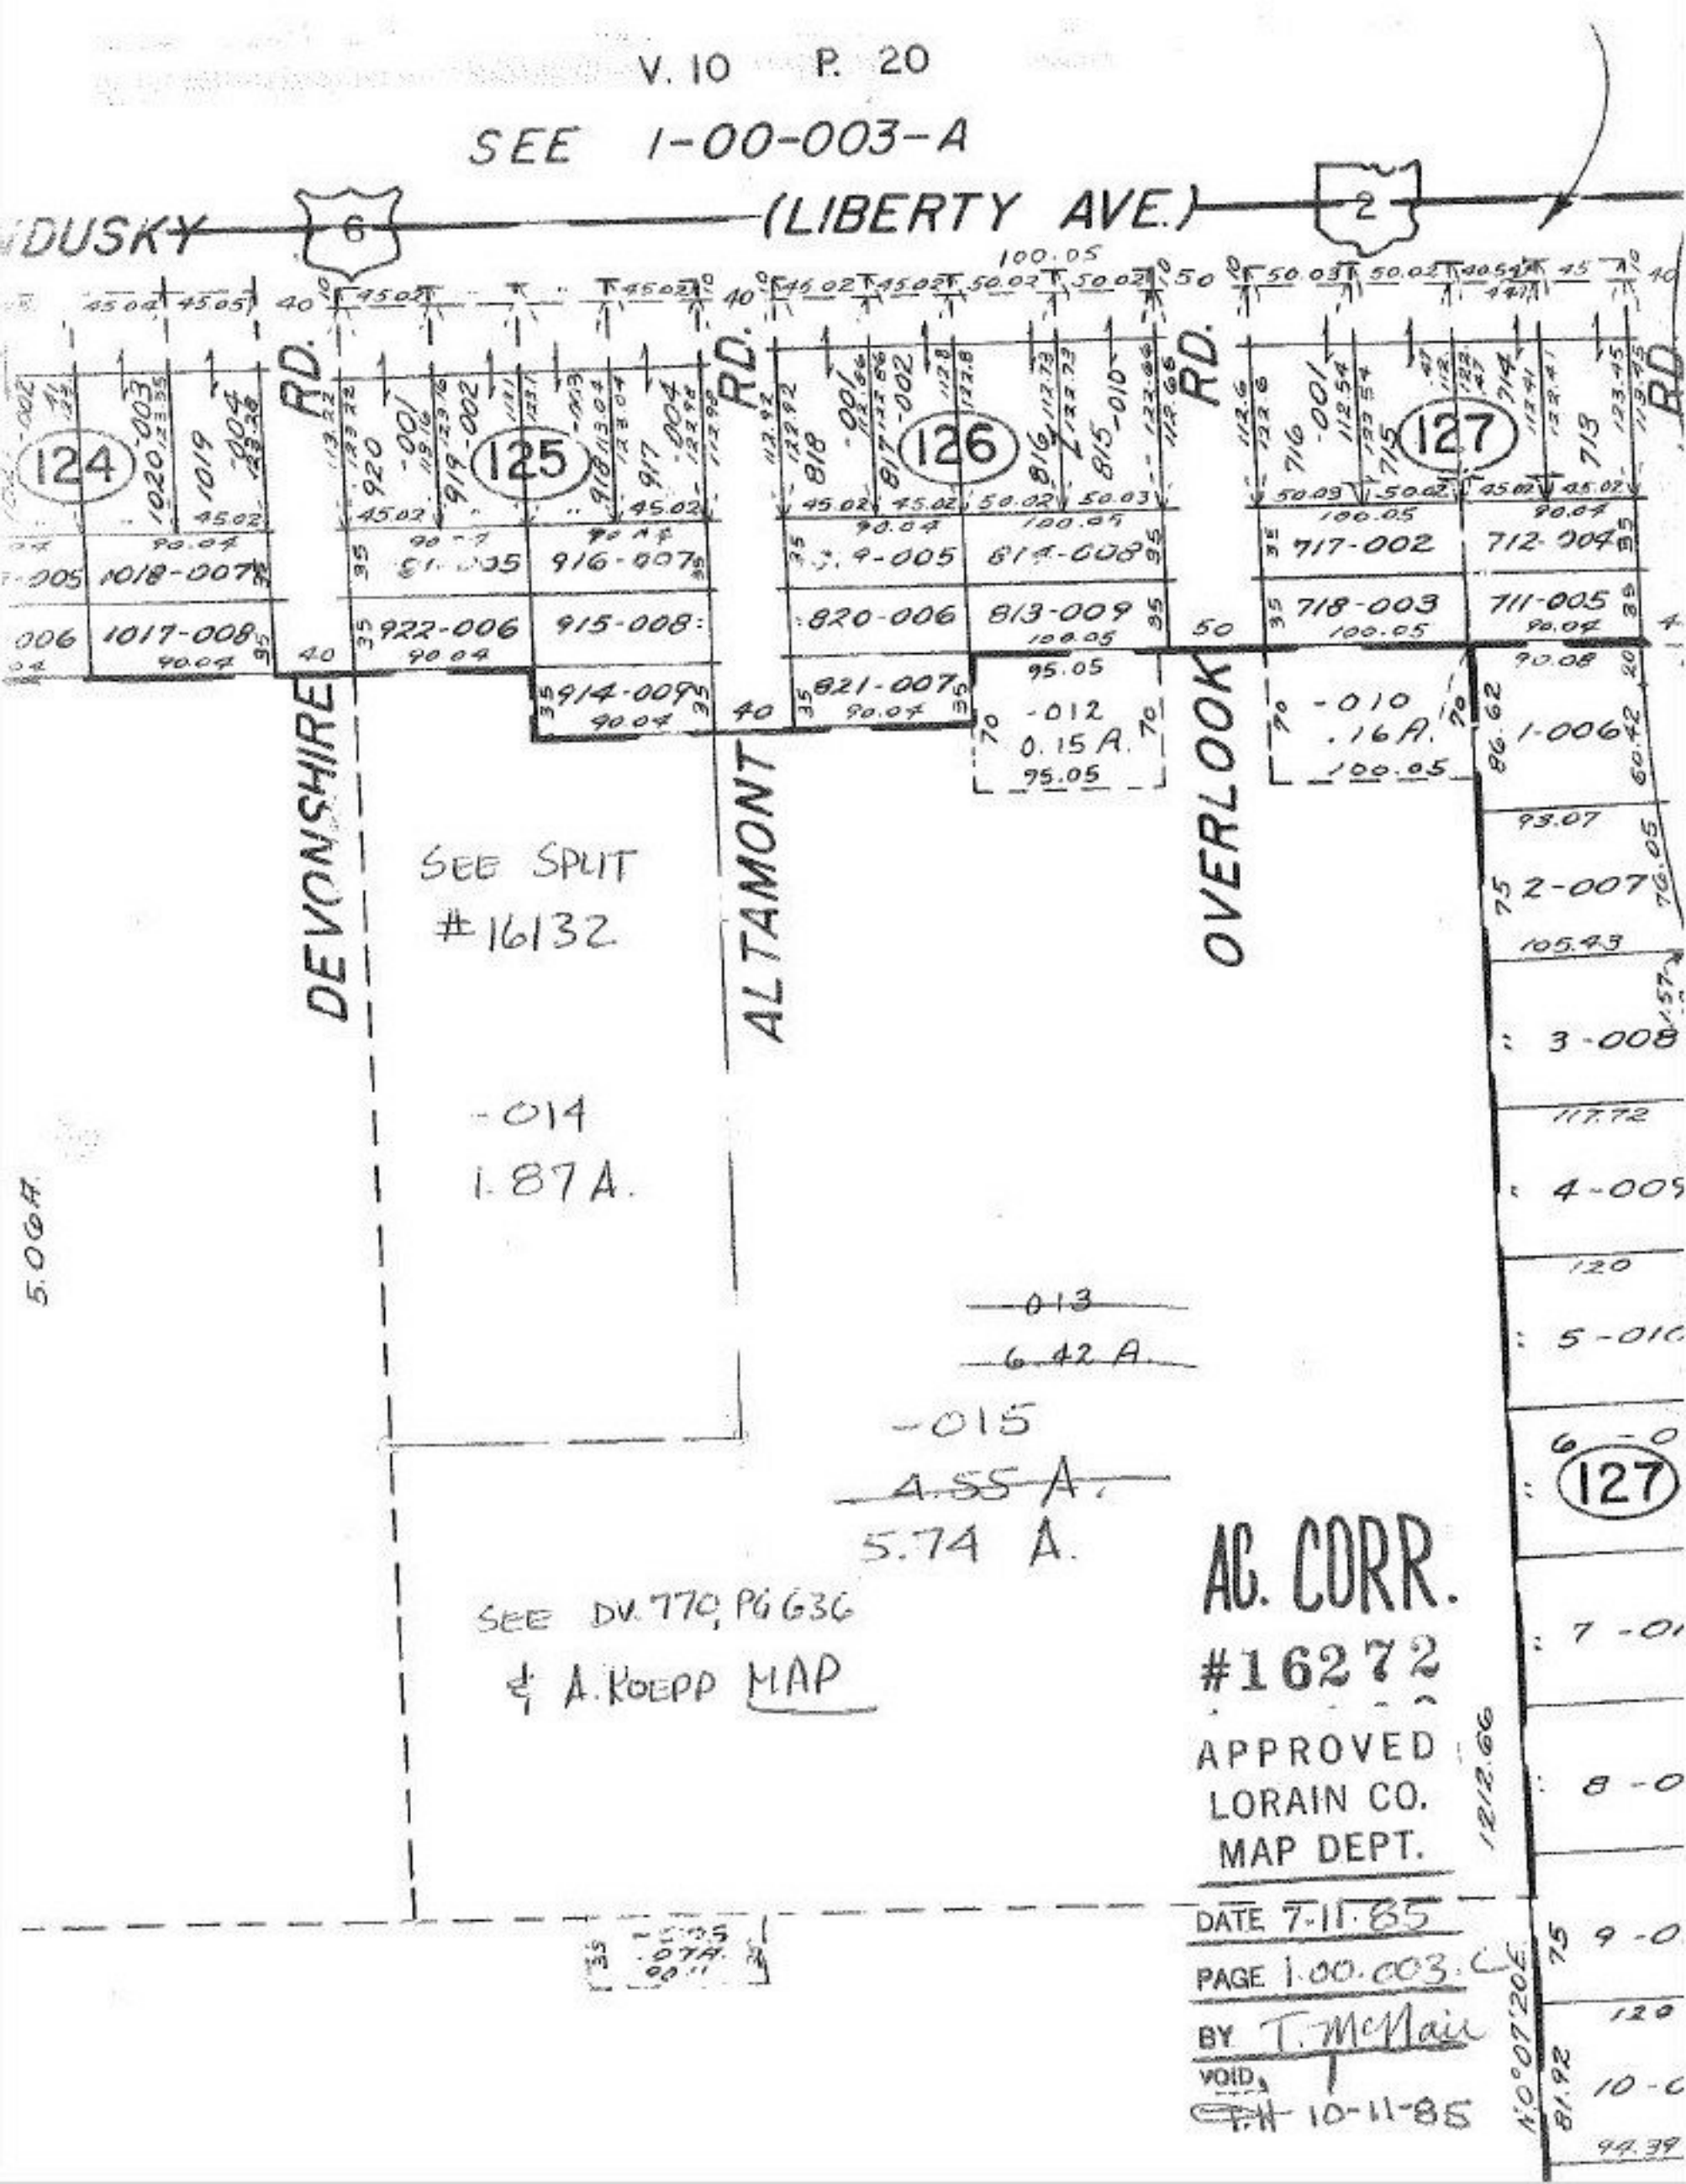
V. 10 P. 20
SEE 1-00-003-A
DUSKY
6
(LIBERTY AVE.)
2
124
125
126
127
DEVONSHIRE RD.
ALTAMONT RD.
OVERLOOK RD.
1018-007
1017-008
922-006
916-007
915-008
914-009
820-006
821-007
813-009
814-008
717-002
718-003
712-004
711-005
-012
0.15 A.
-010
.16 A.
1-006
2-007
3-008
4-009
5-010
6-0
127
7-01
8-0
9-0
10-0
SEE SPLIT
#16132
-014
1.87 A.
-013
6.42 A.
-015
4.55 A.
5.74 A.
SEE DV. 770, PG 636
& A. KOEPP MAP
5.06 A.
AC. CORR.
#16272
APPROVED
LORAIN CO.
MAP DEPT.
DATE 7-11-85
PAGE 1.00.003.C
BY T. McNair
VOID
10-11-85
1212.66
N 0°07'20 E
81.92