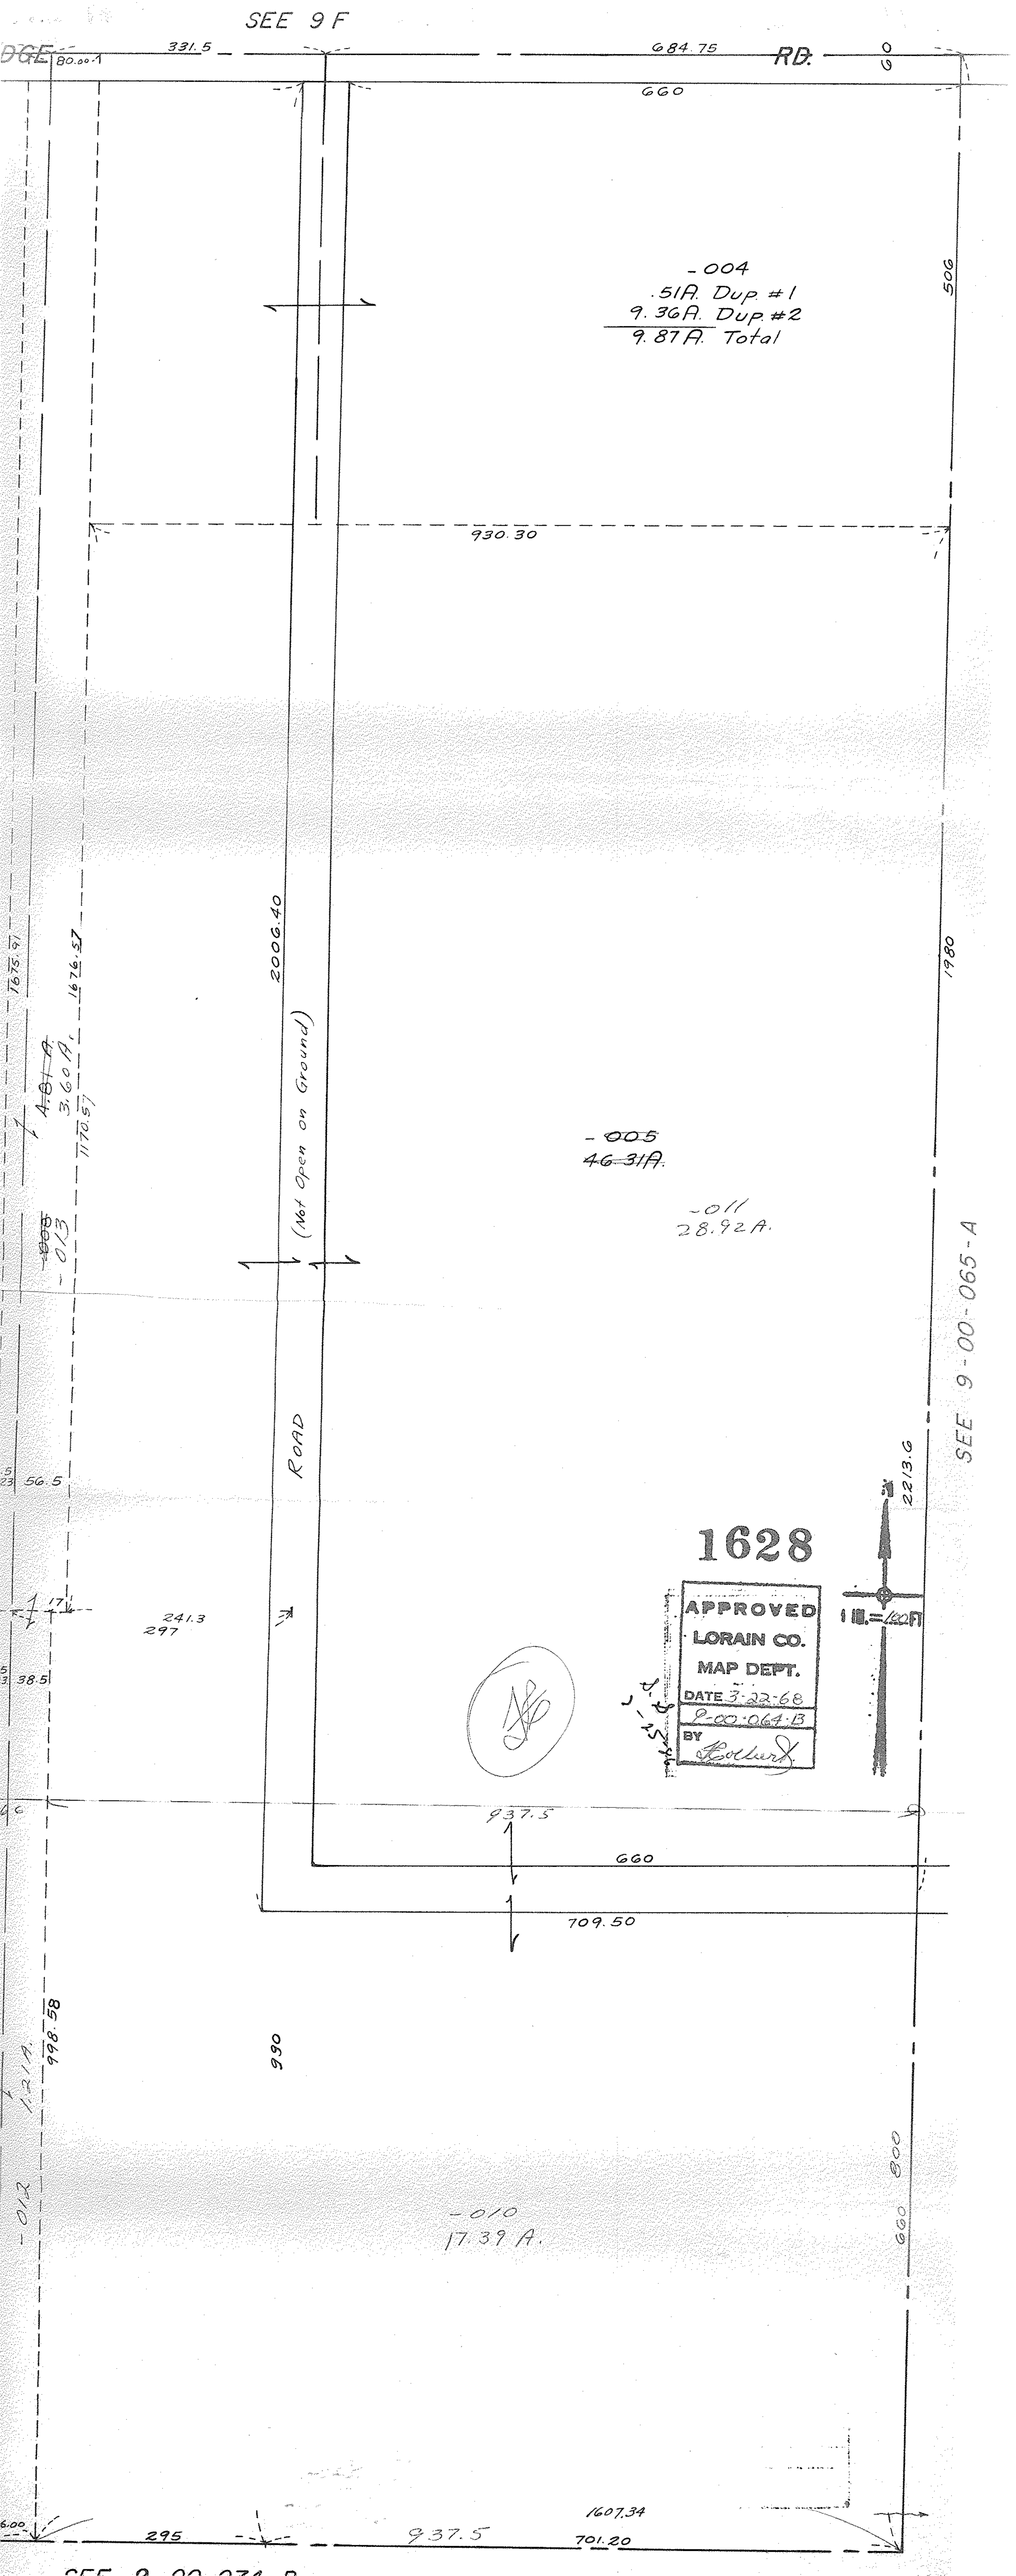
SEE 9 F
DGE
331.5
80.00
684.75
RD.
660
-004
.51A. Dup. #1
9.36A. Dup. #2
9.87A. Total
505
930.30
2006.40
(Not Open on Ground)
1676.57
1980
-005
46.31A.
-011
28.92A.
ROAD
SEE 9-00-065-A
2213.6
1628
APPROVED
LORAIN CO.
MAP DEPT.
DATE 3-22-68
9-00-064.13
BY
1" = 100'
937.5
660
709.50
998.58
990
-012
1.21A.
-010
17.39 A.
800
660
1607.34
295
937.5
701.20