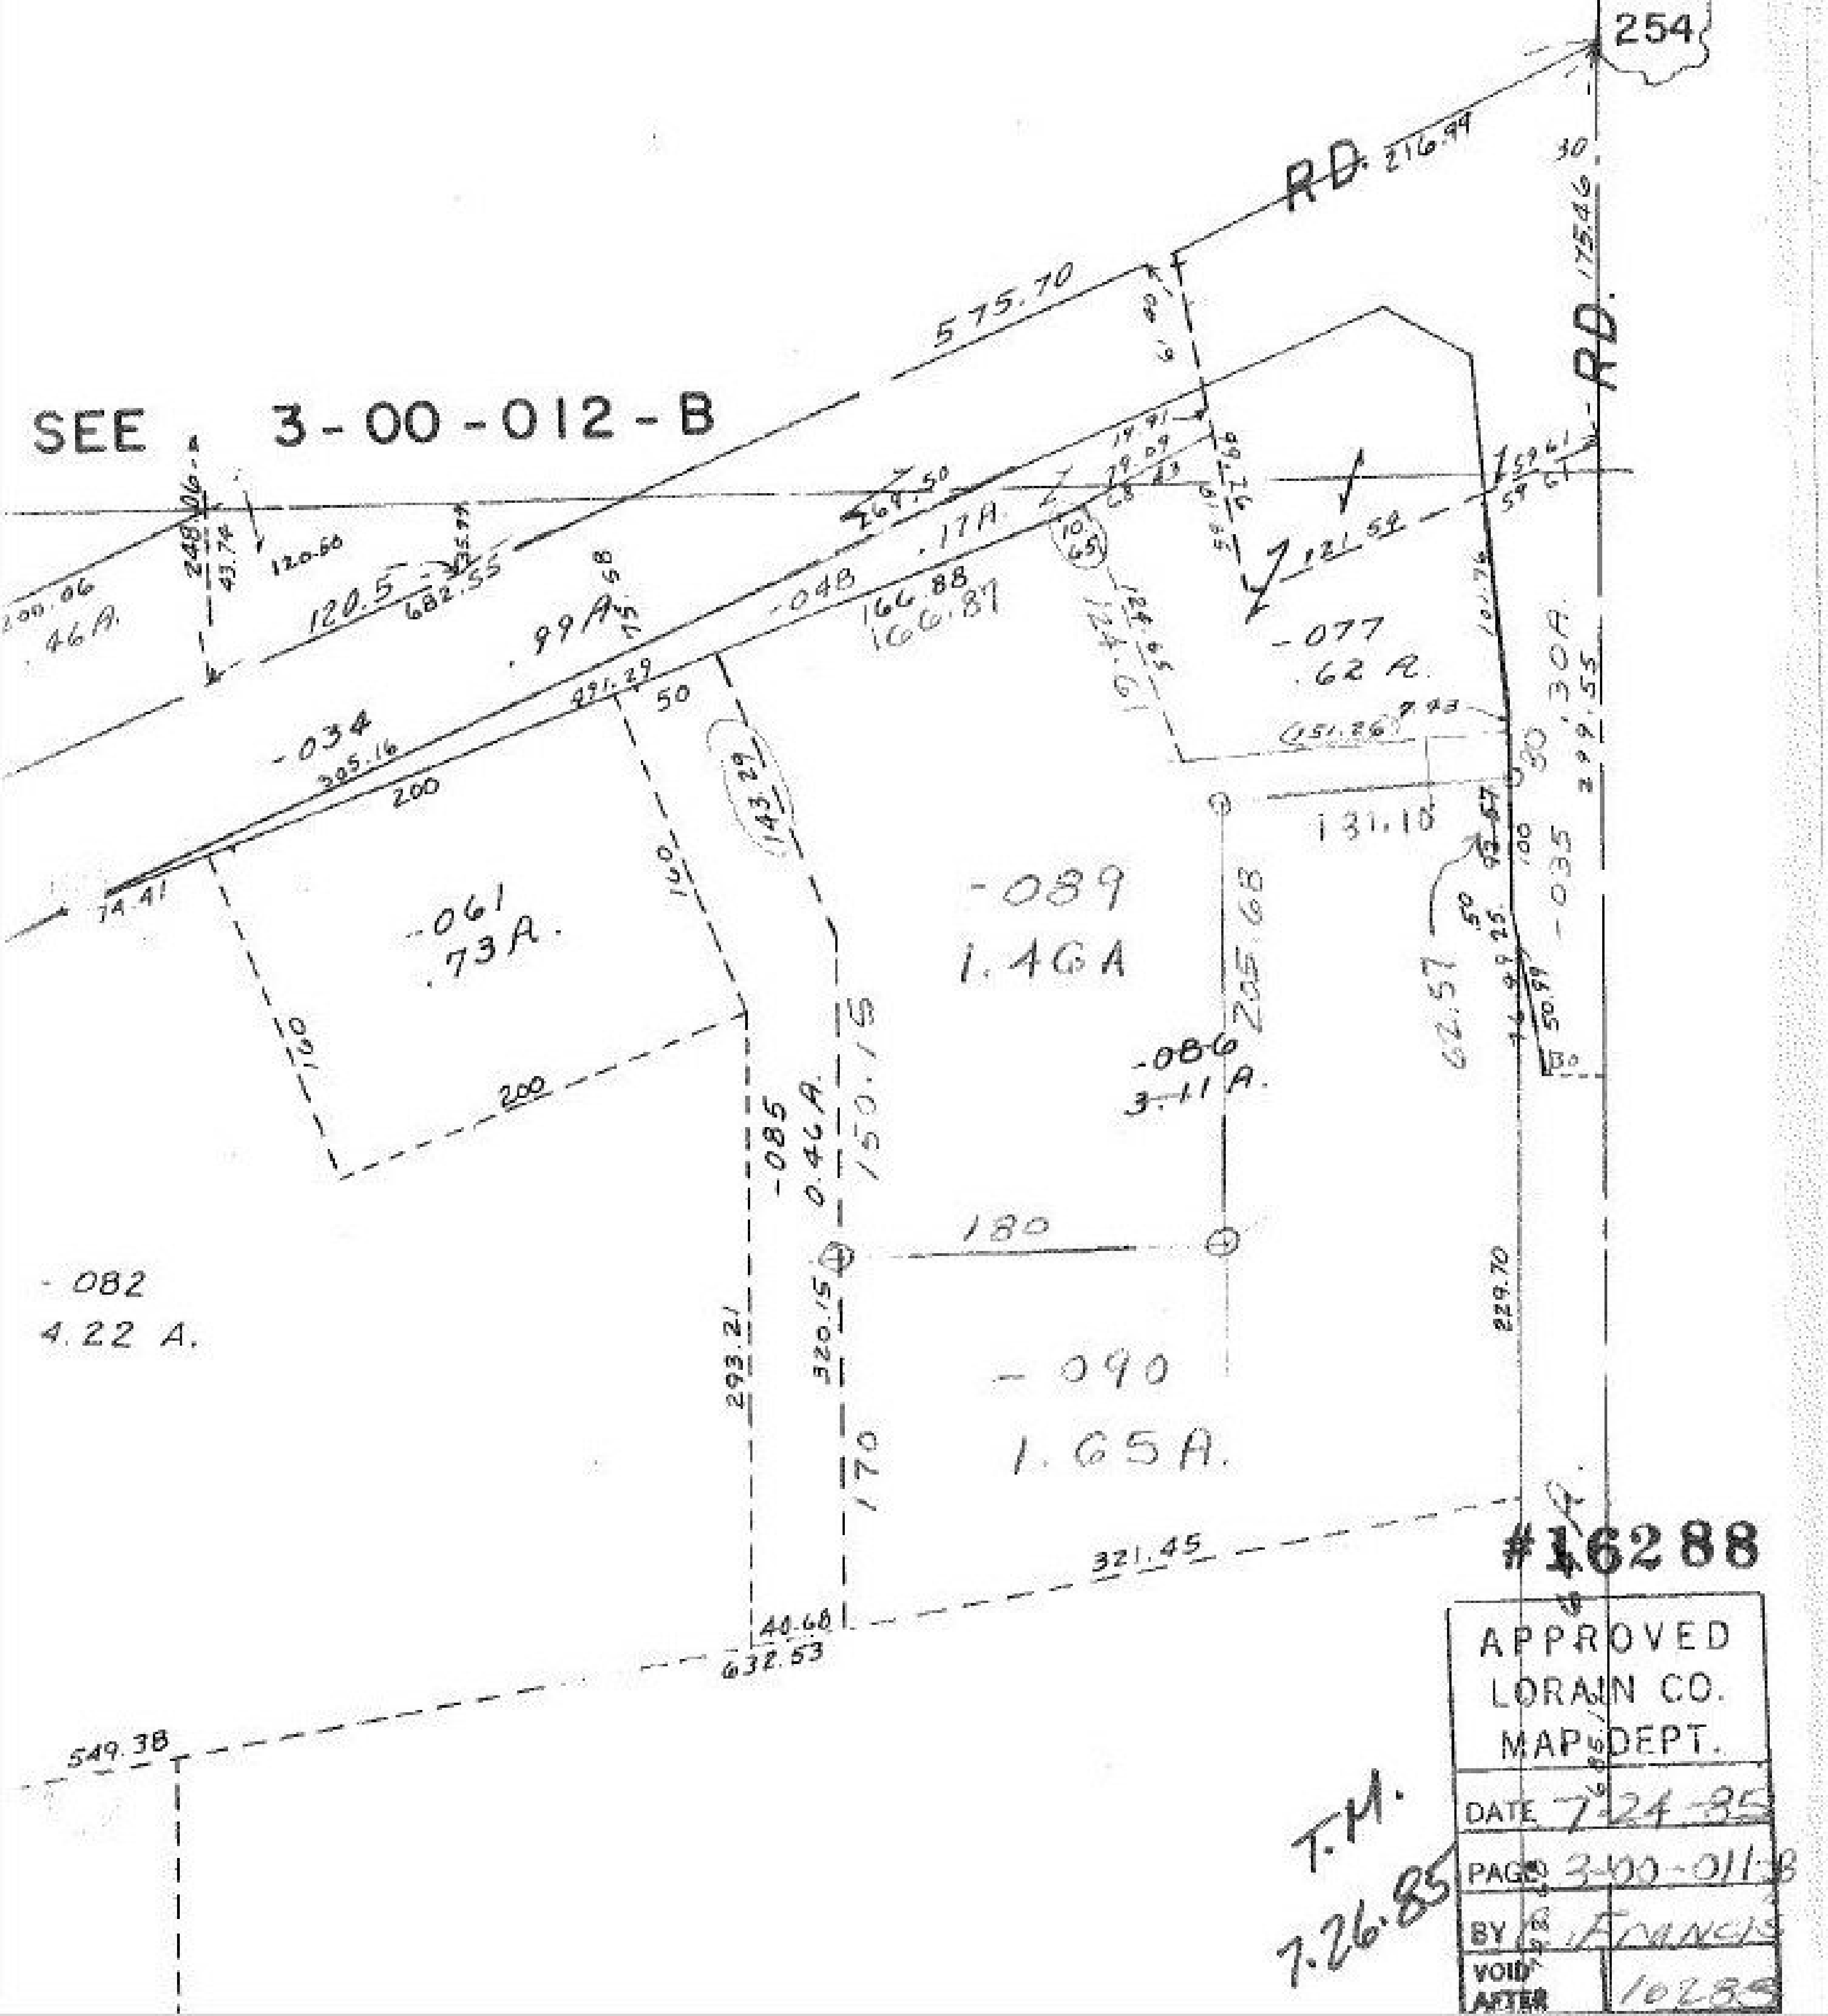
SEE 3-00-012-B
254
RD. 216.99
RD. 175.46
575.70
682.55
120.5
120.60
-034
305.16
200
74.41
-061
.73A.
160
200
.99A.
-048
166.88
166.87
.17A.
-077
.62 A.
131.10
-089
1.46A
205.68
-086
3.11 A.
-085
0.46A.
150.15
180
-090
1.65A.
-035
.30A.
229.70
62.57
50.99
-082
4.22 A.
293.21
320.15
170
321.45
40.68
632.53
549.38
#16288
APPROVED
LORAIN CO.
MAP DEPT.
DATE 7-24-85
PAGE 3-00-011-B
BY E. Francis
VOID AFTER 10/85
T.M.
7.26.85