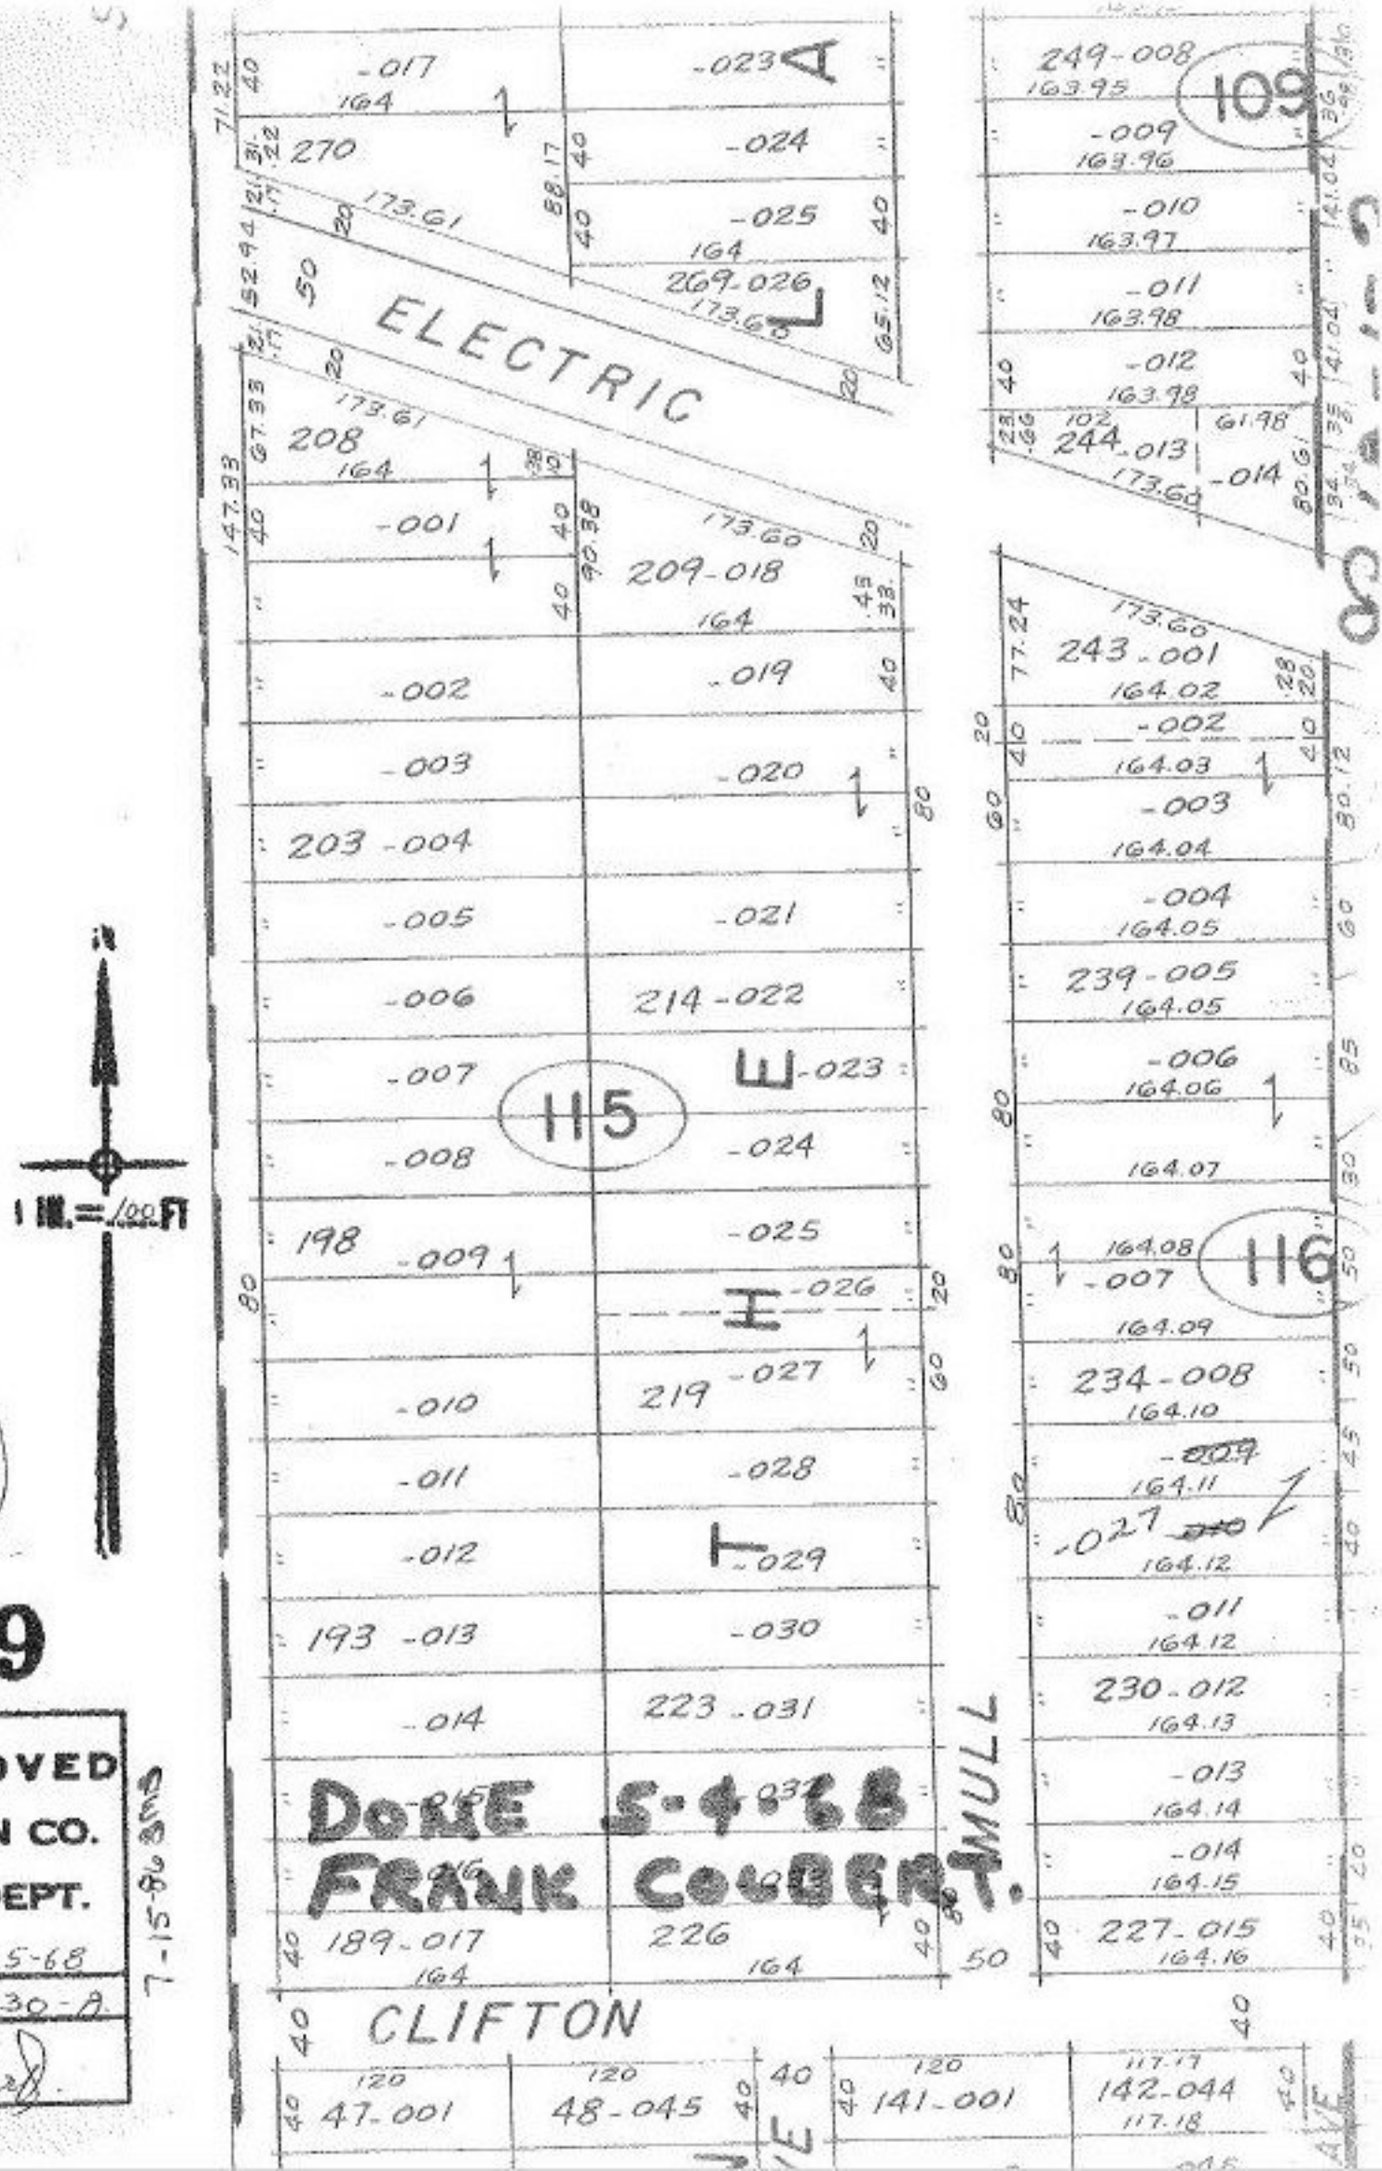

1629

APPROVED
LORAIN CO.
MAP DEPT.
DATE 3-25-68
4-00-030-A
BY [signature]

7-15-86 BMB