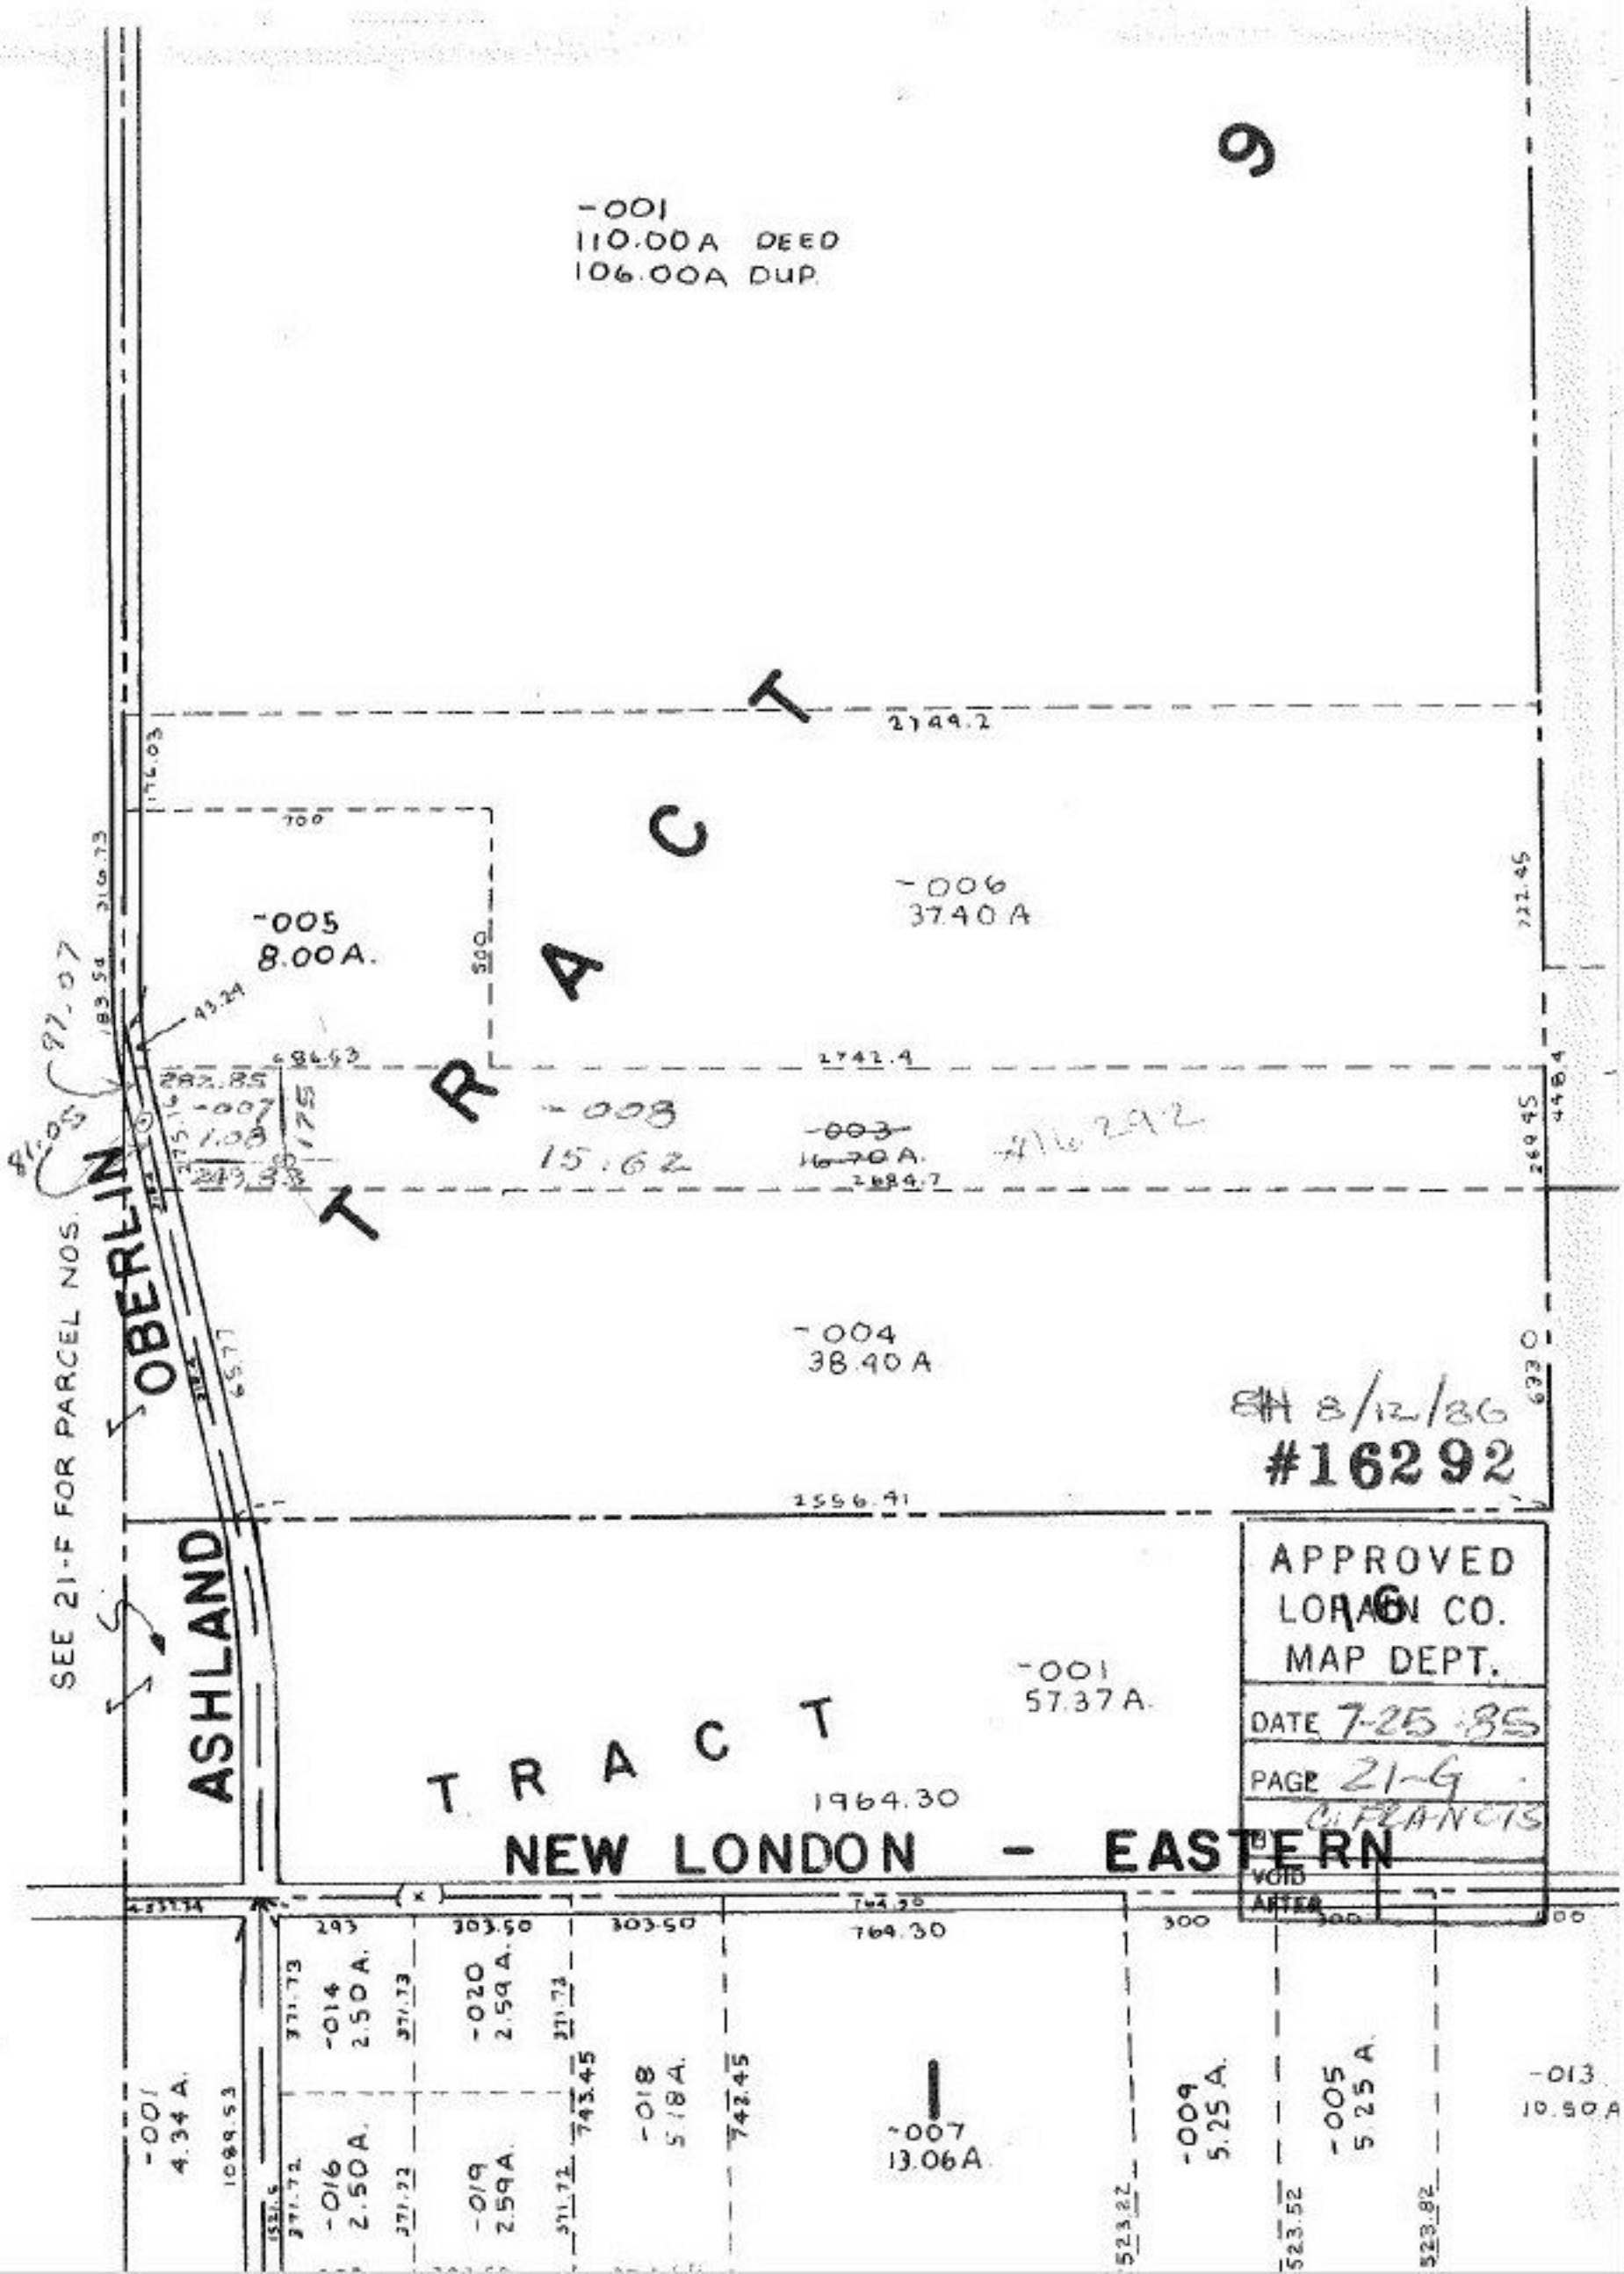
9
-001
110.00A DEED
106.00A DUP.
TRACT
2749.2
-006
37.40 A
-005
8.00A.
-008
15.62
-003
16.70A.
#16292
2742.4
2684.7
-004
38.40 A
2556.41
SEE 21-F FOR PARCEL NOS.
OBERLIN
ASHLAND
-001
57.37 A.
TRACT
1964.30
NEW LONDON - EASTERN
-014
2.50 A.
-020
2.59 A.
-018
5.18 A.
-007
13.06 A
-009
5.25 A.
-005
5.25 A.
-013
10.50 A
-001
4.34 A.
-016
2.50 A.
-019
2.59 A.
1089.53
743.45
742.45
523.22
523.52
523.82
293
303.50
303.50
764.30
300
300
100
97.07
81.05
43.24
282.85
-007
1.08
175
249.33
176.03
700
500
722.45
269.45
448.4
633.0
65.77
8H 8/12/86
#16292
APPROVED
LORAIN CO.
MAP DEPT.
DATE 7-25-85
PAGE 21-G
C. FRANCIS
VOID
AFTER