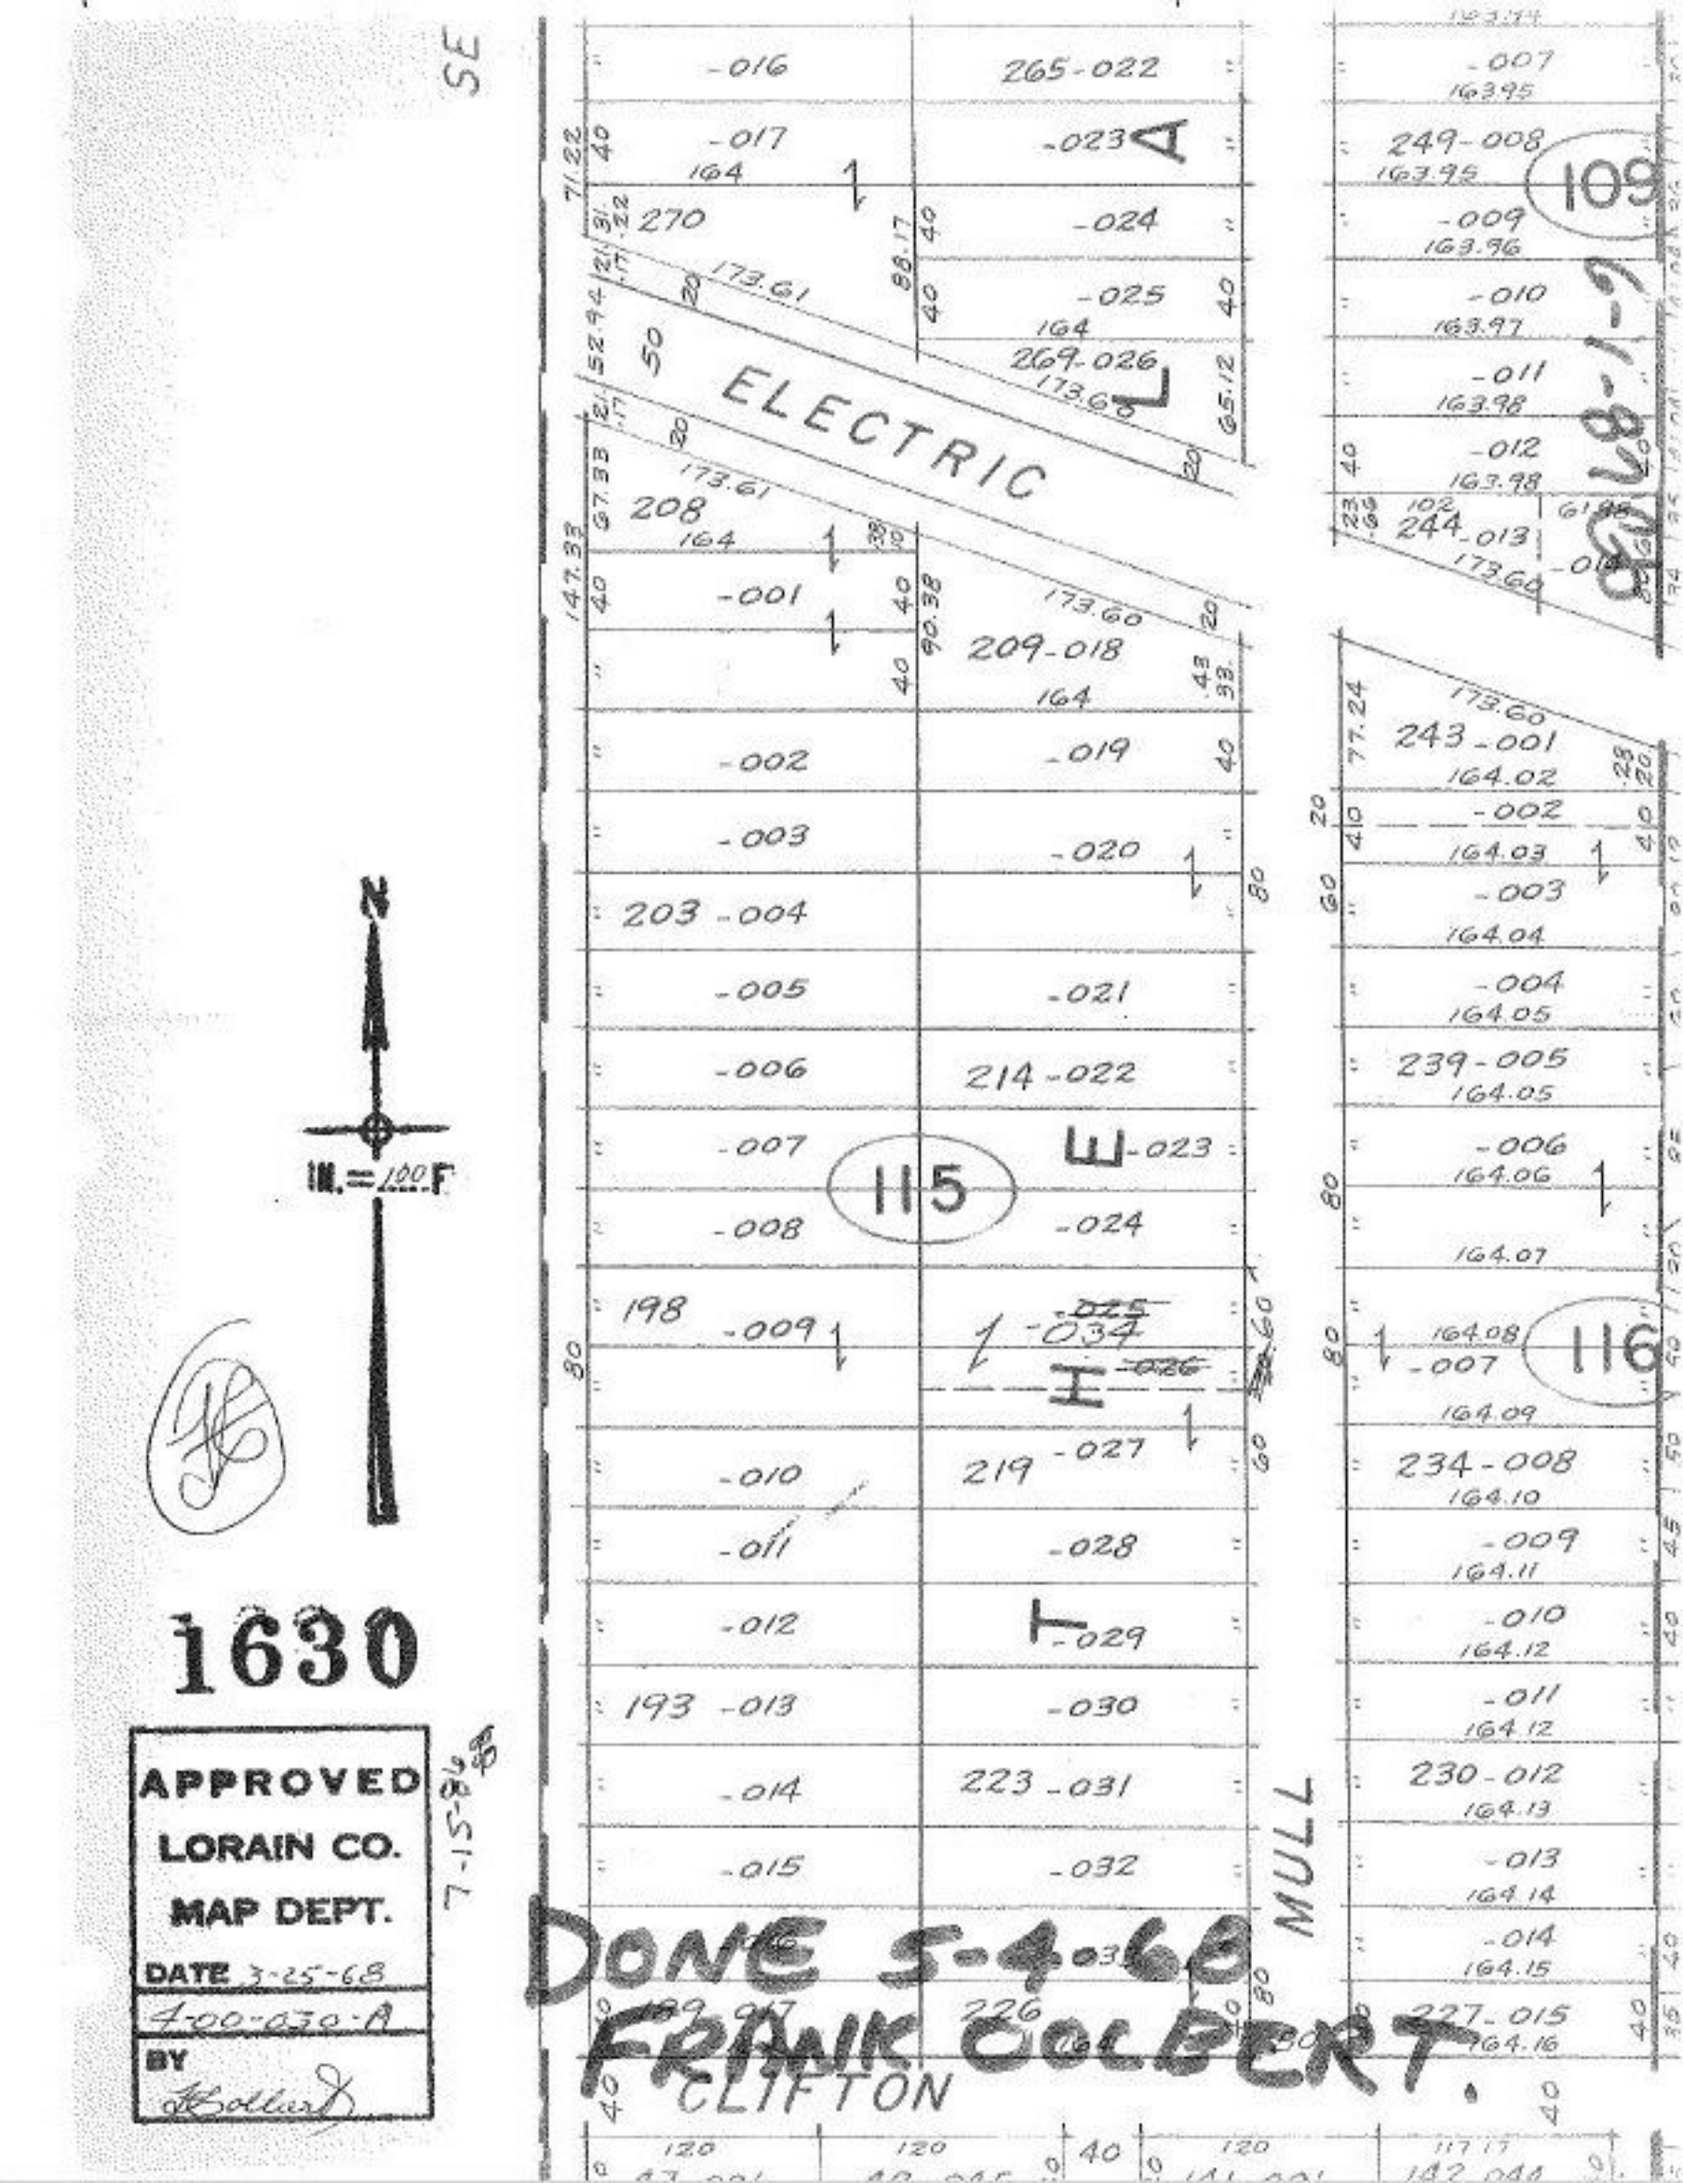
SE
-016
265-022
-017
164
-023
A
270
-024
-025
164
269-026
173.61
ELECTRIC
208
164
-001
209-018
164
-002
-019
-003
-020
203-004
-005
-021
-006
214-022
-007
115
W-023
-008
-024
198
-009
-034
-026
-010
219-027
-011
-028
-012
-029
193-013
-030
-014
223-031
-015
-032
226
CLIFTON
MULL
249-008
163.95
109
-009
163.96
-010
163.97
-011
163.98
-012
163.98
244-013
173.64
243-001
164.02
-002
164.03
-003
164.04
-004
164.05
239-005
164.05
-006
164.06
164.07
164.08
116
-007
164.09
234-008
164.10
-009
164.11
-010
164.12
-011
164.12
230-012
164.13
-013
164.14
-014
164.15
227-015
164.16
N
1in.=100F
1630
APPROVED
LORAIN CO.
MAP DEPT.
DATE 3-25-68
4-00-030-A
BY
7-15-68
DONE 5-4-68
FRANK COLBERT