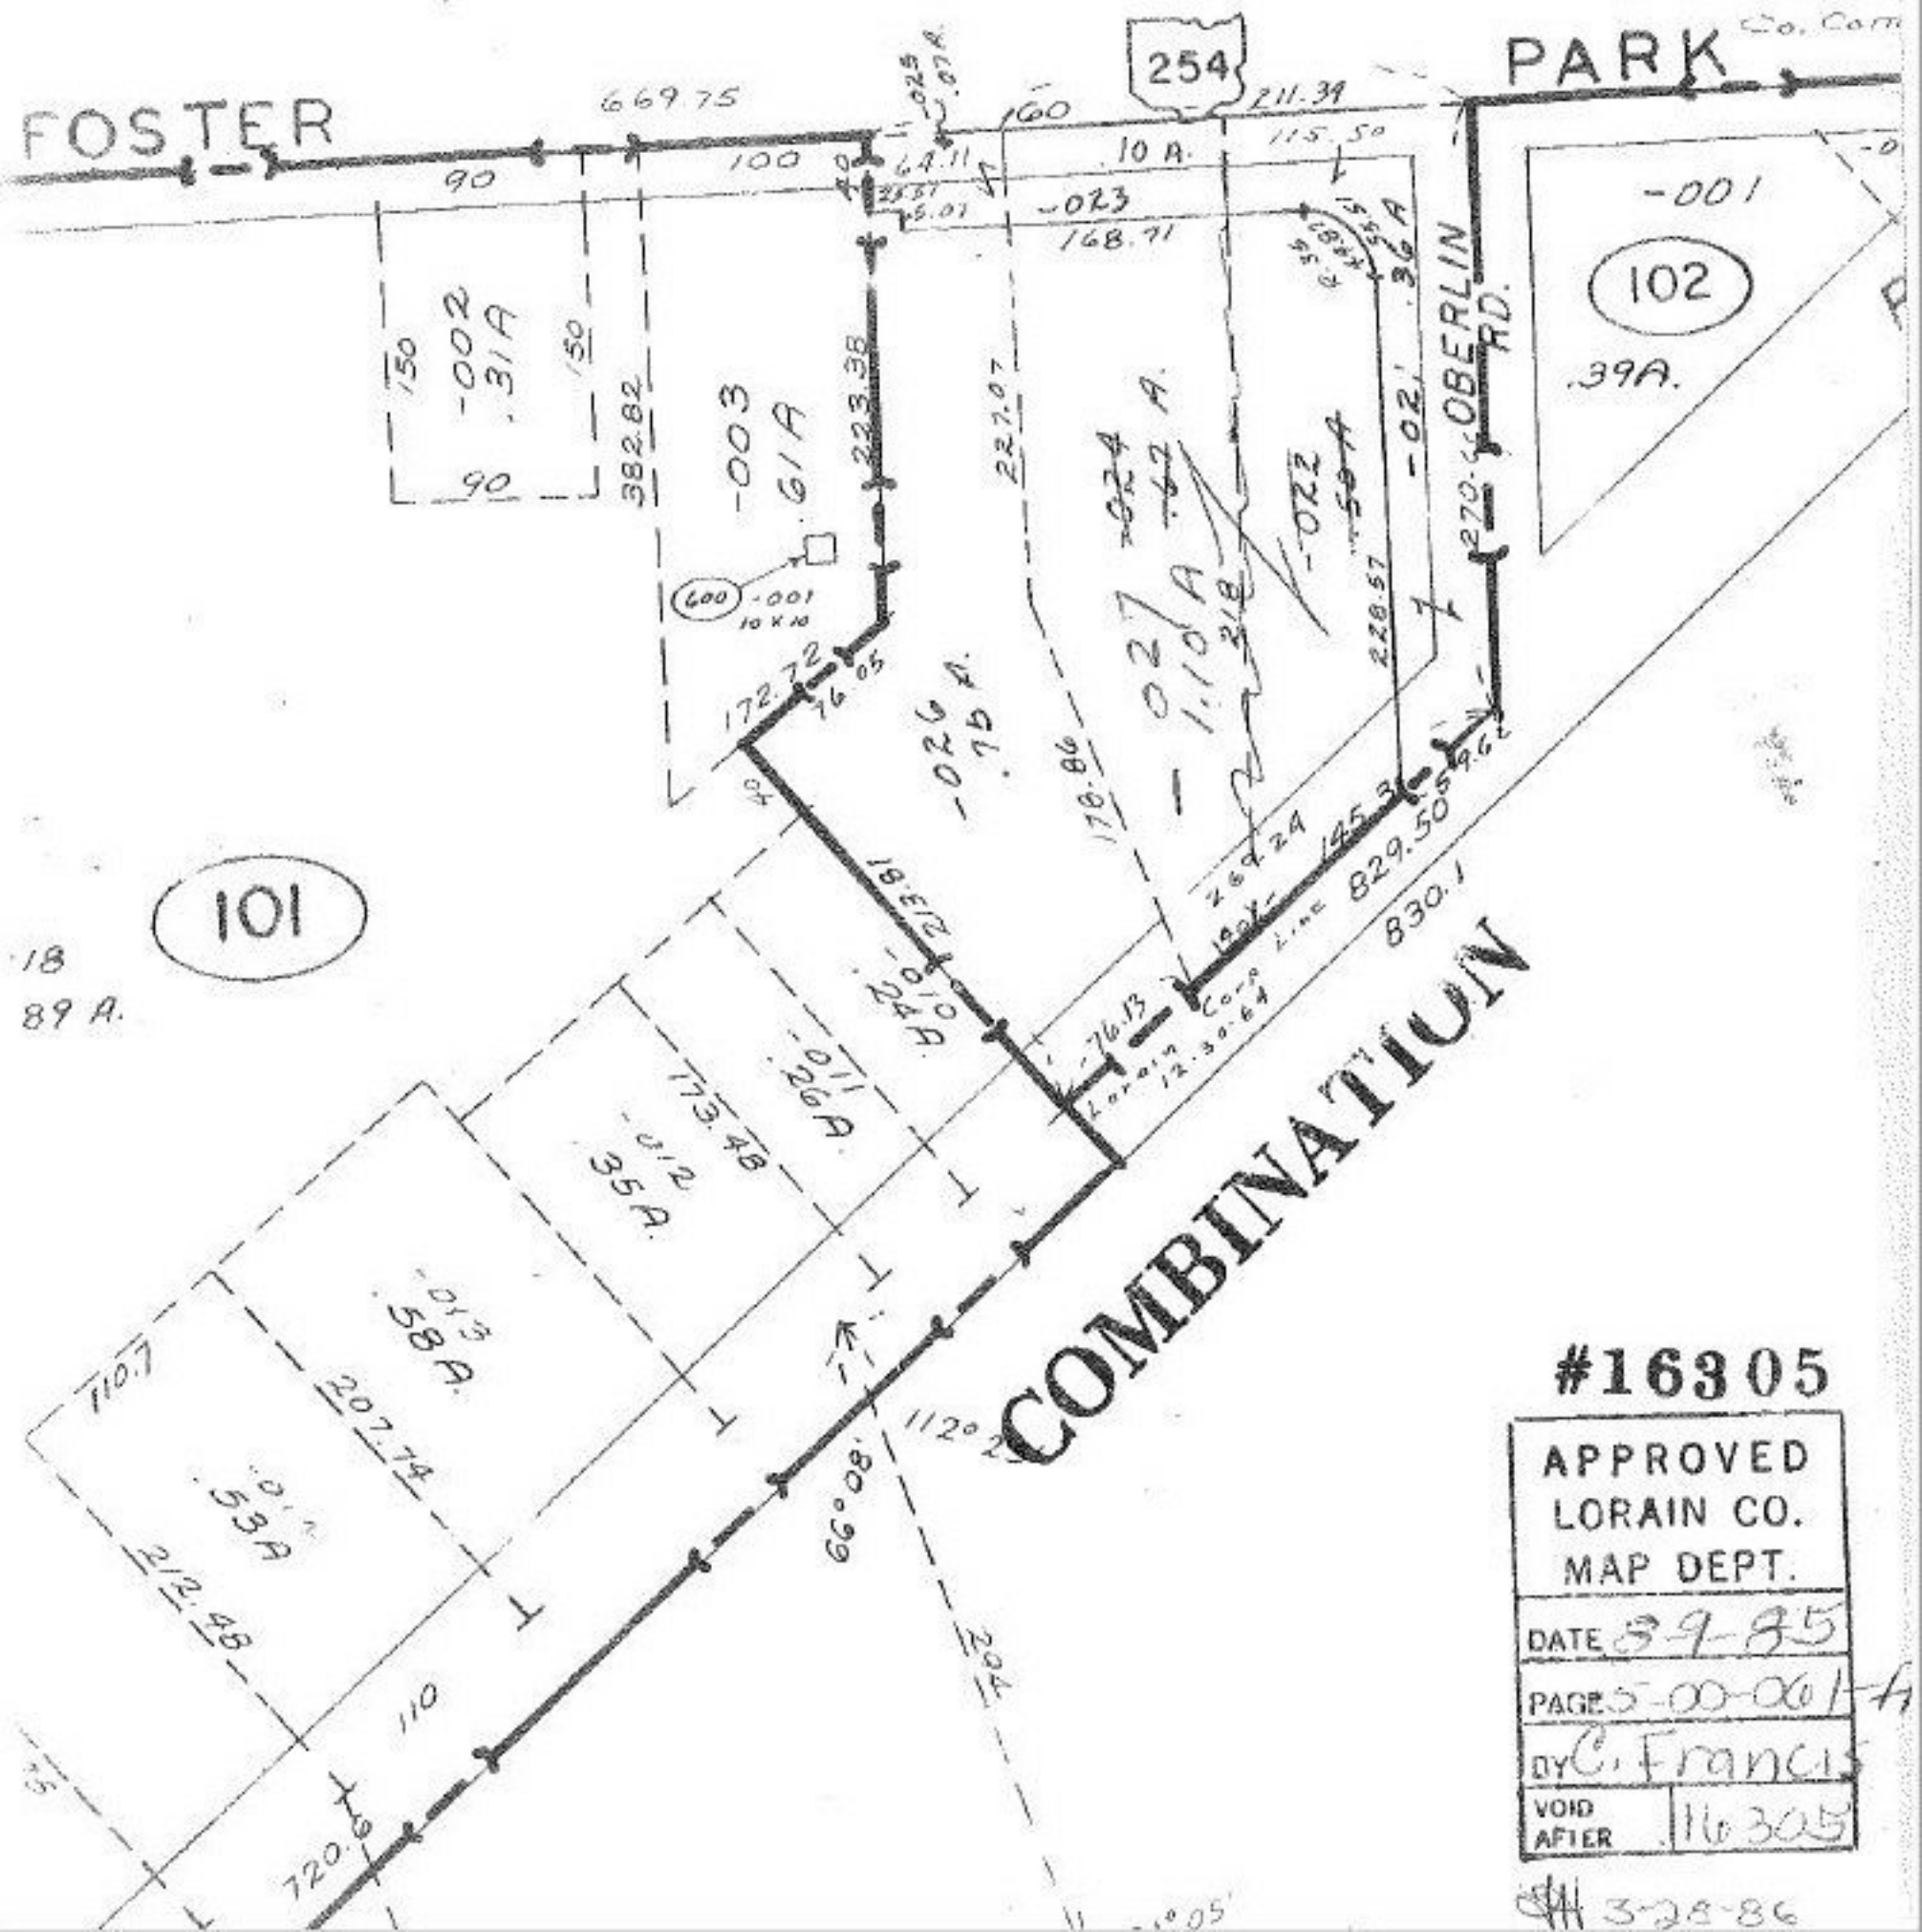

#16305

APPROVED
LORAIN CO.
MAP DEPT.

DATE 8-9-85

PAGE 5-00-061-A

BY C. Francis

VOID AFTER 16305

3-28-86