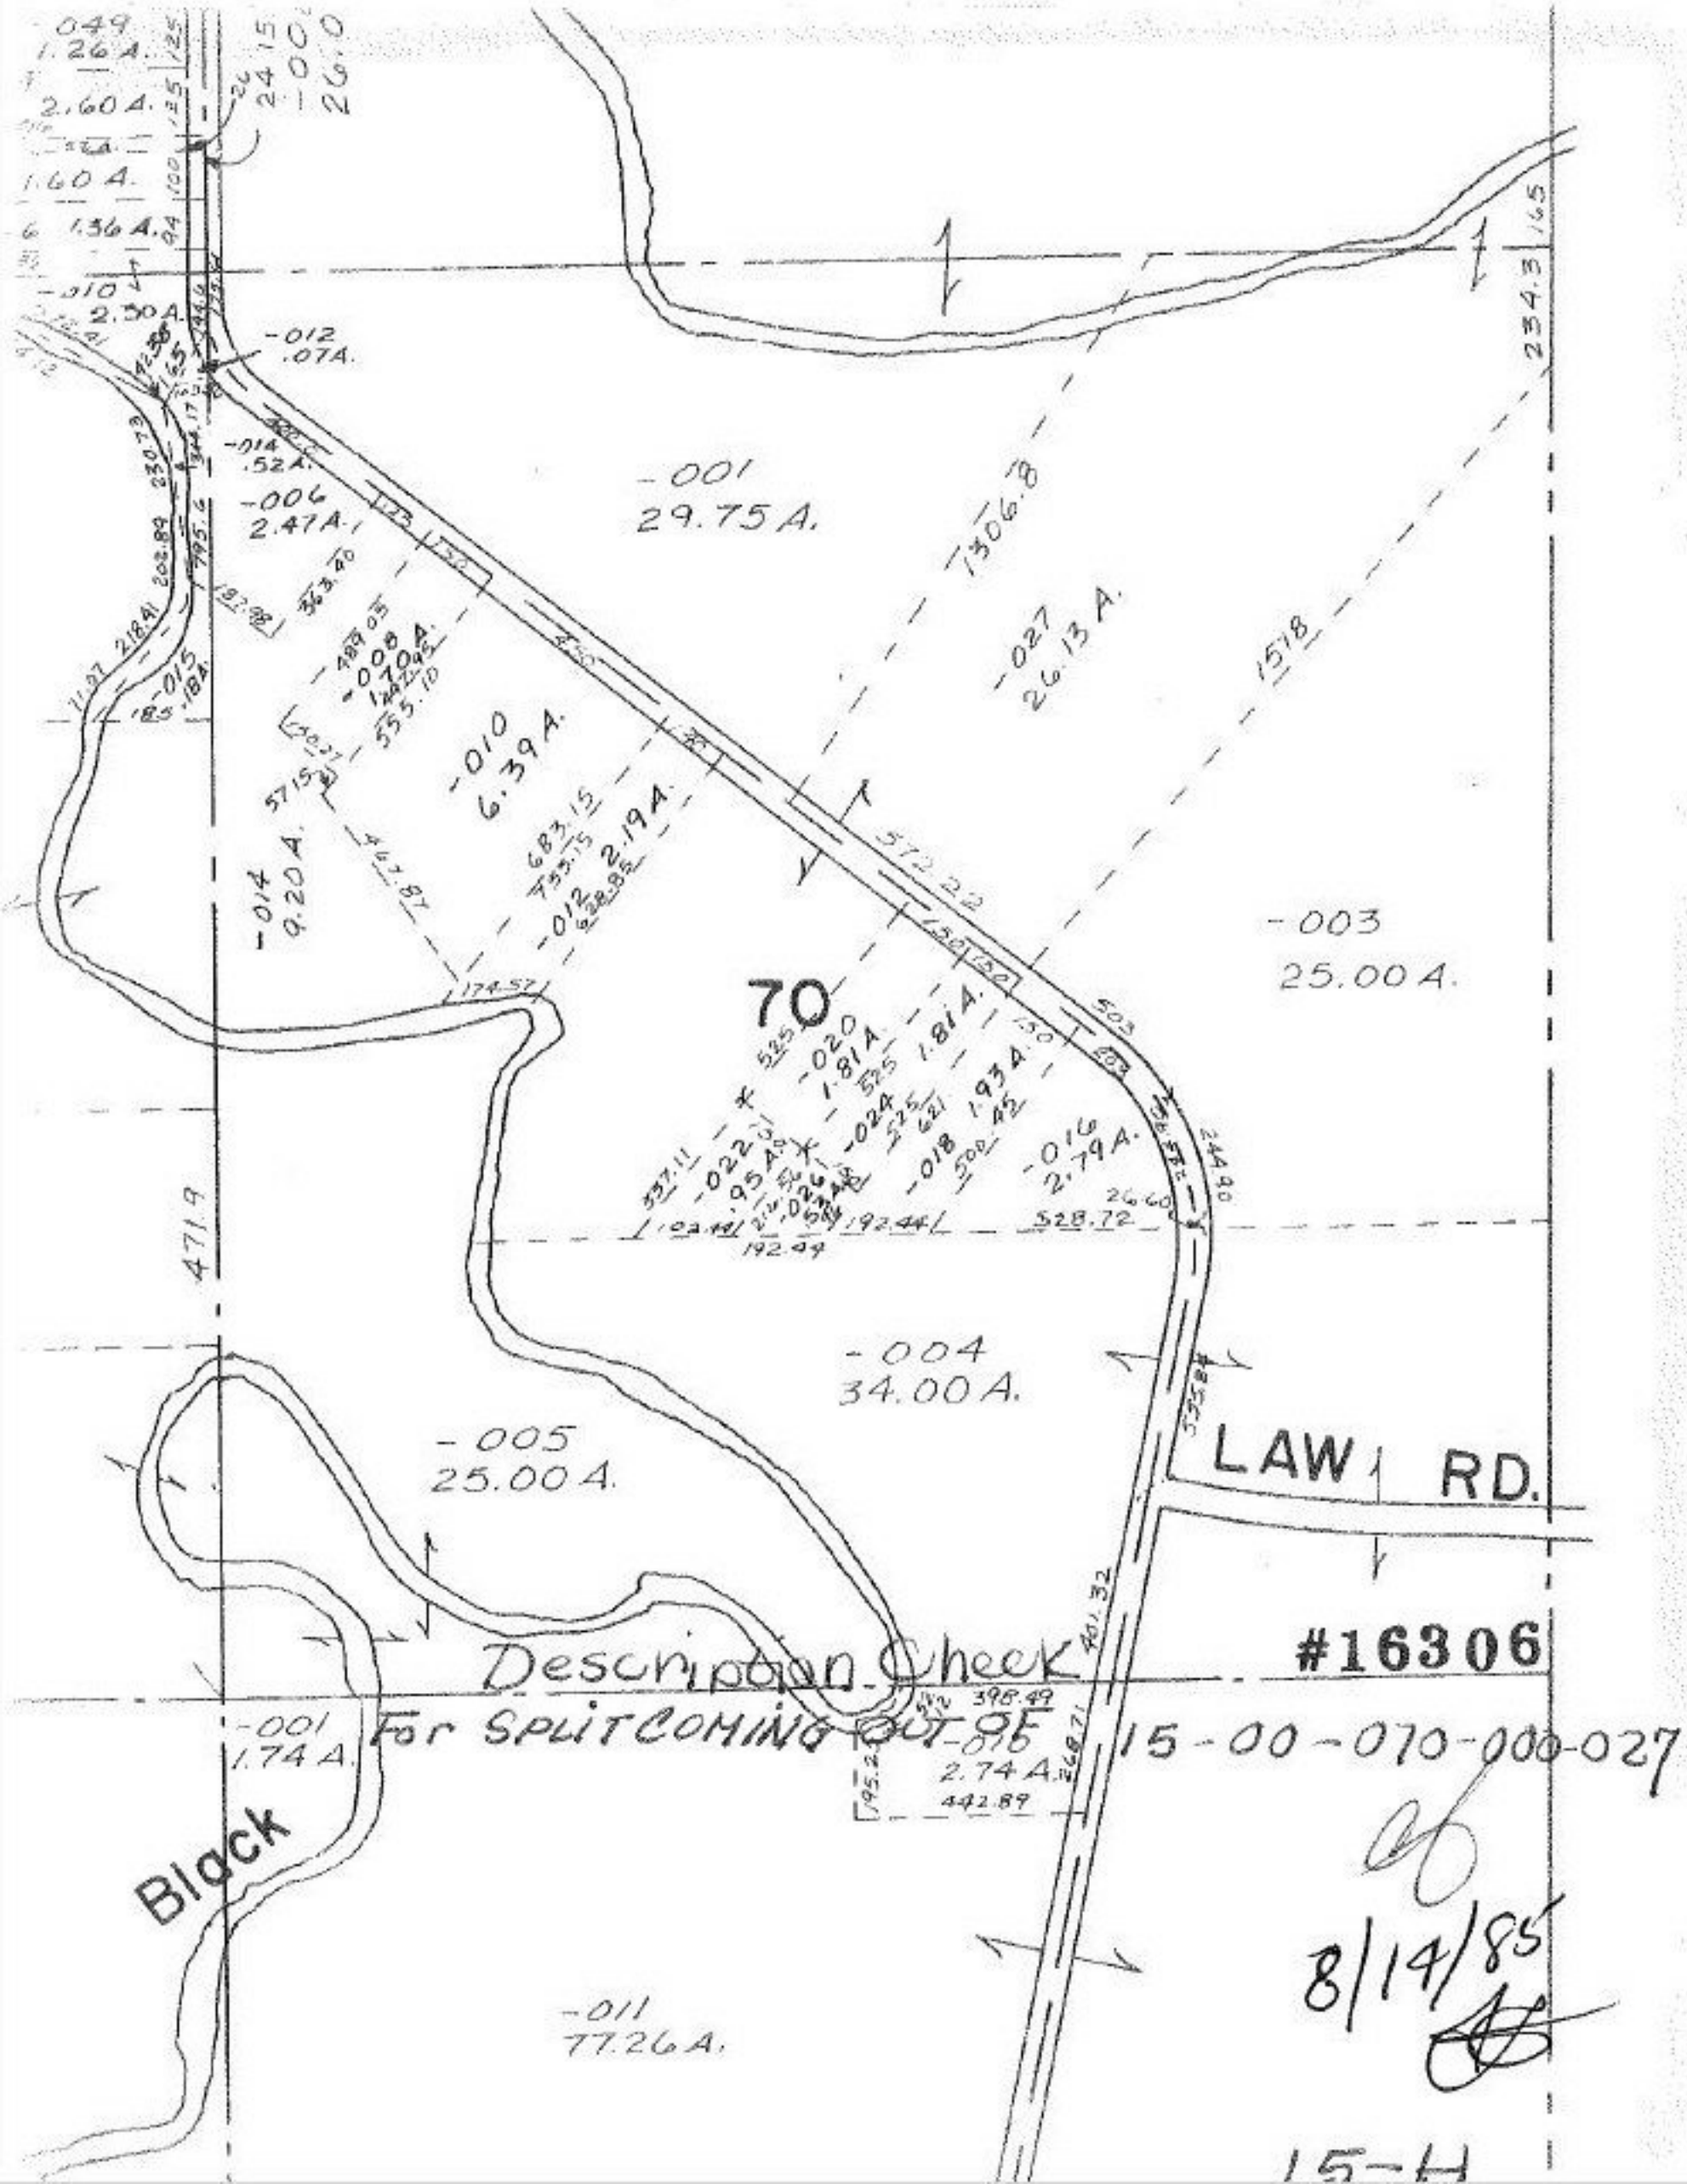

Description Check
For SPLIT COMING OUT OF 15-00-070-000-027

#16306

8/14/85

15-H